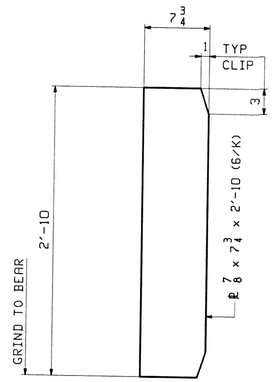

46 - x2a
BRG. STIFF

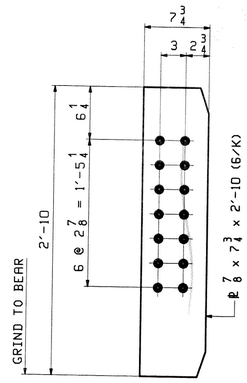

4 - x2b
BRG. STIFF

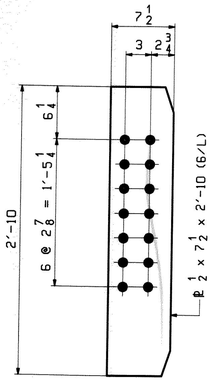

36 - x2c

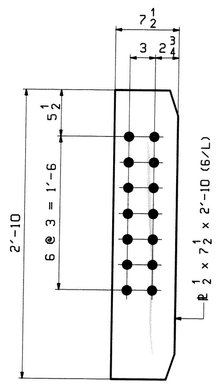

128 - x2d

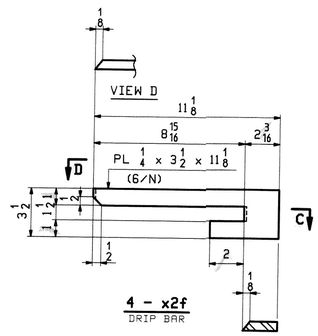

4 - x2f
DRIP BAR

SECTION C

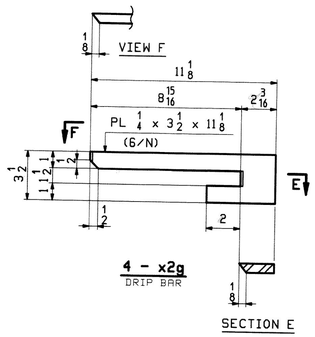

4 - x2g
DRIP BAR

SECTION E

NOTES:
FOR GENERAL NOTES SEE DRAWING GN1.

REV.	DATE	REMARKS	DWN	CHK	APVL	SHOP
0					JAN 2 9 2010	

MATERIAL:	SURFACE PREP. & PAINT:	HOLES:	SHOP BOLTS:
M270-50W	SEE GN1	15/16"Ø	NONE

DESCRIPTION: GIRDER STANDARDS

CASCO BAY STEEL STRUCTURES, INC.
75 SPRING HILL ROAD SACO, MAINE 04072
PHONE (207) 282-7360 FAX. (207) 282-1179
TENSOR 2945

STRUCTURE: U.S. 5 over I-91 Bridge No. 19A Putney County of Windham	DRAWN: WJF	DATE: 01/07	
	CHKD: DO	DATE: 01/12	
LOCATION: Putney	JOB NO.	DWG NO.	
PROJ NO. IM 091-1(31)	438	X2	
CUSTOMER: VT AOT		REV. △	

2/9/10