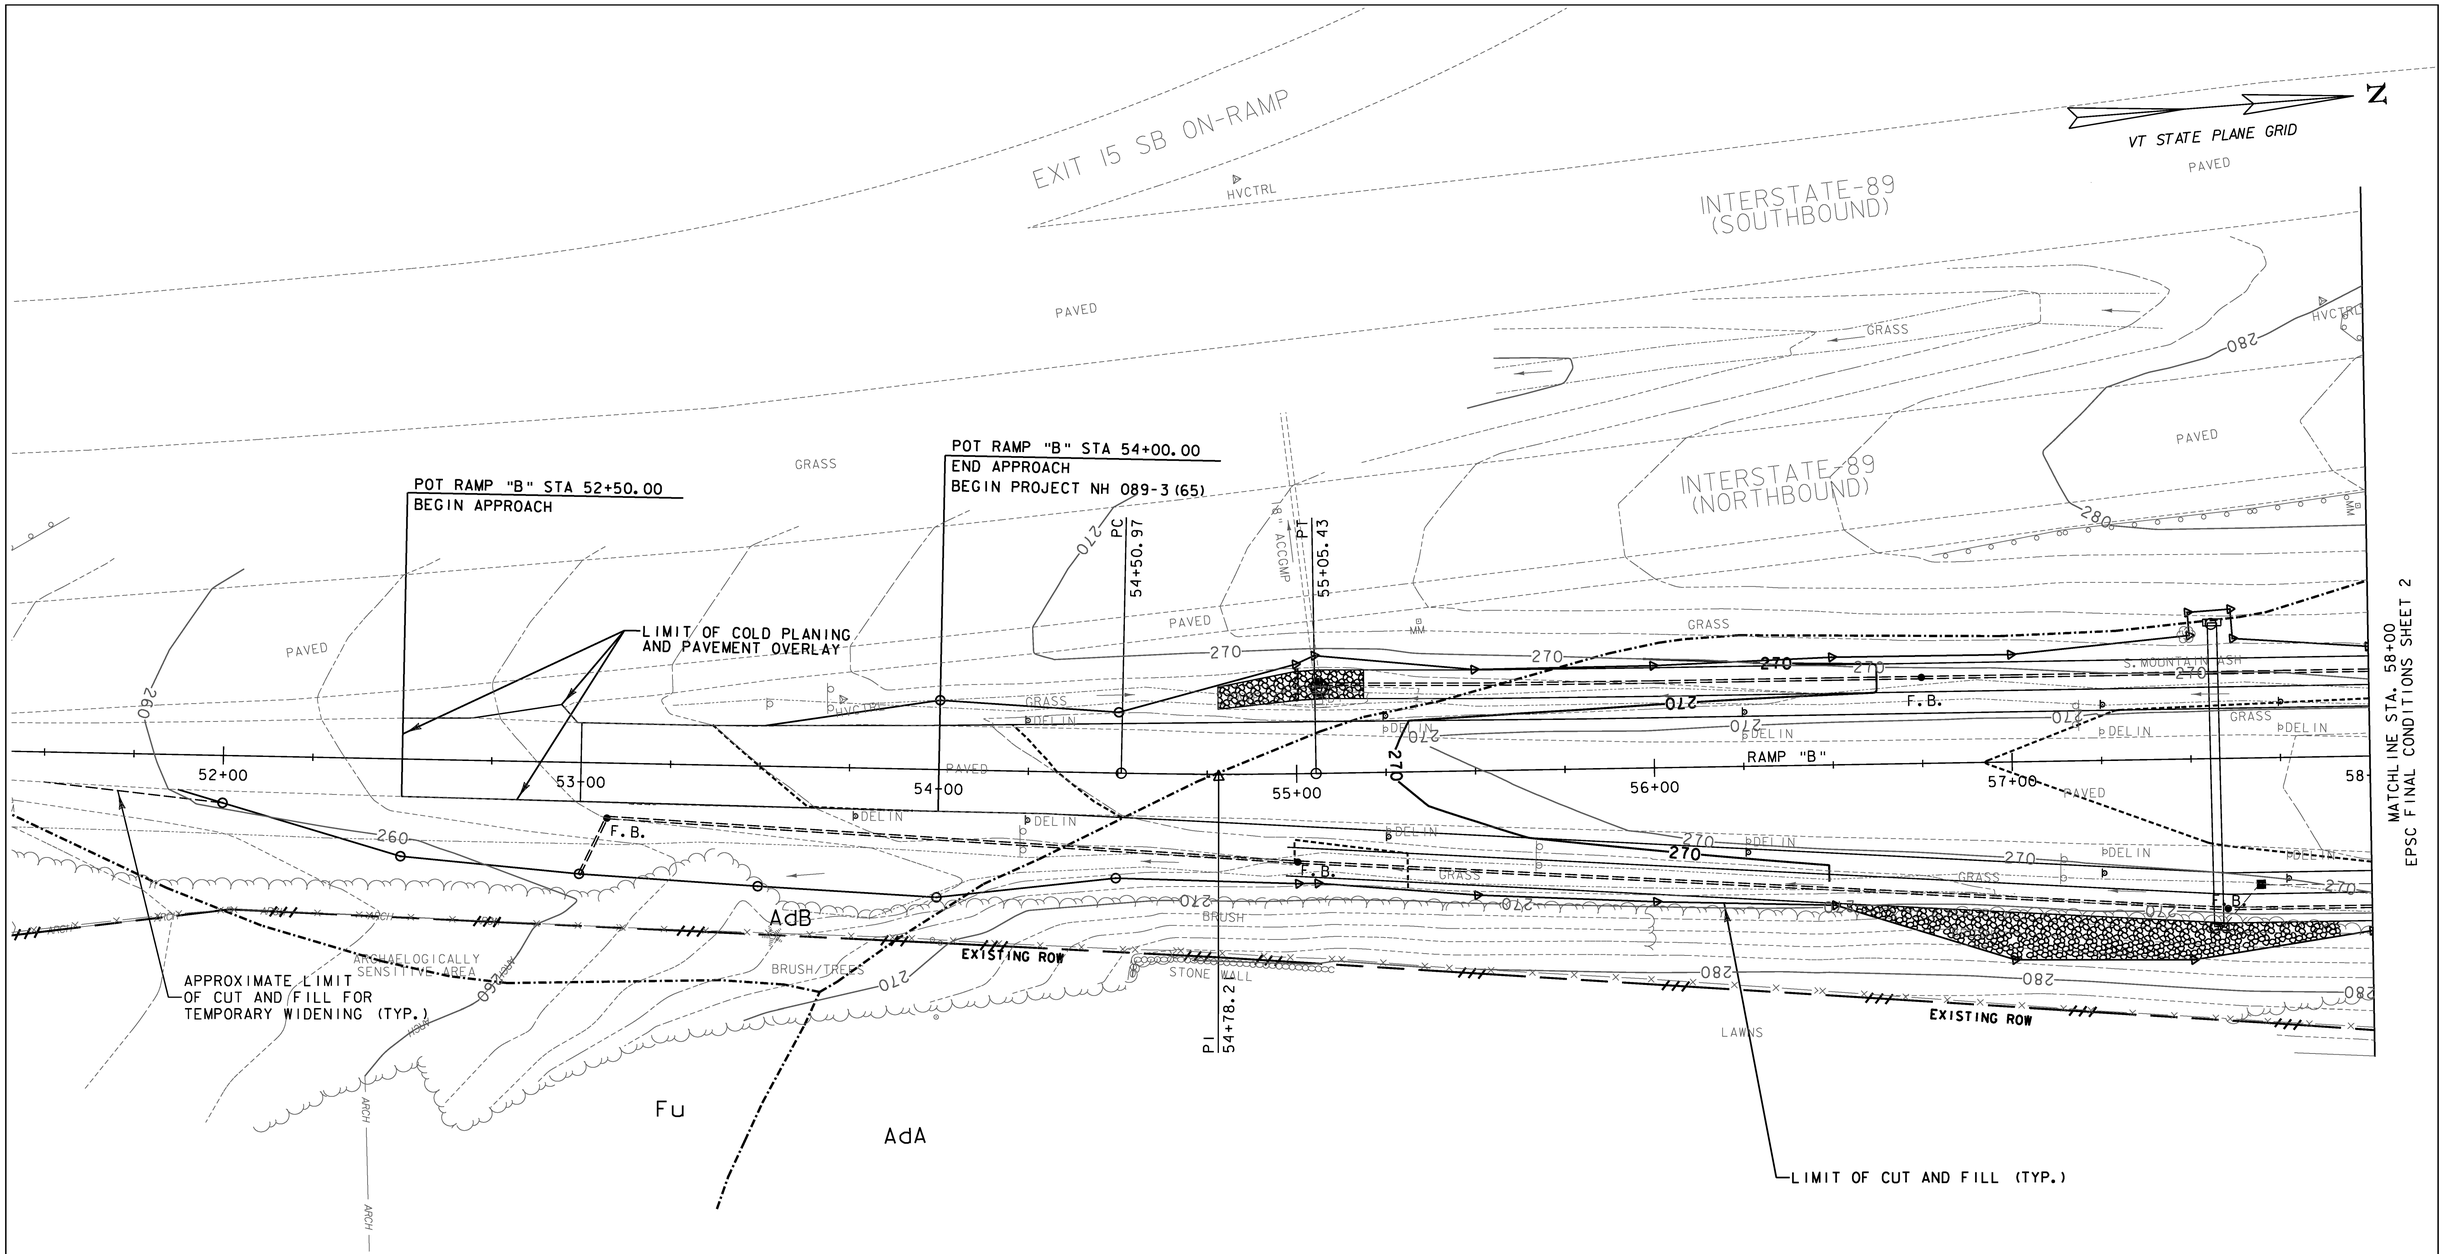

NOTE:
SEE CROSS SECTIONS FOR ADDITIONAL GRADING.

0 20 40
SCALE IN FEET

PROJECT NAME: WINOOSKI	
PROJECT NUMBER: NH 089-3(65)	
FILE NAME: z94a198ecfcbdr.dgn	PLOT DATE: 2/24/2010
PROJECT LEADER: KEN UPMAL	DRAWN BY: A. ACHARYA
DESIGNED BY: A. ACHARYA	CHECKED BY: E.ATKINS
ESPC FINAL CONDITIONS PLAN SHEET 1	SHEET 36 OF 67