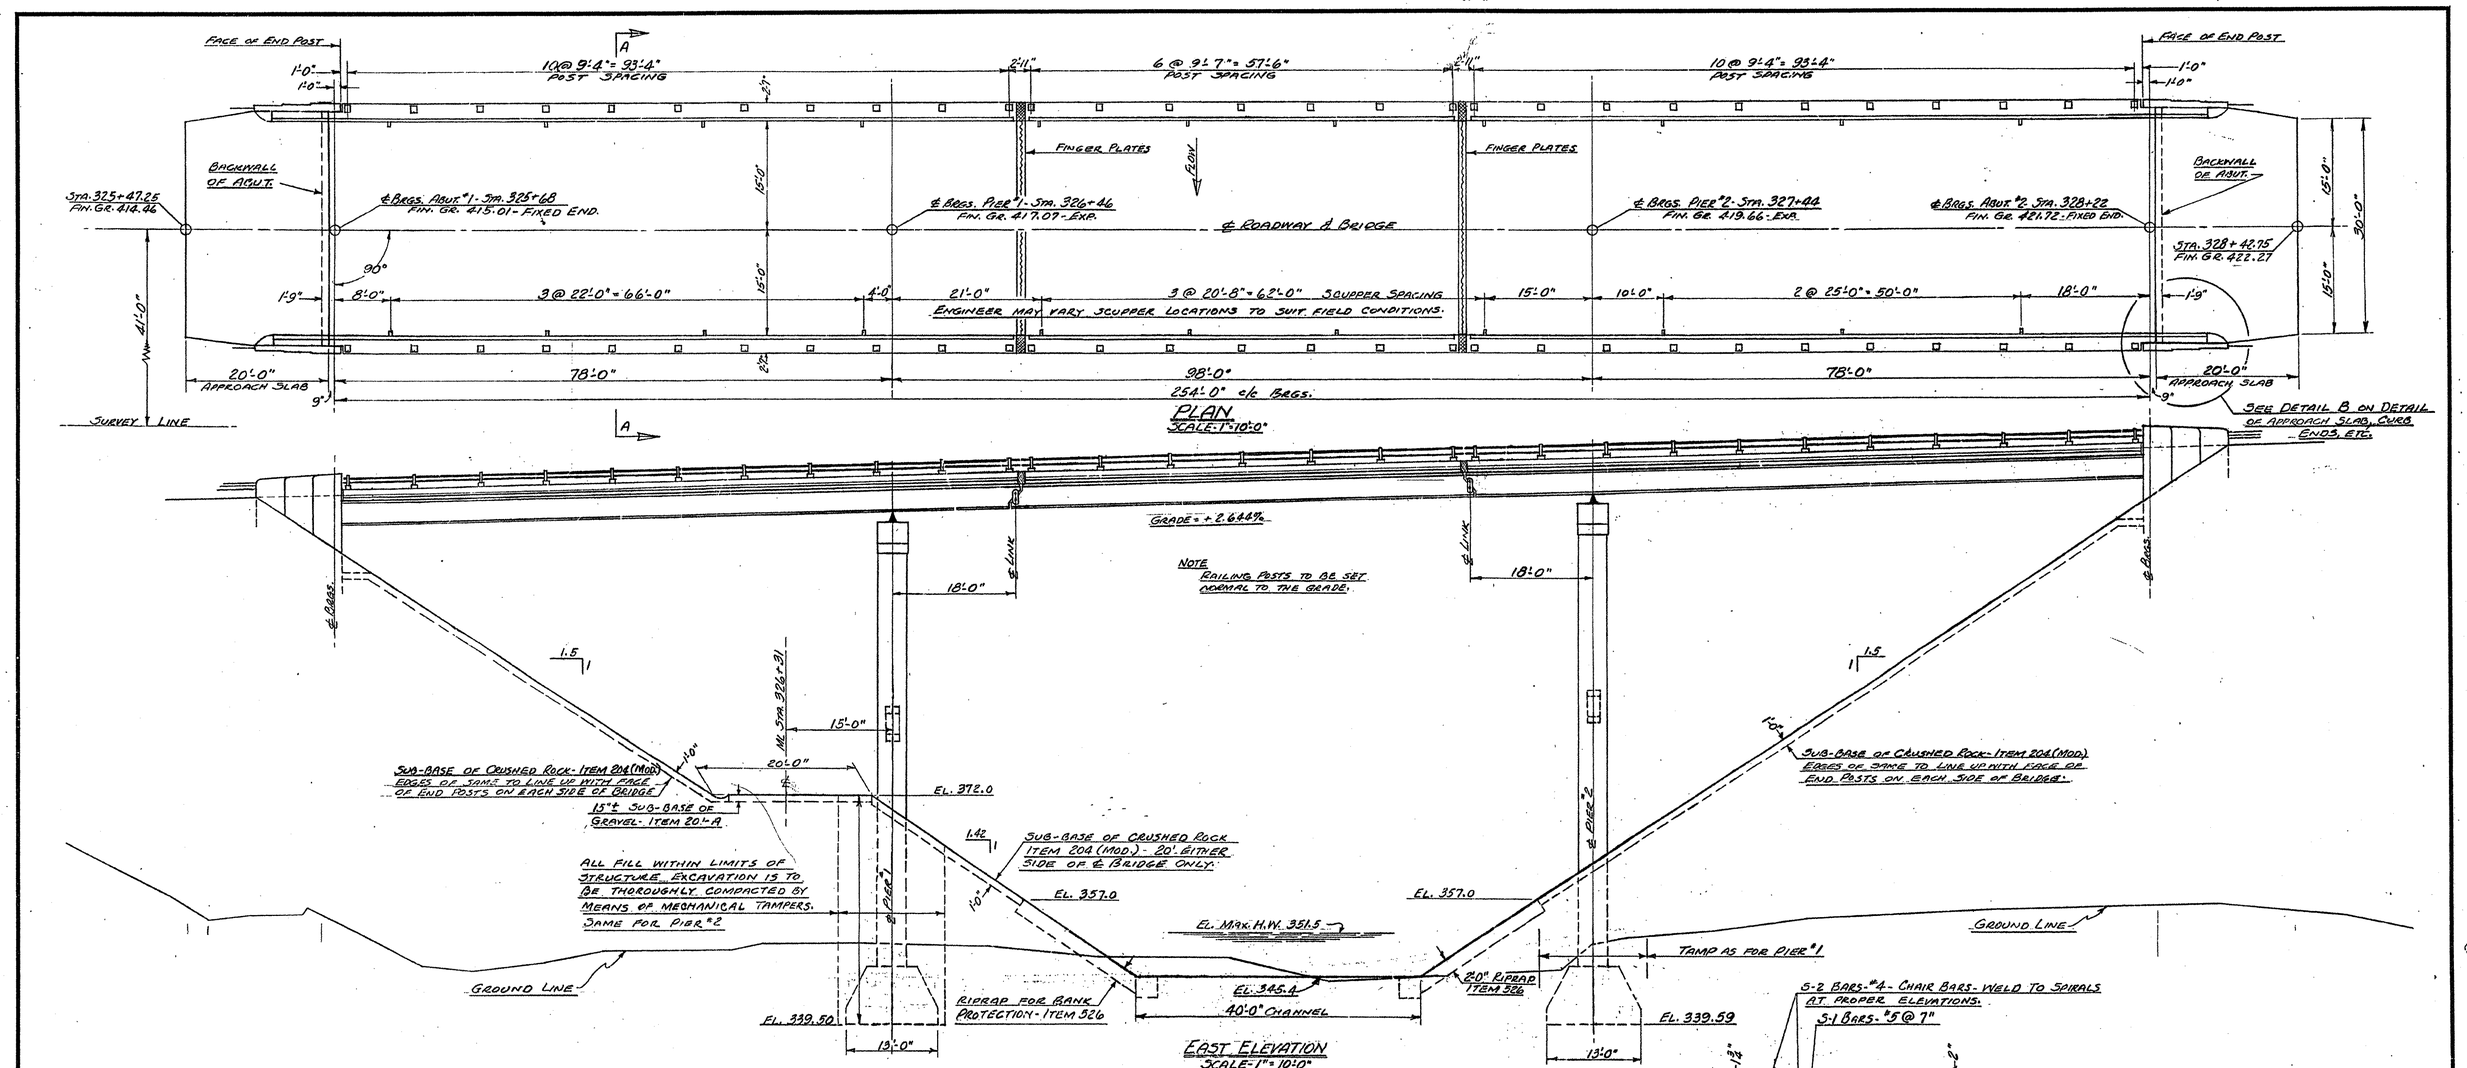

CAUTION: REPRODUCTION IS NOT TO SCALE

IM 091-1(33)
This sheet for information only.
BR 3 N&S
Sheet 101 of 114

- ESTIMATED QUANTITIES - (ONE BRIDGE ONLY)

ITEM No.	DESCRIPTION	NET	OVER	TOTAL	FINAL
361-B	BITUMINOUS CONC. PAVEMENT	95	14	109	95
401-B	CONCRETE - CLASS B	255	13	268	257
402	REINFORCING STEEL (SEE REINF. STL. DETS.)				
403	SPIRAL REINFORCEMENT	1		1	1
556G	GRANITE BRIDGE CURB (TYPE I)	552		552	552
572	BRIDGE RAILING (ALUMINUM)	503		503	503

STATE OF VERMONT
DEPARTMENT OF HIGHWAYS

TOWN OF BRATTLEBORO - GUILFORD
ROUTE No. INTERSTATE LOG. STA.
SUPERSTRUCTURE
PLAN, ELEVATION & SECTION
SCALE A.S. NOTED
SURVEYED BY POGAR
DRAWN BY R.T.A. 9/76 CHECKED BY H.E.S. 7/76
PROJECT No. I-001-1(6)
SHEET 101 OF 114