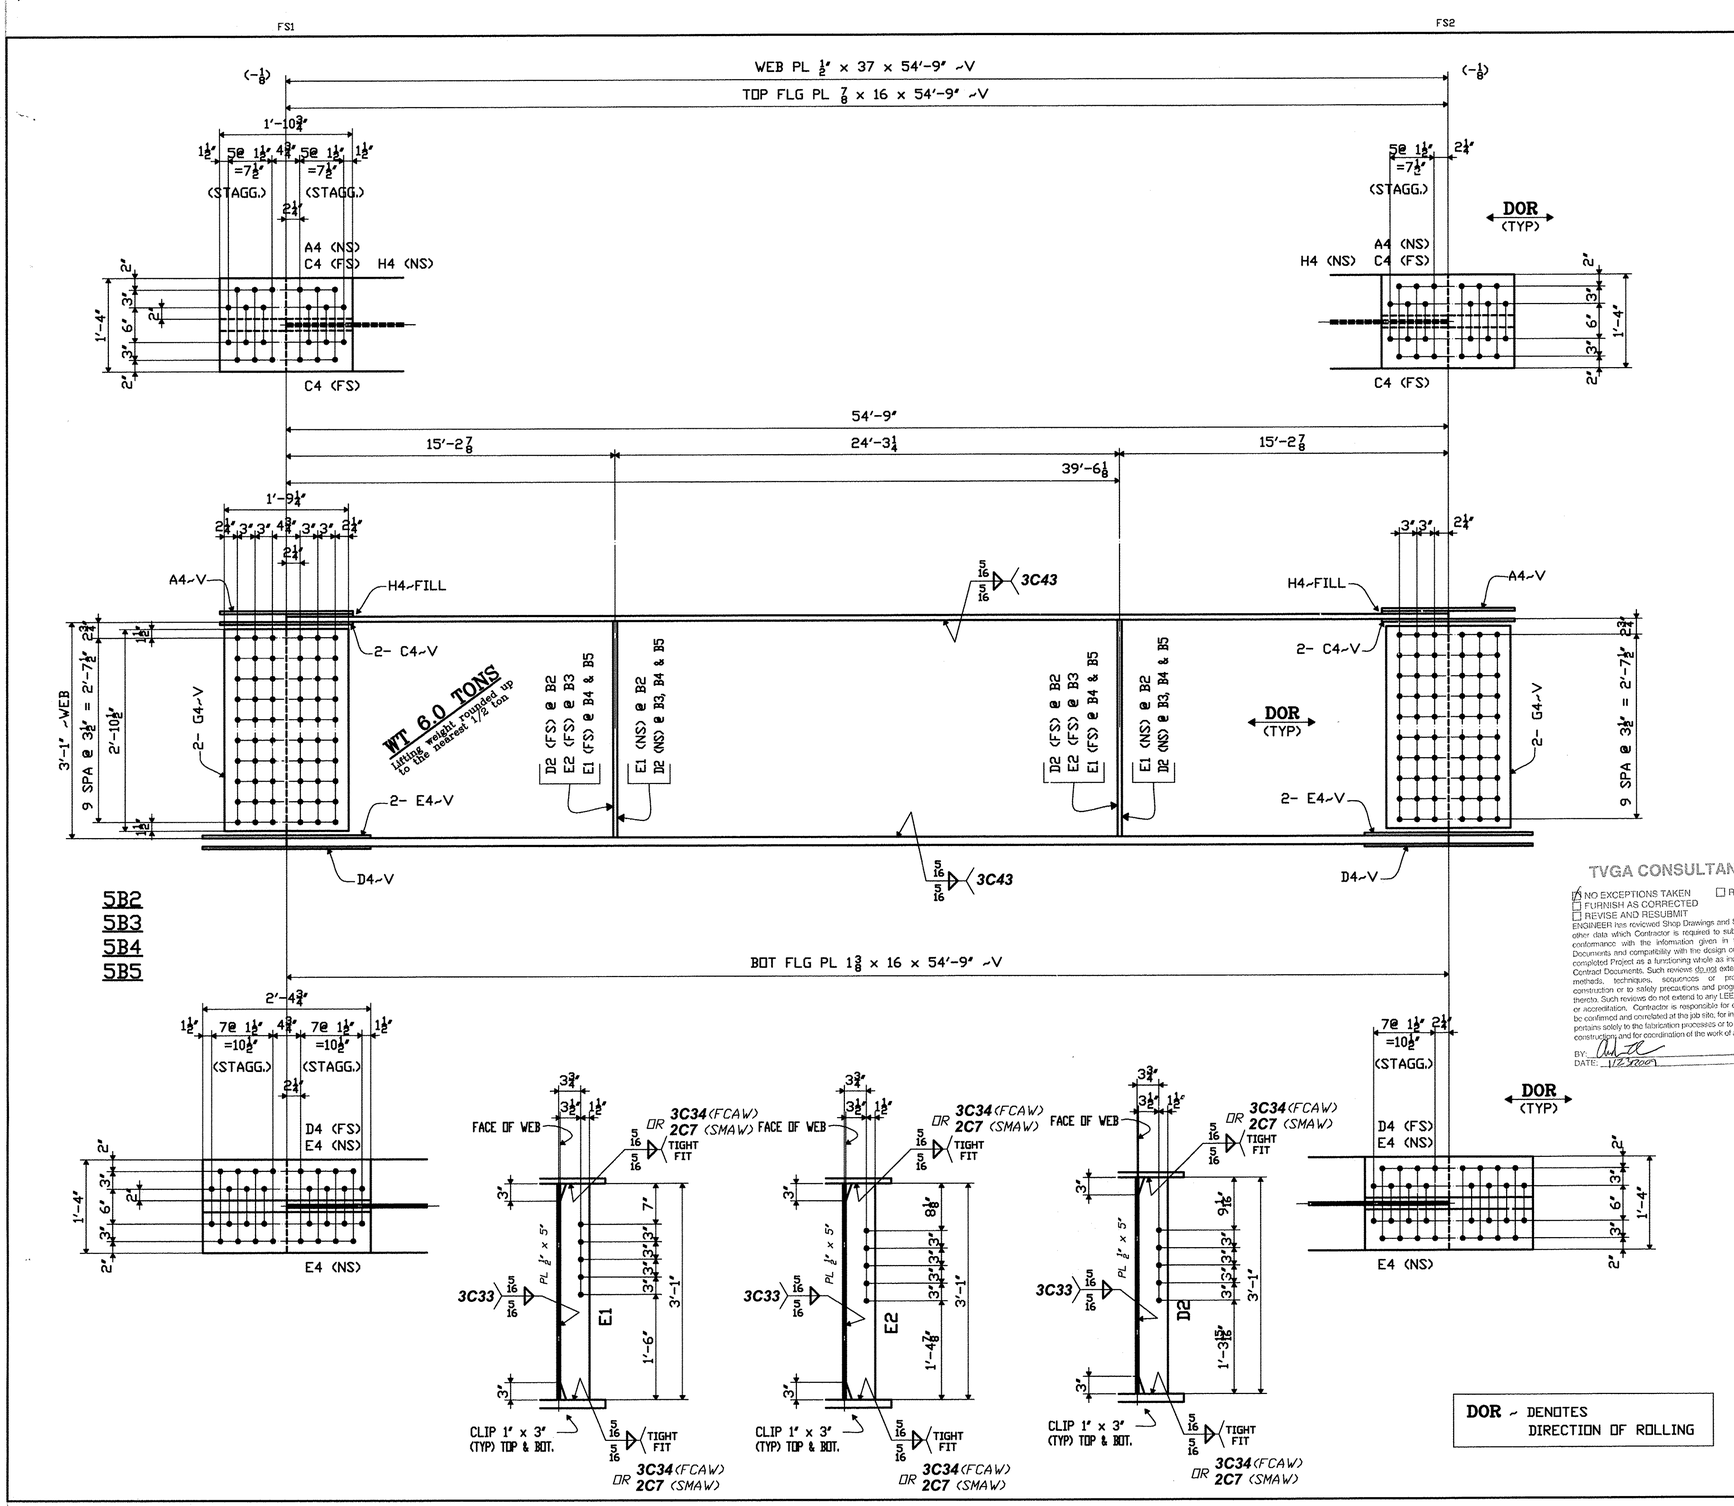

SHOP BILL

MARK SIZE	SHIPPING LIST NO. PCS	SHIPPING LIST MARK	PCS REQ'D	DESCRIPTION CODE	DESCRIPTION SYMBOL	DESCRIPTION SECTION DIM'S	LENGTH FEET	LENGTH INCHES	ASSEMBLY MARK	REMARKS	MTRL. SPEC.	MATERIAL APPLICATION P.O. NO.	LINE ITEM	NO. PCS.	LENGTH
1															
2	1	5B2			PLATE GIRDER										
3	1	5B3			PLATE GIRDER										
4	1	5B4			PLATE GIRDER										
5	1	5B5			PLATE GIRDER										
6			4		PL	7/8 x 16	54	9	TFB1	V	M270-50W	6014NH	5		
7			4		PL	1 3/8 x 16	54	9	BFB1	V	M270-50W	6014NH	2		
8			4		PL	1/2 x 37	54	9	WB1	V	M270-50W	6014NH	7		
9															
10			8		PL	1/2 x 16	1	10 3/4	A4	V	M270-50W	6016NH	4		
11			16		PL	1/2 x 7	1	10 3/4	C4	V	M270-50W	6016NH	4		
12			8		PL	3/4 x 16	2	4 3/4	D4	V	M270-50W	6016NH	2		
13			16		PL	3/4 x 7	2	4 3/4	E4	V	M270-50W	6016NH	2		
14			16		PL	3/8 x 34 1/2	1	9 1/4	G4	V	M270-50W	SHN			
15			8		PL	1/2 x 16	0	11 1/4	H4		M270-50W	6016NH	4		
16															
17			32	F	BOLT	7/8	0	3 1/2		SHIPPING BOLTS	A307	PS6329	2		
18			32	F	BOLT	7/8	0	4		SHIPPING BOLTS	A307	PS6329	3		
19			16	F	BOLT	7/8	0	2 1/2		SHIPPING BOLTS	A307	PS6329	1		
20															
21			6		PL	1/2 x 5	3	1	E1	TF-2E	M270-50W	6016NH	4		
22			2		PL	1/2 x 5	3	1	E2	TF-2E	M270-50W	6016NH	4		
23			8		PL	1/2 x 5	3	1	D2	TF-2E	M270-50W	6016NH	4		
24															
25		DOMESTIC MATERIAL													

SEE HN1 FOR FABRICATION NOTES

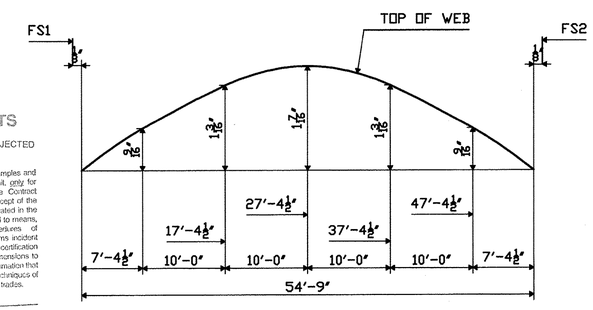

CAMBER DIAGRAM

PROJECT No: ACIM 091-1(33)
STA. 22+69.92 TO STA. 25+28.14
BRIDGE No. 3N (NORTHBOUND)
TOWN OF GUILFORD

FABRICATED BY COLFAX
HOLES 15/16 SHOP FASTENERS
SHOP PAINT NONE
SHOP INSPECTION
GENERAL NOTES

REVISIONS		
DATE	NO.	BY
	R1	

ORDER NO. 08-18537H22
DETAILS OF PL GIRDER ~ SPAN B LINES 2, 3, 4 & 5
PROJECT I-91 OVER BROAD BROOK AND BROAD BROOK ROAD
LOCATION WINDHAM COUNTY, VT
CUSTOMER MEC CONSTRUCTION

CAROLINA STEEL GROUP, LLC.

MADE BY GM
CHECKED BY PDC/SB
SQUAD LEADER Precise Drafting Co. Inc.
DATE 09-08
SHEET HF5