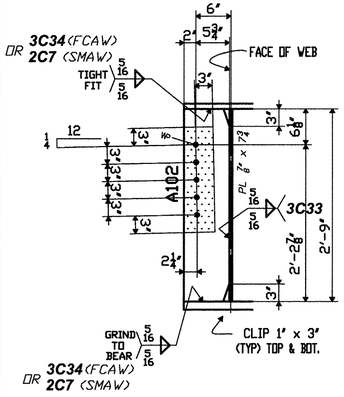

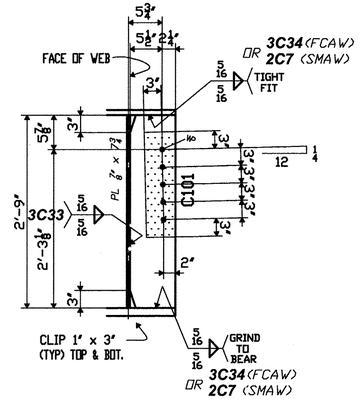

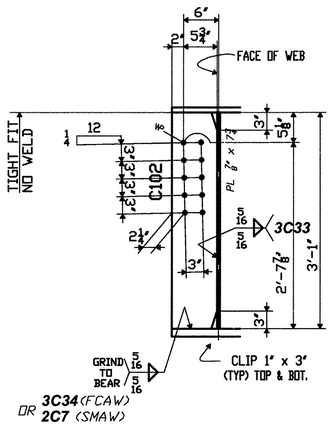

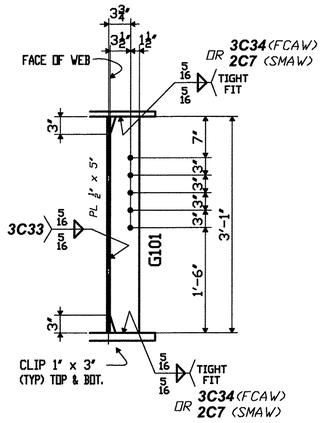

PAINT NOTE "C"
AREA SHOWN THUS
DENOTES FAYING SURFACE.
APPLY PRIMER ONLY (BS) (1)(CS)
(1)(CS) DENOTES "CONTACT SURFACE"

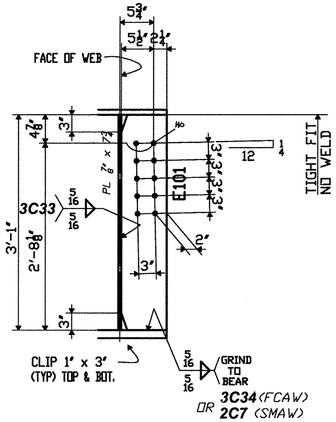

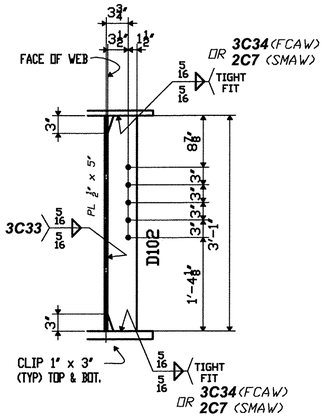

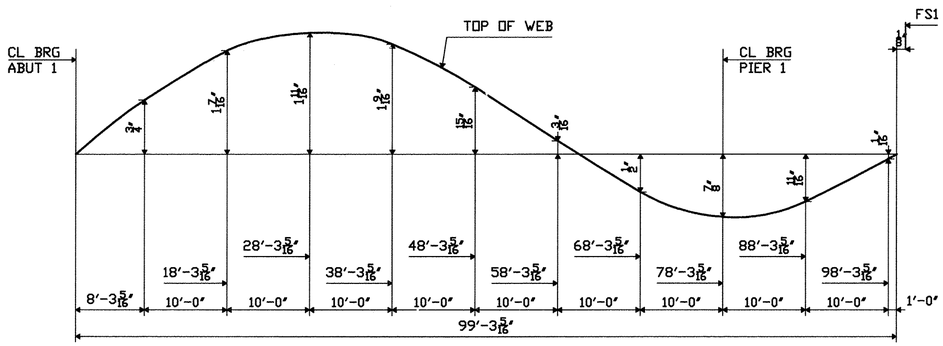

CAMBER DIAGRAM

SHOP BILL

LINE ITEM	SHIPPING LIST NO. PCS	SHIPPING LIST MARK	PCS REQ'D	DESCRIPTION CODE	SYMBOL	SECTION DIM'S	LENGTH FEET	LENGTH INCHES	ASSEMBLY MARK	REMARKS	MTRL. SPEC.	MATERIAL APPLICATION P.O. NO.	LINE ITEM	NO. PCS.	LENGTH
1															
2	1	102AB2			PLATE GIRDER										
3	1	102AB3			PLATE GIRDER										
4	1	102AB4			PLATE GIRDER										
5			3		PL	7/8 x 16	58	6 7/16	TFAB1	V	M270-50W	6015NH	4		
6			3		PL	1 3/16 x 16	41	5 7/8	TFAB2	V	M270-50W	6015NH	3		
7			3		PL	1 3/16 x 16	58	7 1/2	BFAB1	V	M270-50W	6015NH	1		
8			3		PL	1 3/16 x 16	41	5 7/8	BFAB2	V	M270-50W	6015NH	3		
9			3		PL	1/2 x 37	34	4 3/16	WAB1	V	M270-50W	6015NH	9		
10			3		PL	1/2 x 37	65	9	WAB2	V	M270-50W	6015NH	7		
11															
12			4		PL	7/8 x 7 3/4	2	9	A102	FIN-2E	M270-50W	6016NH	1		
13			2		PL	7/8 x 7 3/4	2	9	C101	FIN-2E	M270-50W	6016NH	1		
14			4		PL	7/8 x 7 3/4	3	1	C102	FIN-2E	M270-50W	6016NH	1		
15			2		PL	7/8 x 7 3/4	3	1	E101	FIN-2E	M270-50W	6016NH	1		
16			20		PL	1/2 x 5	3	1	D102	TF-2E	M270-50W	6016NH	4		
17			10		PL	1/2 x 5	3	1	G101	TF-2E	M270-50W	6016NH	4		
18															
19															
20															
21															
22															
23															
24															
25		DOMESTIC MATERIAL													

SEE HN101 FOR FABRICATION NOTES

TVGA CONSULTANTS

☑ NO EXCEPTIONS TAKEN ☐ REJECTED
☐ FURNISH AS CORRECTED
☐ REVISE AND RESUBMIT
ENGINEER has reviewed Shop Drawings and Samples and other data which Contractor is required to submit, only for conformance with the information given in the Contract Documents and compatibility with the design concept of the completed Project as a functioning whole as indicated in the Contract Documents. Such reviews do not extend to means, methods, techniques, sequences or procedures of construction or to safety precautions and programs incident thereto. Such reviews do not extend to any LEED certification or accreditation. Contractor is responsible for dimensions to be confirmed and correlated at the job site; for information that pertains solely to the fabrication processes or to techniques of construction; and for coordination of the work of all trades.
BY: Chris Tait
DATE: 12/22/09

PROJECT No: ACIM 091-1(33)
STA. 22+47.71 TO STA. 25+05.93
BRIDGE No. 3S (SOUTHBOUND)
TOWN OF GUILFORD

FABRICATED BY NASH
HOLES 15/16Ø SHOP FASTENERS
SHOP PAINT PARTIAL PAINT PER HN101 & AS NOTED
SHOP INSPECTION
GENERAL NOTES WORK THIS SHEET w/HF102A

REVISIONS			
DATE	NO.	BY	
07/08/09	R1	PDC/SB	ADDED CONTACT SURFACE

ORDER NO. 08-18537H32
DETAILS OF PL GIRDER - SPAN AB LINE 2, 3 & 4
PROJECT I-91 OVER BROAD BROOK AND BROAD BROOK ROAD
LOCATION WINDHAM COUNTY, VT
CUSTOMER MEC CONSTRUCTION

CAROLINA STEEL GROUP, LLC.

MADE BY GM
CHECKED BY PDC/SB
SQUAD LEADER Precise Drafting Co. Inc.
DATE 09-08

SHEET HF102B