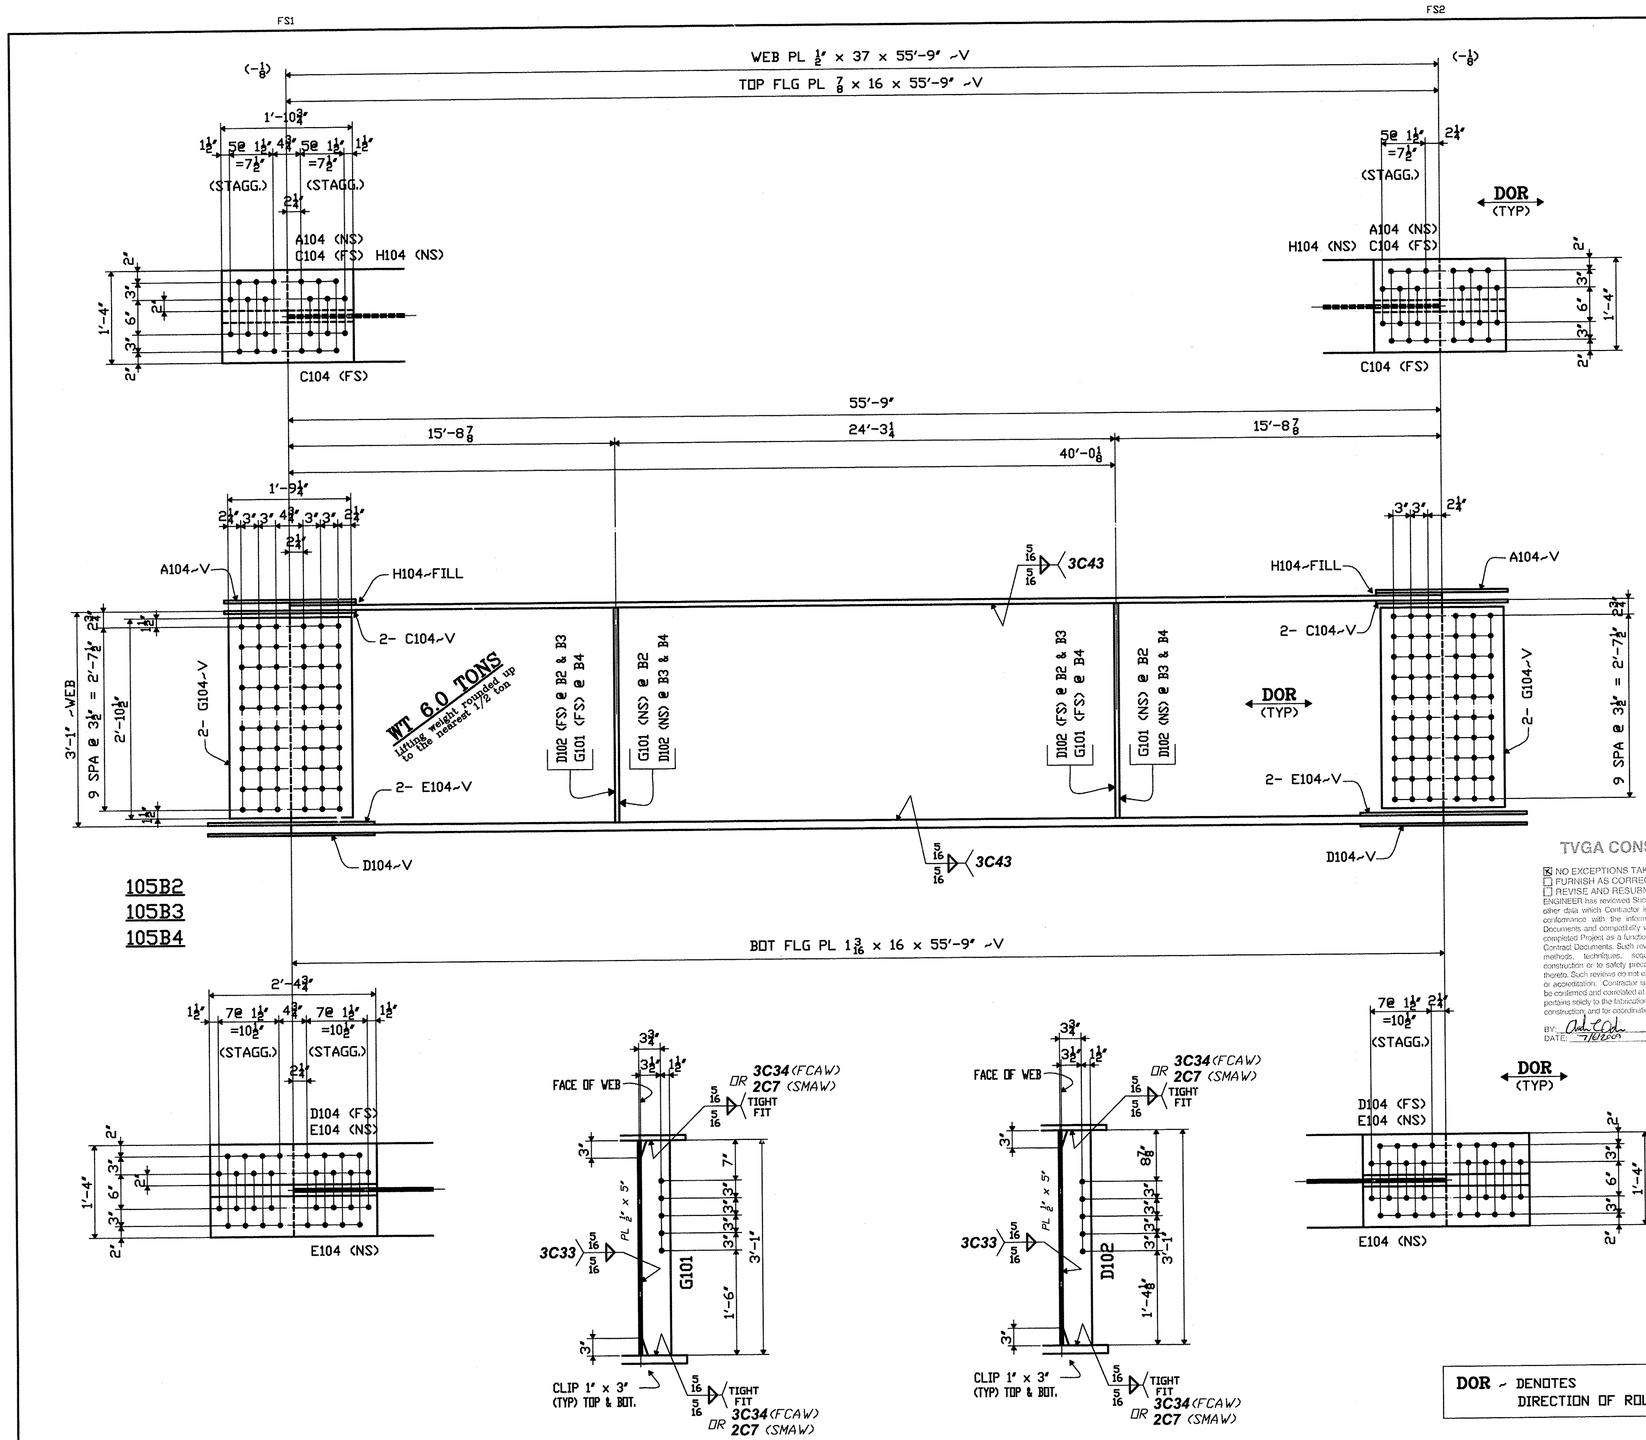

SHOP BILL

LINE ITEM	SHIPPING LIST NO. PCS	SHIPPING LIST MARK	PCS. REQ'D	DESCRIPTION CODE	DESCRIPTION SYMBOL	DESCRIPTION SECTION DIM'S	LENGTH FEET	LENGTH INCHES	ASSEMBLY MARK	REMARKS	MTRL. SPEC.	MATERIAL APPLICATION P.O. NO.	MATERIAL APPLICATION LINE ITEM	MATERIAL APPLICATION NO. PCS.	MATERIAL APPLICATION LENGTH
1															
2	1	105B2			PLATE GIRDER										
3	1	105B3			PLATE GIRDER										
4	1	105B4			PLATE GIRDER										
5			3		PL	7/8 x 16	55	9	TFB1	V	M270-50W	6015NH	5		
6			3		PL	1 3/16 x 16	55	9	BFB1	V	M270-50W	6015NH	2		
7			3		PL	1/2 x 37	55	9	WB1	V	M270-50W	6015NH	X	6	
8															
9			6		PL	1/2 x 16	1	10 3/4	A104	V	M270-50W	6016NH	4		
10			12		PL	1/2 x 7	1	10 3/4	C104	V	M270-50W	6016NH	4		
11			6		PL	3/4 x 16	2	4 3/4	D104	V	M270-50W	6016NH	2		
12			12		PL	3/4 x 7	2	4 3/4	E104	V	M270-50W	6016NH	2		
13			12		PL	3/8 x 34 1/2	1	9 1/4	G104	V	M270-50W	SHN			
14			6		PL	5/16 x 16	0	11 1/4	H104		M270-50W	SHN			
15															
16			24	F	BOLT	7/8	0	3 1/2		SHIPPING BOLTS	A307	PS6331	2		
17			24	F	BOLT	7/8	0	4		SHIPPING BOLTS	A307	PS6331	3		
18			12	F	BOLT	7/8	0	2 1/2		SHIPPING BOLTS	A307	PS6331	1		
19															
20			4		PL	1/2 x 5	3	1	G101	TF-2E	M270-50W	6016NH	4		
21			8		PL	1/2 x 5	3	1	D102	TF-2E	M270-50W	6016NH	4		
22															
23															
24															
25		DOMESTIC MATERIAL													

1

SEE HN101 FOR FABRICATION NOTES

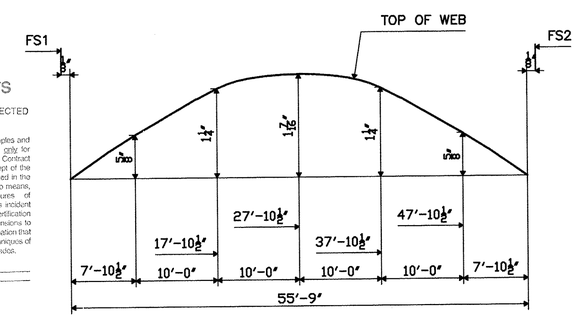

CAMBER DIAGRAM

TVGA CONSULTANTS

☒ NO EXCEPTIONS TAKEN ☐ REJECTED
☐ FURNISH AS CORRECTED
☐ REVISE AND RESUBMIT

ENGINEER has reviewed Shop Drawings and Samples and other data which Contractor is required to submit, only for conformance with the information given in the Contract Documents and compatibility with the design concept of the completed Project as a functioning whole as indicated in the Contract Documents. Such reviews do not extend to means, methods, techniques, sequences or procedures of construction or to safety precautions and programs incident thereto. Such reviews do not extend to any LEED certification or accreditation. Contractor is responsible for dimensions to be confirmed and correlated at the job site, for information that pertains solely to the fabrication processes or to techniques of construction, and for coordination of the work of all trades.

BY: [signature]
DATE: 7/15/2009

DOR ~ DENOTES DIRECTION OF ROLLING

PROJECT No: ACIM 091-1(33)
STA. 22+47.71 TO STA. 25+05.93
BRIDGE No. 3S (SOUTHBOUND)
TOWN OF GUILFORD

FABRICATED BY NASH
HOLES 15/16 Ø SHOP FASTENERS
SHOP PAINT NONE
SHOP INSPECTION
GENERAL NOTES

REVISIONS			
DATE	NO.	BY	
08/18/09	R1	PDC/WS	REVISED LINE ITEM

ORDER NO. 08-18537H32
DETAILS OF PL GIRDER ~ SPAN B LINES 2, 3 & 4
PROJECT I-91 OVER BROAD BROOK AND BROAD BROOK ROAD
LOCATION WINDHAM COUNTY, VT
CUSTOMER MEC CONSTRUCTION

CAROLINA STEEL GROUP, LLC.

MADE BY GM
CHECKED BY PDC/SB
SQUAD LEADER Precise Drafting Co. Inc.
DATE 09-08

SHEET HF105