J & B WELDING, INC.

229 N. MAIN STREET COOPERSBURG, PA 18036
PHONE: (610) 282-3461 MAIN FAX: (610)282-3014

Guilford IM 091-1(33)
I-91 over Broad Brook & Road

STYROFOAM FILLER FOR STAY-IN-PLACE PANS
"STRONGWEB"

NORTHBOUND:

Wheeling Corrugated 2 ½" Deep X 8" Pitch
Four (4) pieces of foam required per pan
For quantity & size of pans required see
"Bridge Deck Material List" Sht 2 of 2
Length of foam is 5" less than pan size for end taper

3 ¾" top W

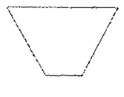

2 3/8" H

2" bottom W

SOUTHBOUND:

Wheeling Corrugated 2" Deep X 8 1/2" Pitch
Four (4) pieces of foam required per pan
For quantity & size of pans required see
"Bridge Deck Material List" Sht 2 of 2
Length of foam is 5" less than pan size for end taper

3 1/2" top W

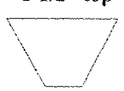

2" H

2 1/4" bottom W

TVGA CONSULTANTS

☒ NO EXCEPTIONS TAKEN ☐ REJECTED
☐ FURNISH AS CORRECTED
☐ REVISE AND RESUBMIT

ENGINEER has reviewed Shop Drawings and Samples and other data which Contractor is required to submit, only for conformance with the information given in the Contract Documents and compatibility with the design concept of the completed Project as a functioning whole as indicated in the Contract Documents. Such reviews do not extend to means, methods, techniques, sequences or procedures of construction or to safety precautions and programs incident thereto. Such reviews do not extend to any LEED certification or accreditation. Contractor is responsible for dimensions to be confirmed and correlated at the job site; for information that pertains solely to the fabrication processes or to techniques of construction; and for coordination of the work of all trades.

BY: _____
DATE: 4/8/2009