GENERAL NOTES:

SEE SHEET 1

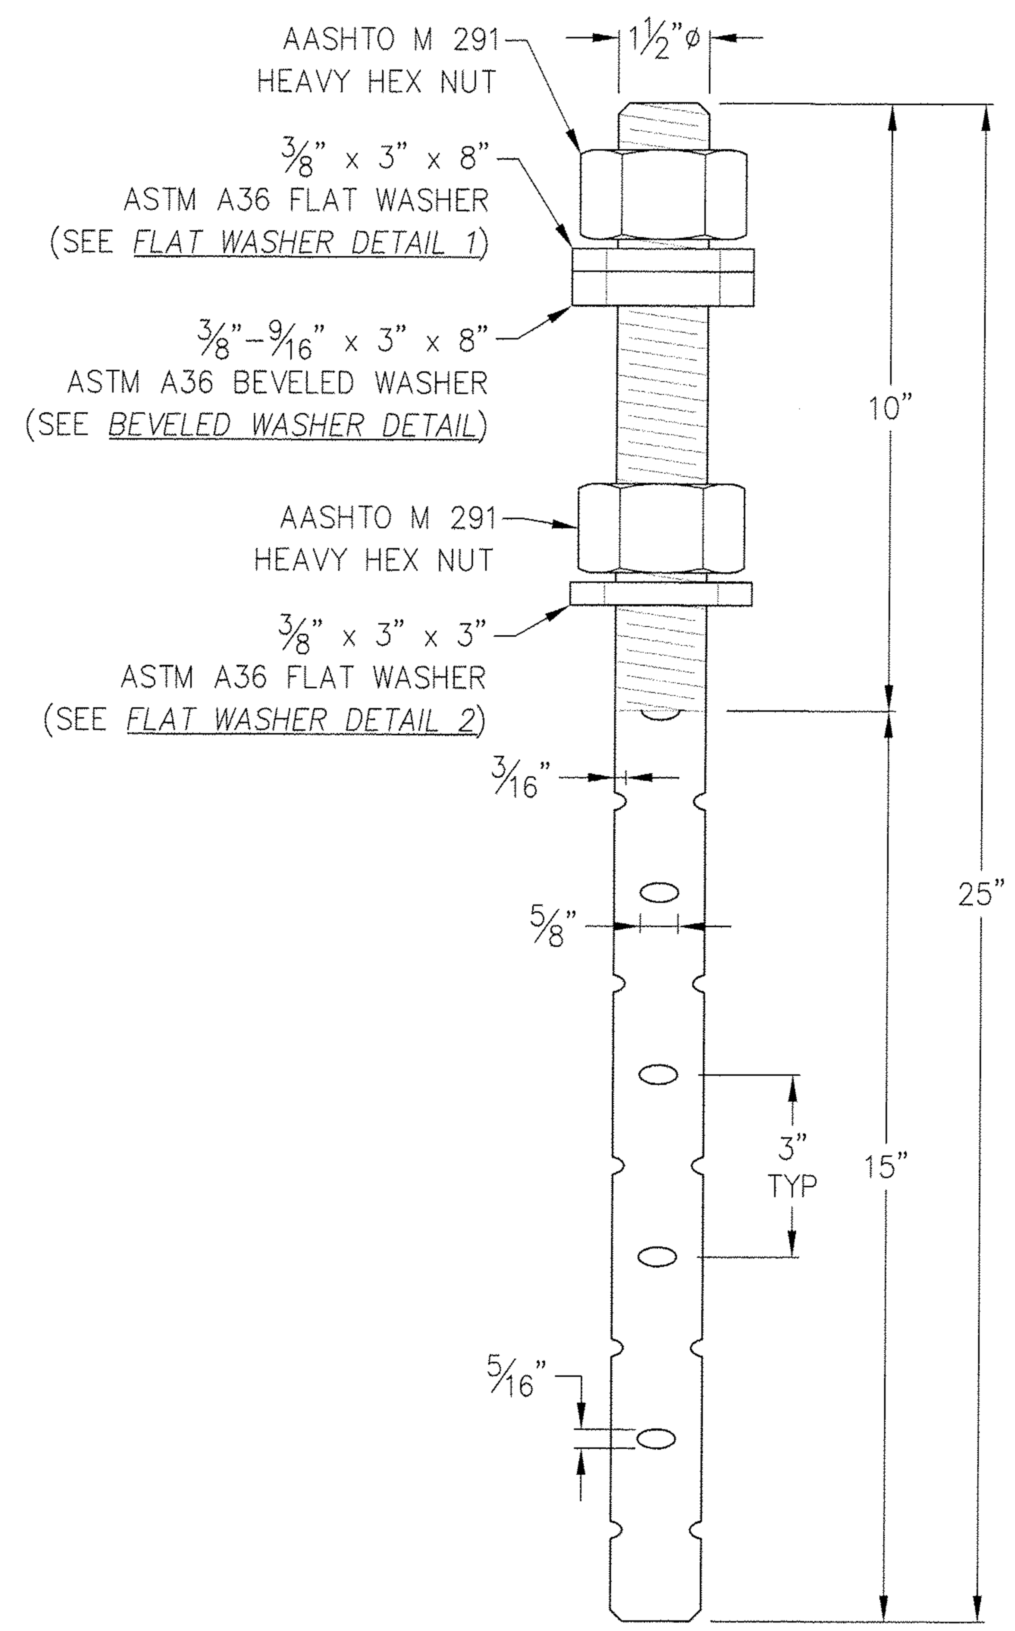

ANCHOR BOLT ASSEMBLY

1½"ø x 25" LONG ASTM A307 SWEDGED ANCHOR BOLT
w/ (2) AASHTO M 291 HEAVY HEX NUTS,
(1) ⅜" x 3" x 3" ASTM A36 FLAT WASHER,
(1) ⅜" x 3" x 8" ASTM A36 FLAT WASHER &
(1) ⅜"-9/16" x 3" x 8" ASTM A36 BEVELED WASHER
ALL GALVANIZED PER AASHTO M 232
(24) REQ'D FOR MK. 05
(20) REQ'D FOR MK. 06
(44) TOTAL REQ'D

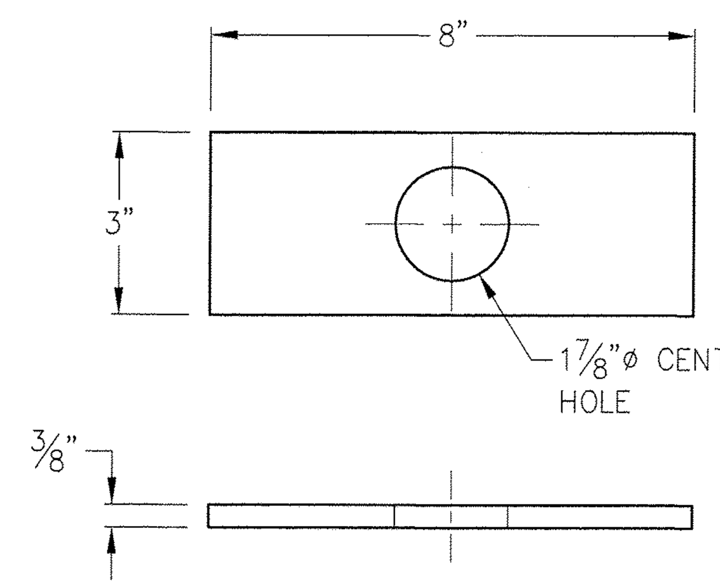

FLAT WASHER DETAIL 1

⅜" x 3" x 8" ASTM A36 FLAT WASHER

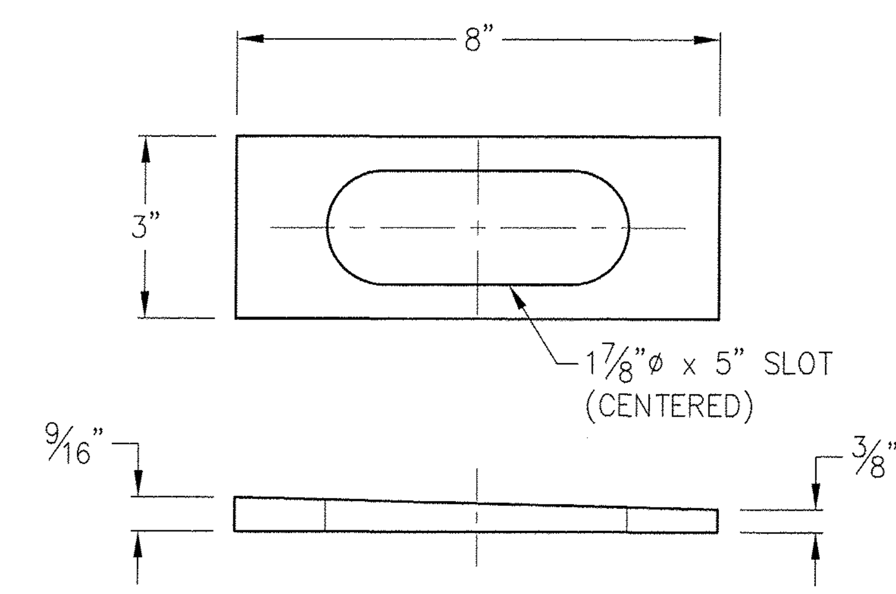

BEVELED WASHER DETAIL

⅜"-9/16" x 3" x 8" ASTM A36 BEVELED WASHER

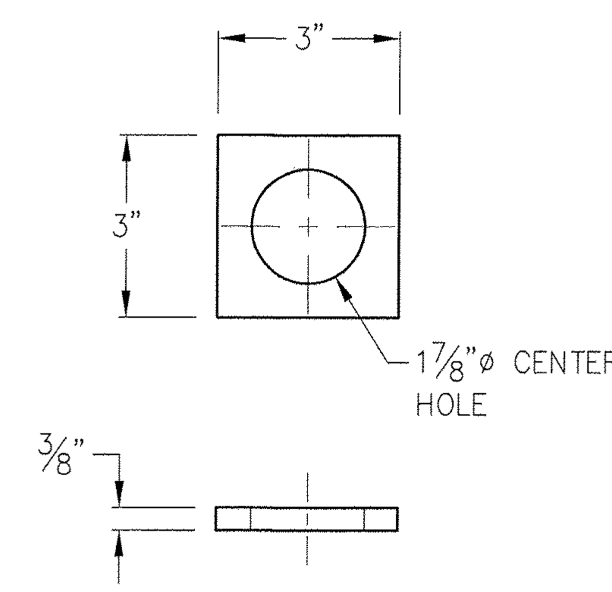

FLAT WASHER DETAIL 2

⅜" x 3" x 3" ASTM A36 FLAT WASHER

TVGA CONSULTANTS
NO EXCEPTIONS TAKEN / REJECTED
BY: James W. Ruppert
DATE: 1/20/09

Seismic Energy Products, L.P.
STRUCTURAL BEARINGS FOR BRIDGES & BUILDINGS
518 PROGRESS WAY PHONE: 903-675-8571
ATHENS, TEXAS 75751 FAX: 903-677-2875

STATE OF VERMONT
AGENCY OF TRANSPORTATION

CUSTOMER: J.A. McDONALD		
P.O. NO: SIGNED QT		
TOWN OF GUILFORD	HIGHWAY NO. I-91	BRIDGE NO. 3N & 3S
PROJECT GUILFORD	PROJECT NO. IM 091-1(33)	

I-91 OVER BROAD BROOK
& BROAD BROOK ROAD
EXPANSION BEARINGS – ELASTOMERIC

REV	DESCRIPTION	DATE
A	ORIGINAL SHOP DWG ISSUE	11/24/08

DWN BY DMH	DATE 10/6/08	DRAWING NO.	SHEET NO.
CHK BY CW	DATE 10/14/08	38627VT-08	8 OF 8

SCALE: NTS