BRIDGE 43 S

SCALE: 1" = 4'

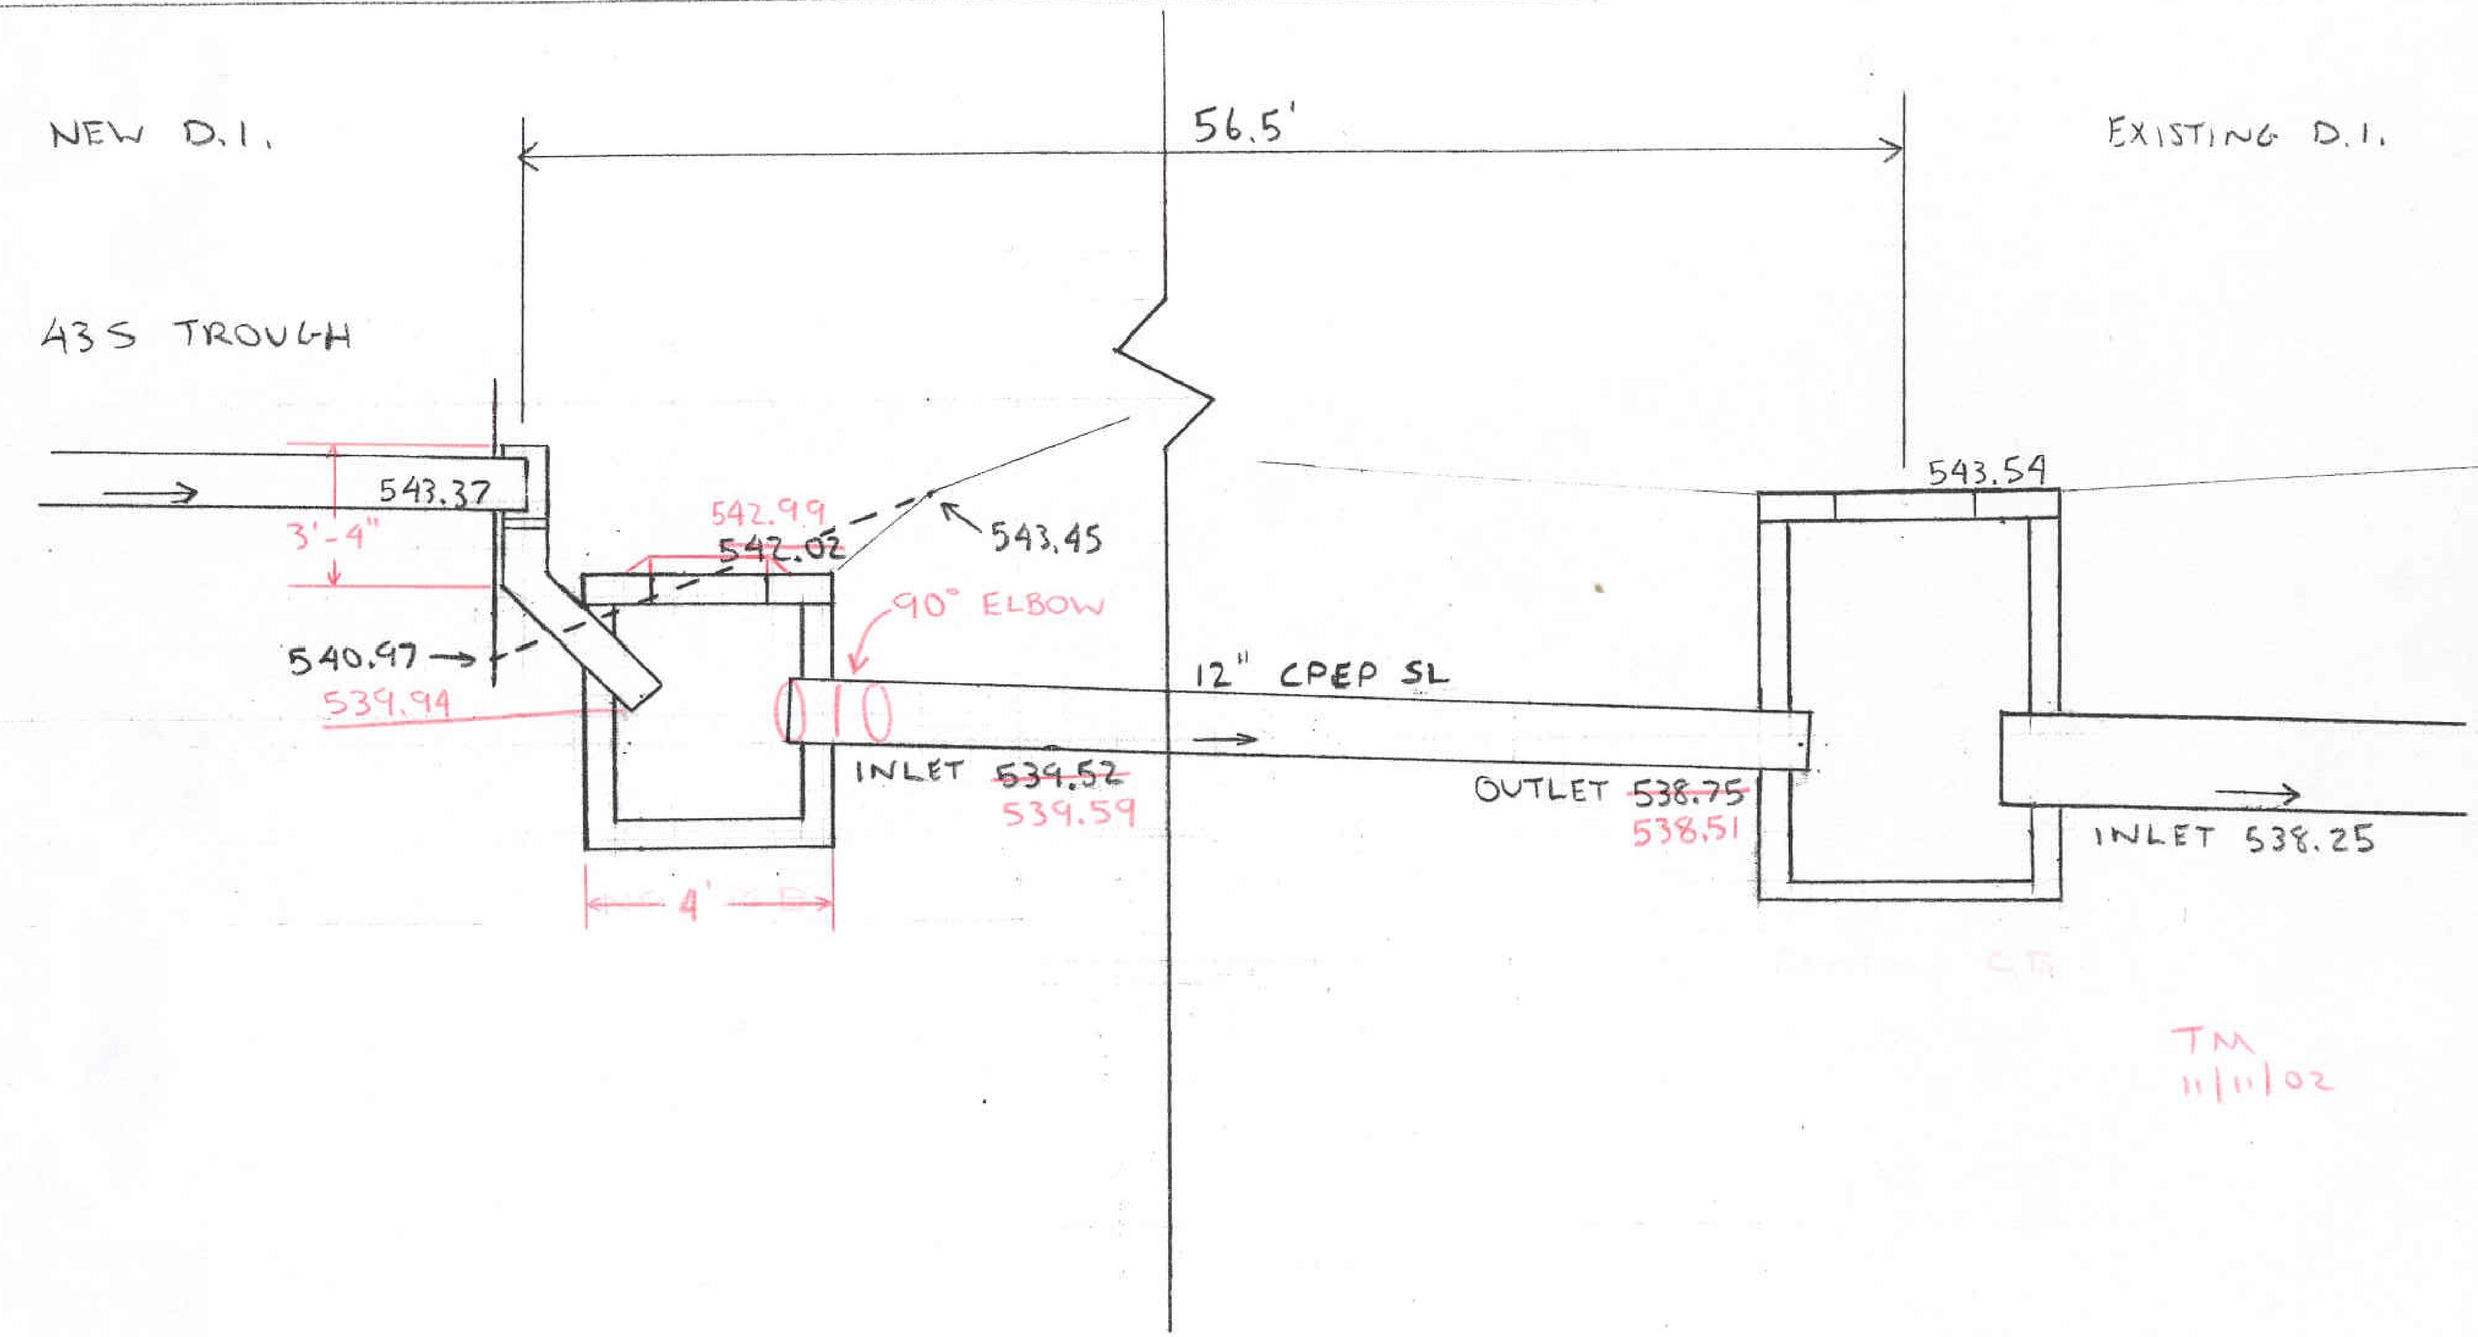


TM
11/11/02

047A