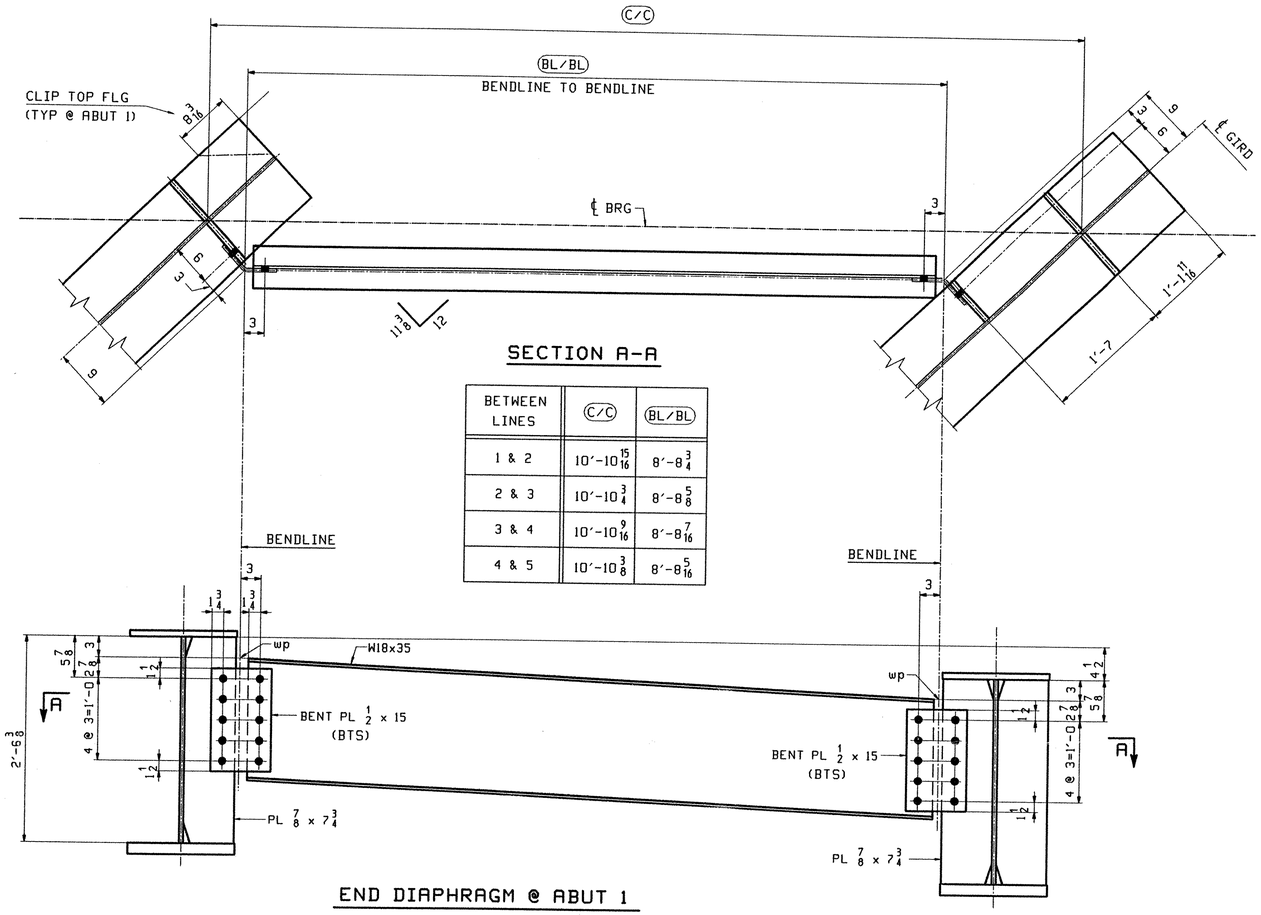

SECTION A-A

BETWEEN LINES	C/C	BL/BL
1 & 2	10'-10 15/16	8'-8 3/4
2 & 3	10'-10 3/4	8'-8 5/8
3 & 4	10'-10 9/16	8'-8 7/16
4 & 5	10'-10 3/8	8'-8 5/16

END DIAPHRAGM @ ABUT 1

(LOOKING BACK STATION)

THIS DIAPH SHALL BE PAINTED - SEE GN501

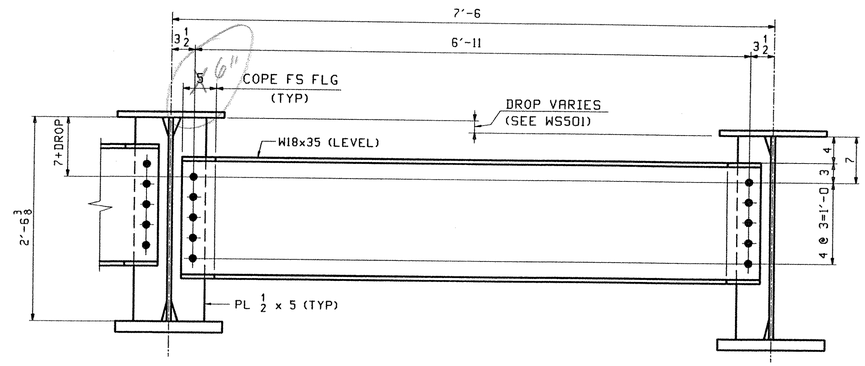

TYP. INTERMEDIATE DIAPHRAGM

(LOOKING BACK STATION)
(NTS)

DETAILER NOTE

ALL EDGE DISTANCES ARE 1 3/4" U.N.

BEND LINES ARE TAKEN @ C/L PLATE.

**** NOTE ****
THE PURPOSE OF THIS DRAWING IS TO COORDINATE GEOMETRIC CONTROL INFORMATION AND CONNECTION SPACING. THIS DWG IS SUBMITTED FOR INFORMATION ONLY & IS NOT INTENDED FOR SHOP FABRICATION. DETAIL DWGS WILL SHOW ALL WELDING AND DIMENSIONS REQ'D FOR FABRICATION.

SCALE: 1 1/8" = 1'-0

TVGA
Engineering, Surveying, P.C.

☐ NO EXCEPTIONS TAKEN ☐ REJECTED
☒ FURNISH AS CORRECTED
☐ REVISE AND RESUBMIT

ENGINEER has reviewed Shop Drawings and Samples and other data which Contractor is required to submit, only for conformance with the information given in the Contract Documents and compatibility with the design concept of the completed Project as a functioning whole as indicated in the Contract Documents. Such reviews do not extend to means, methods, techniques, sequences or procedures of construction or to safety precautions and programs incident thereto. Contractor is responsible for dimensions to be confirmed and correlated at the job site; for information that pertains solely to the fabrication processes or to techniques of construction and for coordination of the work of all trades.

BY: Pat W. Gatti
DATE: 5/3/01

REV.	REMARKS	DATE	DWN	CHK	APP	Q.A.	NO.	DIA.	LGT	TYPE	WASHER
	OUT FOR APPROVAL	4-5-01									
	OUT FOR APPROVAL										
	ISSUED TO SHOP										
	FIELD & OFFICE										

MATERIAL:	ELECTRODES:	HOLES:	SHOP BOLTS:
M270 GR 50W		15/16 ø (UN)	7/8 ø (UN)

SURFACE PREP. & PAINT:
-STEEL WITHIN 10'-0 OF ABUT 1 SHALL BE PAINTED (SEE GN501)
-ALL OTHER STEEL SHALL BE BLAST CLEANED AND LEFT UNPAINTED.

DESCRIPTION: LAYOUTS	DRAWN BY	DATE
JOB: BRIDGE NO. 505 I-89 SB OVER U.S. ROUTE 2 I-89 IMPROVEMENTS TOWN OF MIDDLESEX-BOLTON, VERMONT	JAK	02/27
	CHKD BY	
	WL	3/01
	APPROV BY	
TENSOR 2108-S	SUPERVISOR	W. J. GATTI
PROJ NO. IM-089-2(26)	Q.A.	
CUSTOMER: VERMONT AGENCY OF TRANSPORTATION		

CASCO BAY STEEL STRUCTURES, INC.
75 SPRING HILL ROAD SACO, MAINE 04072
PHONE (207) 282-7360 FAX. (207) 282-1179

JOB NO.	DRG. NO.
122-505	TD501
	REV. △

M:\...\2108-S-TD501.dwg Tue Mar 6 10:30:46 EST 2001 Rev0