JOB NO. 127-50N | DRG. NO. J2A

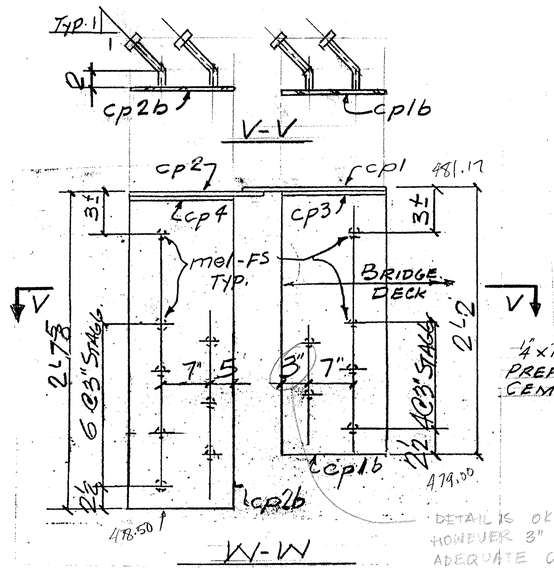

DETAIL IS OK @ SOUTH FACE HOWEVER 3" WILL NOT PROVIDE ADEQUATE COVER @ NORTH FACE

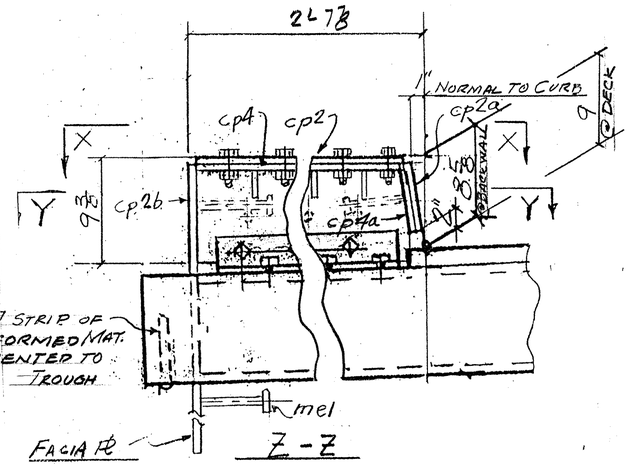

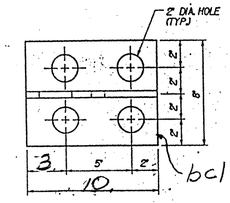

BRACKET PLAN

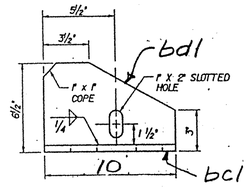

BRACKET ELEVATION

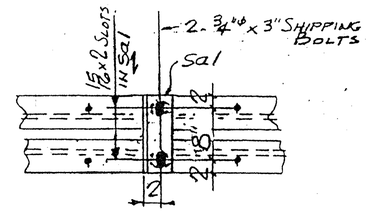

SHIPPING DEVICE
SPACED 54" O.C. MAX. (9 REQ'D)

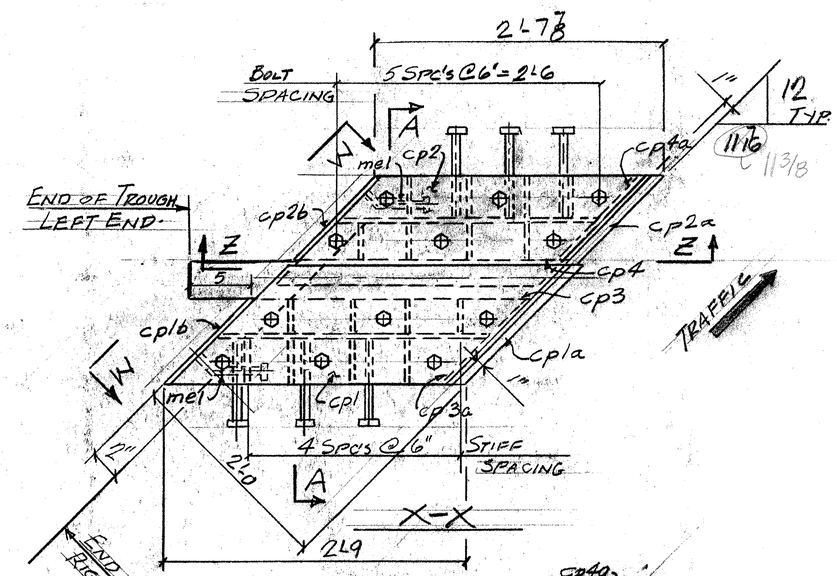

Y-Y
LEFT END BRUSH CURB SHOWN
RIGHT END - OPP HAND

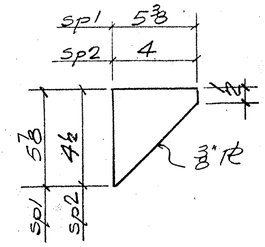

STIFF DETAILS

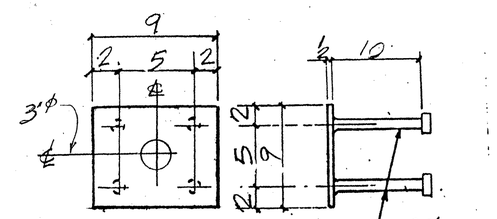

API-5 REQ'D
DO NOT GALVANIZE

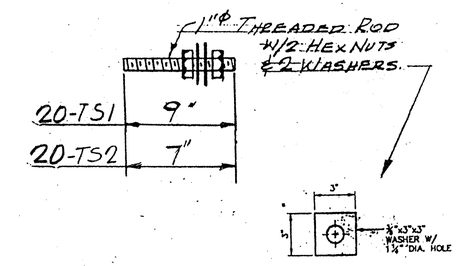

WASHER FOR BRACKET
W1

WORK THIS DWG. W/ DWG. J2

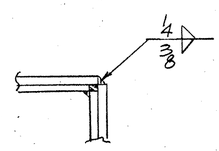

TYP. CORNER DET.

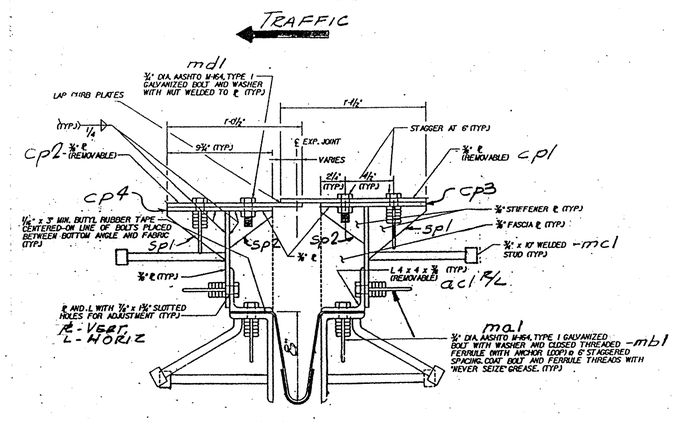

A-A

TVGA
Engineering, Surveying, P.C.

☐ NO EXCEPTIONS TAKEN ☐ REJECTED
☒ FURNISH AS CORRECTED
☐ REVISE AND RESUBMIT

ENGINEER has reviewed Shop Drawings and Samples and other data which Contractor is required to submit, only for conformance with the information given in the Contract Documents and compatibility with the design concept of the completed Project as a functioning whole as indicated in the Contract Documents. Such review does not extend to means, methods, techniques, sequences or procedures of construction or to safety precautions and programs incident thereto. Contractor is responsible for dimensions to be confirmed and correlated at the job site, for information that pertains solely to the fabrication processes or to techniques of construction and for coordination of the work of all trades.

BY: Peter W. Stec
DATE: 4/9/01

REV.	REMARKS	DATE	DWN	CHK	APP	Q.A.	NO.	DIA.	LGT	TYPE	WASHER
	OUT FOR APPROVAL	2-2-01									
	OUT FOR APPROVAL										
	ISSUED TO SHOP										
	FIELD & OFFICE										

PROJECT NO. IM-089-2(26) STATE BRIDGE NO. 50N
MATERIAL AASHTO M270 Gr 36 ELECTRODES: PER PROC HOLES: AS NOTED SHOP BOLTS:
SURFACE PREP. & PAINT:
GALVANIZED AFTER FAB

DESCRIPTION: EXP. JOINT-ABUT. 2
JOB: BRIDGE 50N
I 89 OVER U.S. ROUTE 2
MIDDLESEX-BOLTON VT
CUSTOMER: WINTERSET INC.

	DRAWN BY	DATE
	JPF	1-01
	CHKD BY	
	APPROV BY	
	Q.A.	

CASCO BAY STEEL STRUCTURES, INC.
75 SPRING HILL ROAD SACO, MAINE 04072
PHONE (207) 282-7360 FAX. (207) 282-1179

JOB NO. 127-50N | DRG. NO. J2A | REV. △