JOB NO. 124-43N | DRG. NO. J2A

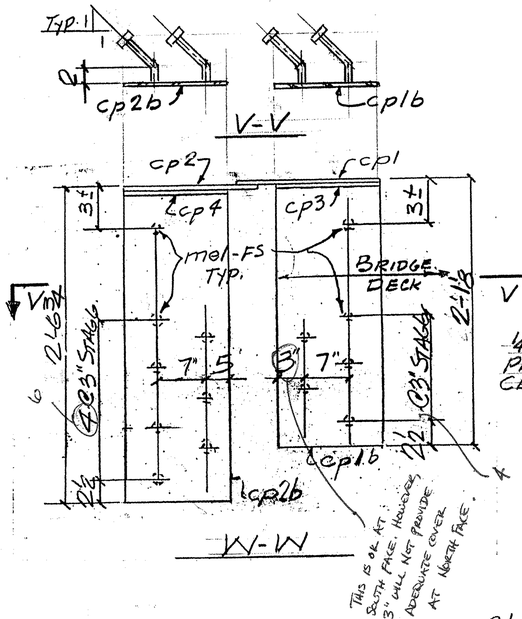

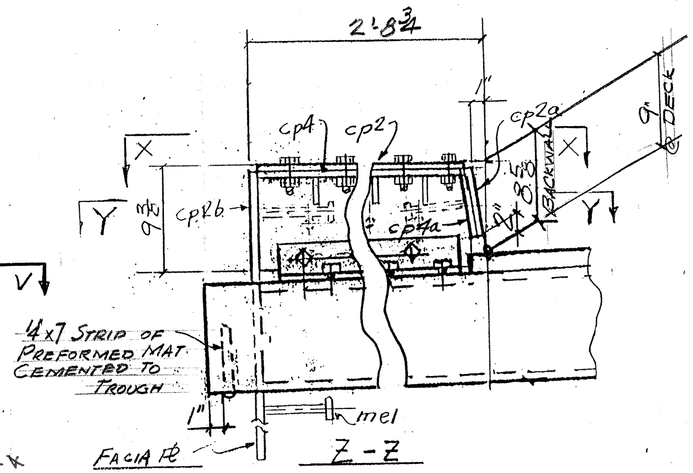

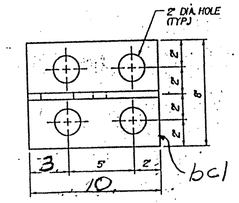

BRACKET PLAN

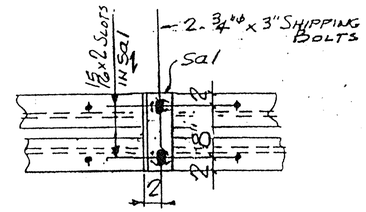

SHIPPING DEVICE
SPACED 5'-0" O.C. MAX. (9 REQ'D EA UNIT)

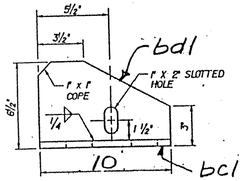

BRACKET ELEVATION

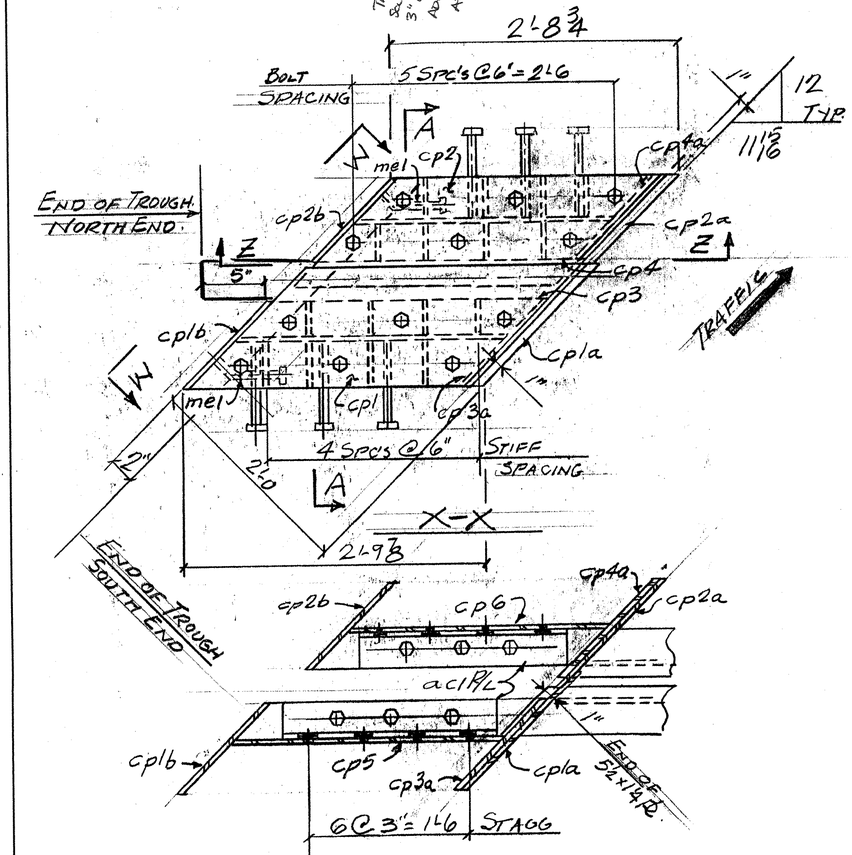

Y-Y (TROUGH NOT SHOWN)
SOUTH END BRUSH CURB SHOWN
NORTH END - OPP HAND

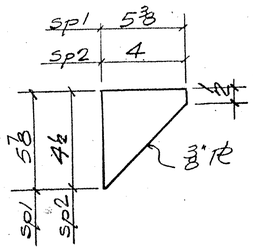

STIFF. DETAILS

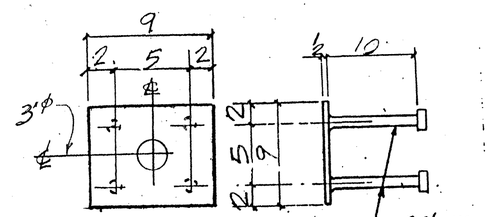

API-5 REQ'D
DO NOT GALVANIZE

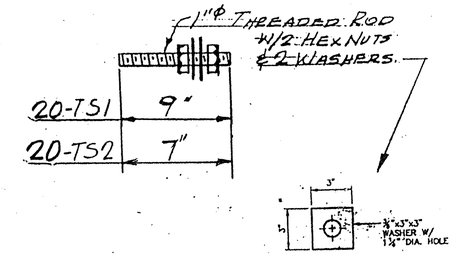

WASHER FOR BRACKET
W1

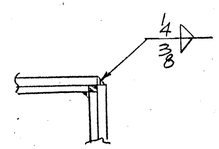

TYP. CORNER DET.

WORK THIS DWG. W/ DWG. J2

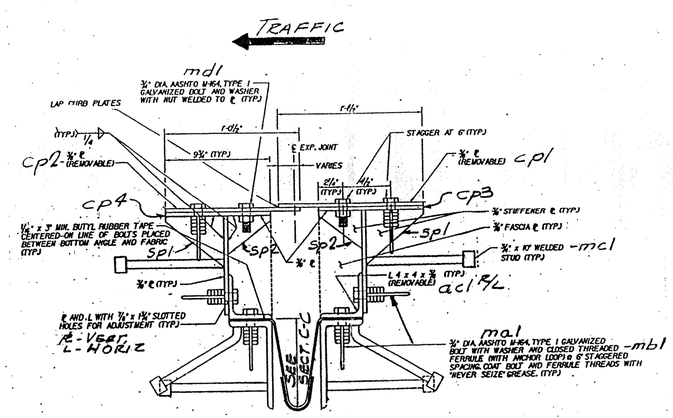

A-A

TVGA
Engineering, Surveying, P.C.

☐ NO EXCEPTIONS TAKEN ☐ REJECTED
☒ FURNISH AS CORRECTED
☐ REVISE AND RESUBMIT

ENGINEER has reviewed Shop Drawings and Samples and other data which Contractor is required to submit, only for conformance with the information given in the Contract Documents and compatibility with the design concept of the completed Project as a functioning whole as indicated in the Contract Documents. Such review does not extend to means, methods, techniques, sequences or procedures of construction or to safety precautions and programs incident thereto. Contractor is responsible for dimensions to be confirmed and correlated at the job site, for information that pertains solely to the fabrication processes or to techniques of construction; and for coordination of the work of all trades.

BY: Pete W. Zec
DATE: 2/13/01

REV.	REMARKS	DATE	DWN	CHK	APP	Q.A.	NO.	DIA.	LGT	TYPE	WASHER
	OUT FOR APPROVAL	1-26-01									
	OUT FOR APPROVAL										
	ISSUED TO SHOP										
	FIELD & OFFICE										

PROJECT NO. IM-089-2(26) STATE BRIDGE NO.
MATERIAL: ~~AASHTO~~ M270 GR36 | ELECTRODES: E70 PROC | HOLES: AS NOTED | SHOP BOLTS:
SURFACE PREP. & PAINT:
GALVANIZED AFTER FAB

DESCRIPTION: EXP. JOINT-ABUT. 2	DRAWN BY	DATE
JOB: BRIDGE 43N	dPF	1-01
I89 OVER U.S. ROUTE 2	CHKD BY	
MIDDLESEX-BOLTON VT	EJ	
	APPROV BY	
	Q.A.	
CUSTOMER: WINTERSET INC.		

CASCO BAY STEEL STRUCTURES, INC.
75 SPRING HILL ROAD SACO, MAINE 04072
PHONE (207) 282-7360 FAX. (207) 282-1179

JOB NO.	DRG. NO.
124-43N	J2A
	REV. △

504 BI 43N