| JOB NO. | DRG. NO. |
|---|---|
| 126-495N | J1A |







STIFF. DETAILS




BRACKET PLAN

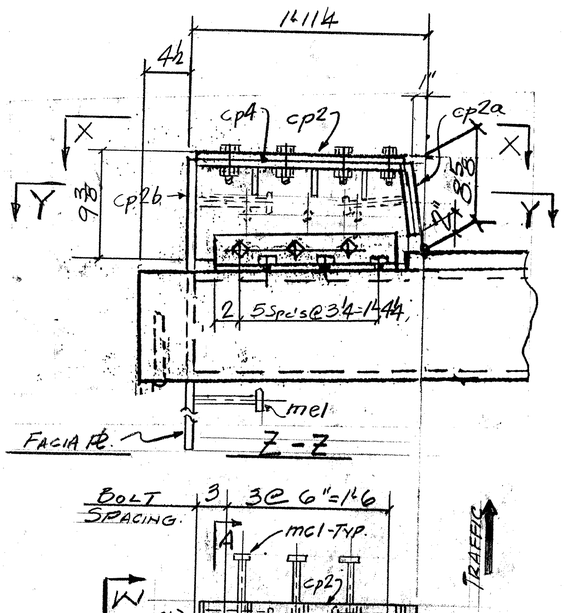


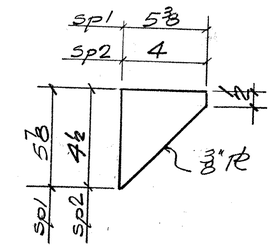SHIPPING DEVICE
SPACED 54" O.C. MAX. (9 REQ'D) EA. UNIT

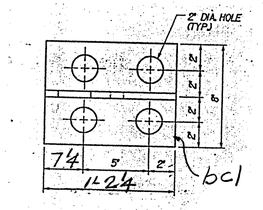


BRACKET ELEVATION

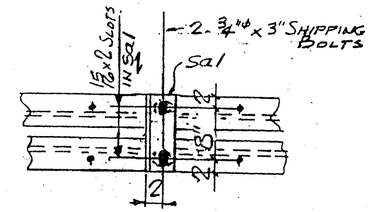


TYP. CORNER DET.

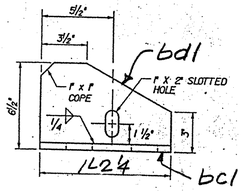


API-14-REQ'D
DO NOT GALVANIZE

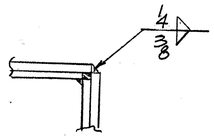


WASHER FOR BRACKET
W1

WORK THIS DWG. W/ DWG. J1

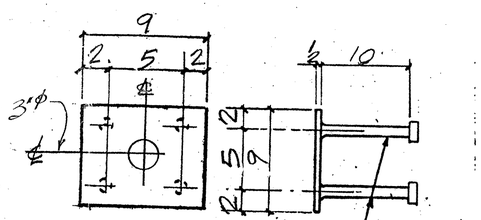TVGA
Engineering, Surveying, P.C.

X NO EXCEPTIONS TAKEN ☐ REJECTED
☐ FURNISH AS CORRECTED
☐ REVISE AND RESUBMIT

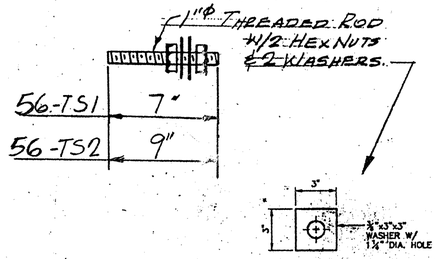ENGINEER has reviewed Shop Drawings and Samples and other data which Contractor is required to submit, only for conformance with the information given in the Contract Documents and compatibility with the design concept of the completed Project as a functioning whole as indicated in the Contract Documents. Such review does not extend to means, methods, techniques, sequences or procedures of construction or to safety precautions and programs incident thereto. Contractor is responsible for dimensions to be confirmed and correlated at the job site; for information that pertains solely to the fabrication processes or to techniques of construction; and for coordination of the work of all trades.

BY: Peter W. Smith
DATE: 2/13/01







Y-Y

LEFT END BRUSH CURB SHOWN
RIGHT END - OPP HAND.

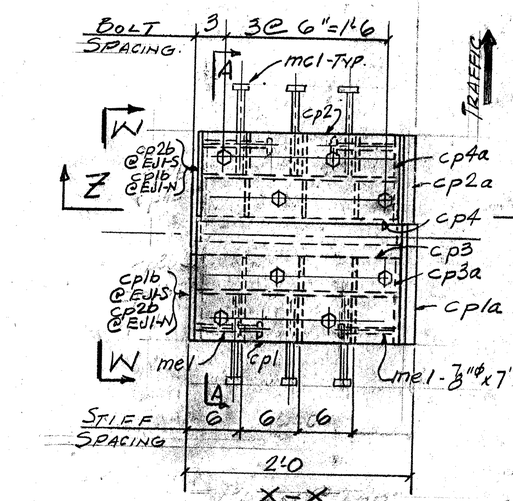


W-W @ EJ1-S (49S)

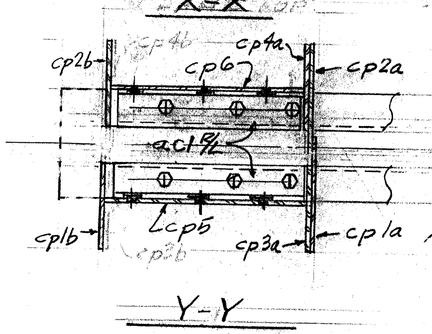


W-W @ EJ1-N (49N)

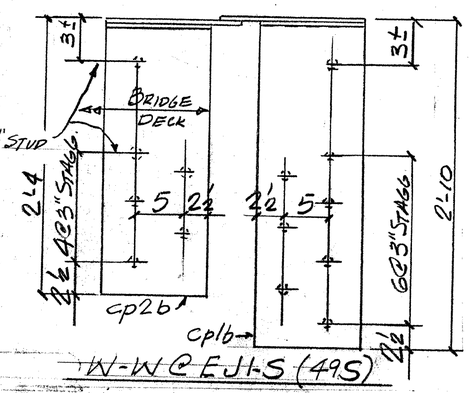


A-A

| REV. | REMARKS | DATE | DWN | CHK | APP | Q.A. | NO. | DIA. | LGT | TYPE | WASHER |
|---|---|---|---|---|---|---|---|---|---|---|---|
| | OUT FOR APPROVAL | 01-11-01 | | | | | | | | | |
| | OUT FOR APPROVAL | | | | | | | | | | |
| | ISSUED TO SHOP | | | | | | | | | | |
| | FIELD & OFFICE | | | | | | | | | | |

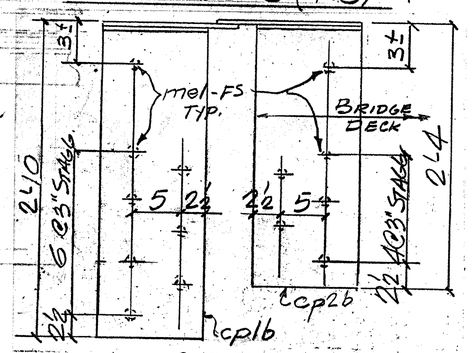PROJECT NO. IM-089-2 (26) STATE BRIDGE NO. 495 & 49N
MATERIAL: AASHTO M270-GR 36 ELECTRODES: PER PROC. HOLES: AS NOTED SHOP BOLTS: 3/4"ϕ H.S.
SURFACE PREP. & PAINT:

GALVANIZED AFTER FAB.

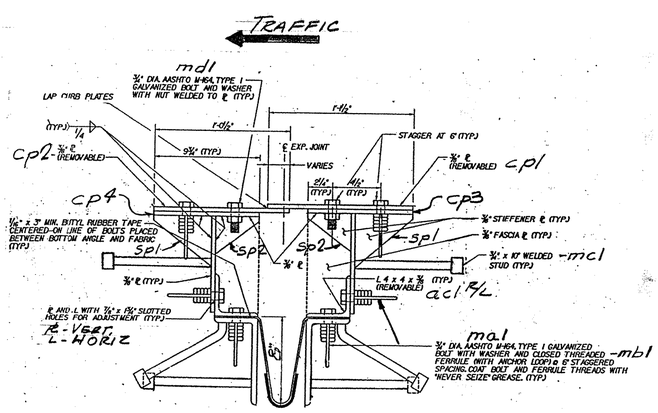DESCRIPTION: EXP. JOINTS - ABUT. 2
JOB: BRIDGES 495 & 49N
I 89 - SB - OVER TH 7
MIDDLESEX - BOLTON, VT.

CUSTOMER: WINTERSET INC.

| | DRAWN BY | DATE |
|---|---|---|
| | JPF | 1-01 |
| | CHKD BY | |
| | APPROV BY | |
| | Q.A. | |
| JOB NO. | DRG. NO. | |
| 126-495N | J1A | |
| | REV. | A |

**CASCO BAY STEEL STRUCTURES, INC.**
75 SPRING HILL ROAD SACO, MAINE 04072
PHONE (207) 282-7360 FAX. (207) 282-1179

511 BS49