JOB NO.	DRG. NO.
127-505	J1A

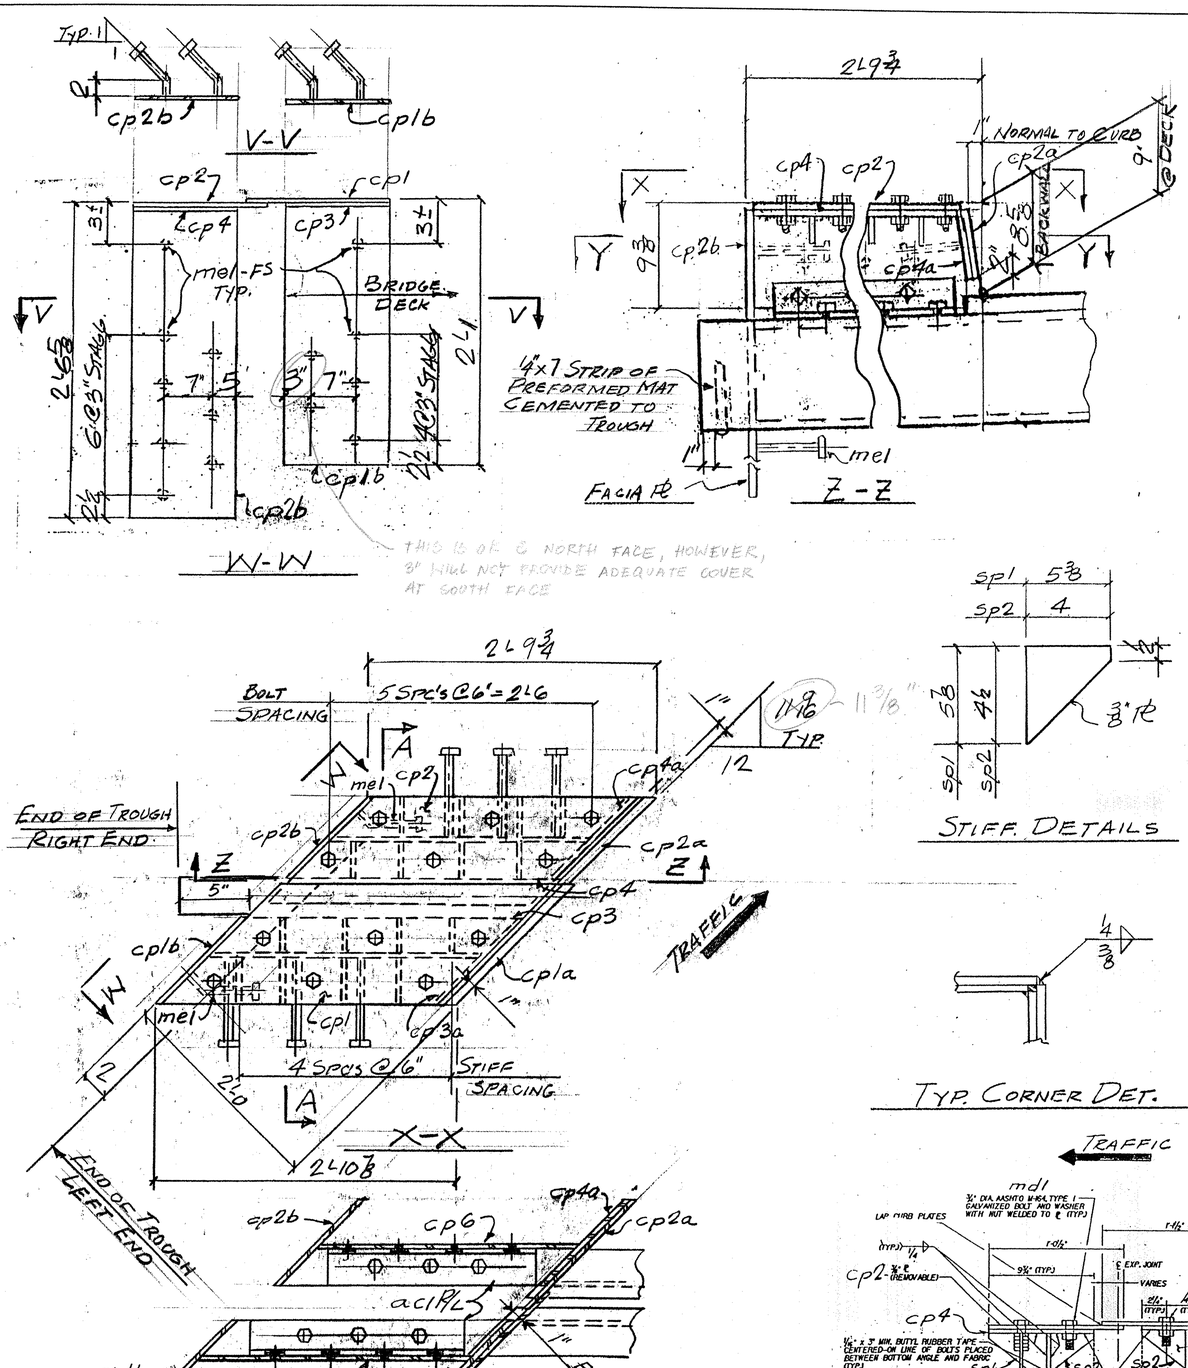

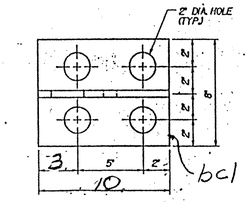

BRACKET PLAN

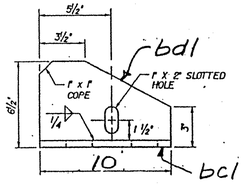

BRACKET ELEVATION

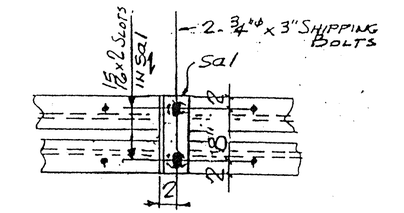

SHIPPING DEVICE
SPACED 5'-0" O.C. MAX. (9 REQ'D)

STIFF. DETAILS

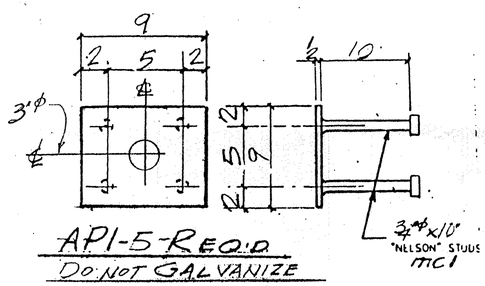

API-5 REQ'D
DO NOT GALVANIZE

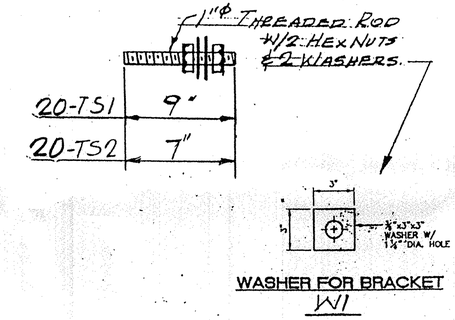

WASHER FOR BRACKET
W1

WORK THIS DWG. W/ DWG. J1

Y-Y (TROUGH NOT SHOWN)
LEFT END BRUSH CURB SHOWN
RIGHT END - OPP HAND

TYP. CORNER DET.

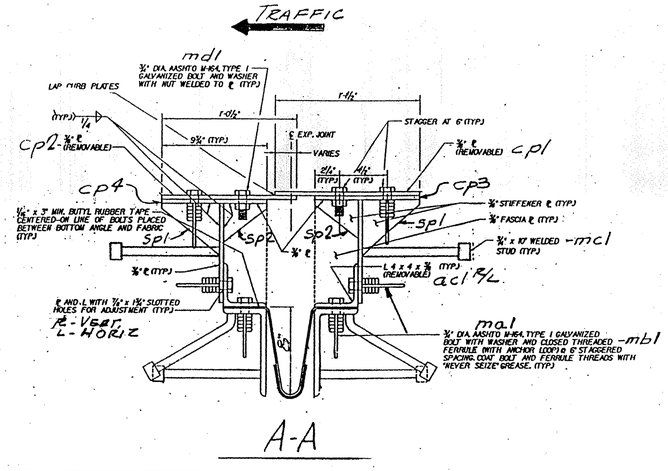

A-A

TVGA
Engineering, Surveying, P.C.

☐ NO EXCEPTIONS TAKEN ☐ REJECTED
☒ FURNISH AS CORRECTED
☐ REVISE AND RESUBMIT

ENGINEER has reviewed Shop Drawings and Samples and other data which Contractor is required to submit, only for conformance with the information given in the Contract Documents and compatibility with the design concept of the completed Project as a functioning whole as indicated in the Contract Documents. Such review does not extend to means, methods, techniques, sequences or procedures of construction or to safety precautions and programs incident thereto. Contractor is responsible for dimensions to be confirmed and correlated at the job site; for information that pertains solely to the fabrication processes or to techniques of construction and for coordination of the work of all trades.

BY: Peter W. Gale
DATE: 4/9/01

REV.	REMARKS	DATE	DWN	CHK	APP	Q.A.	NO.	DIA.	LGT	TYPE	WASHER
	OUT FOR APPROVAL	2-2-01									
	OUT FOR APPROVAL										
	ISSUED TO SHOP										
	FIELD & OFFICE										

PROJECT NO. IM-089-2(26) STATE BRIDGE NO. 505
MATERIAL AASHTO M270 GR 36 ELECTRODES: E70 PROC HOLES: AS NOTED SHOP BOLTS:
SURFACE PREP. & PAINT:

GALVANIZED AFTER FAB

DESCRIPTION: EXP. JOINT-ABUT.
JOB: BRIDGE 505
I 89 OVER U.S. ROUTE 2
MIDDLESEX-BOLTON VT
CUSTOMER: WINTERSET INC.

	DRAWN BY	DATE
	JPF	1-01
CHKD BY		
APPROV BY		
Q.A.		

CASCO BAY STEEL STRUCTURES, INC.
75 SPRING HILL ROAD SACO, MAINE 04072
PHONE (207) 282-7360 FAX. (207) 282-1179

JOB NO.	DRG. NO.
127-505	J1A
REV.	△

531 BS 505