ABM INFO PAGE	LINE	NO.	DESCRIPTION	FT	IN	ASSEM. MARK	SHIPPING MARK	REMARKS	WEIGHT
		1	DOWNSPOUT	5	11 ±		D50N		—
		1	PL 3/8 x 8 x 3/8	6	4 ±	+1		ASTM A500 OR A501	
		2	PL 3/8 x 7 1/4	1	1 3/8	hp1		BEND	
		1	PL 3/8 x 11 1/4	1	1	hp2			
		1	PL 3/8 x 3		11 1/4	hp3			
		1	L 6 x 4 x 1/2		3	k1			
		2	BAR 3 x 1/2	2	6 ±		SA1	BEND	
		2	DO	1	4		SB1		
		4	5/8" THREADED ROD		9		TS1	PER SUBSET 7/408	
		8	5/8" HEX NUTS						
		8	5/8" WASHERS						
		4	EPOXY GROUT					HILTI INC HIT HY-150 SYSTEM	

JOB NO. 127-50N

DRG. NO. DS2

PAY ITEM 506.60

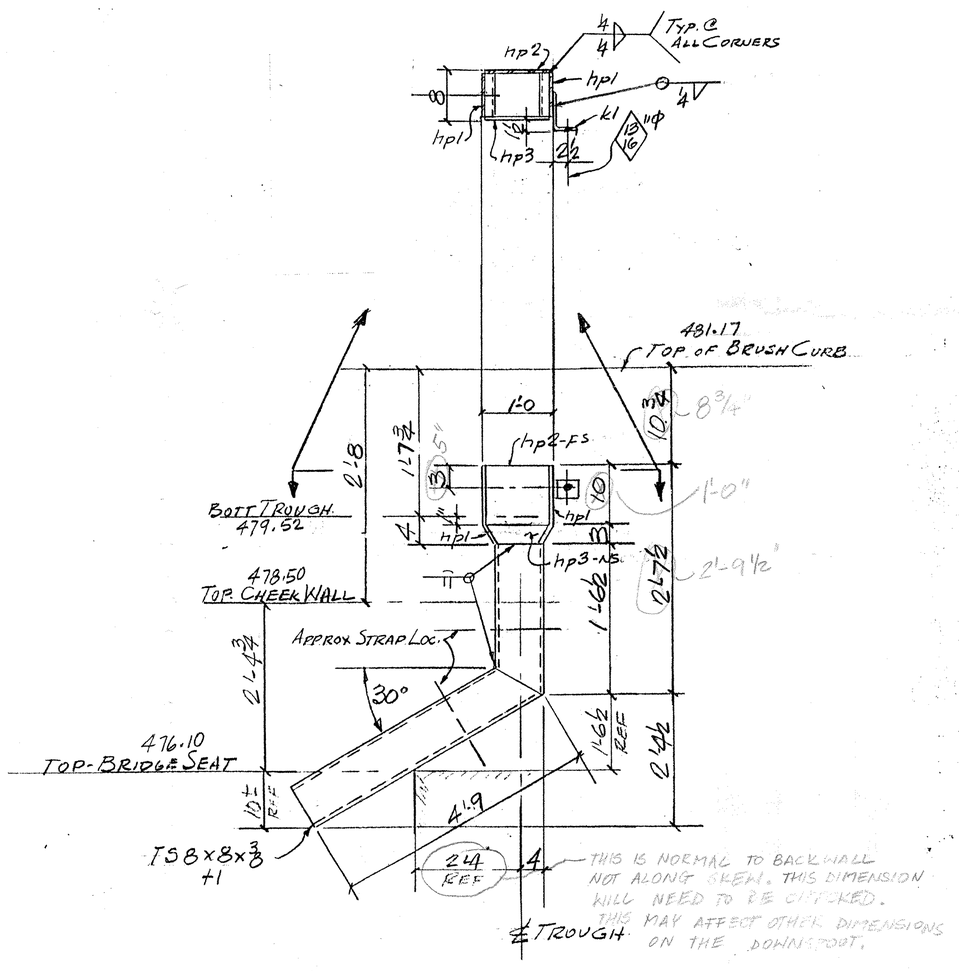

D50N-ONE REQ'D

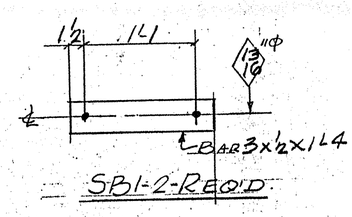

SB1-2-REQ'D

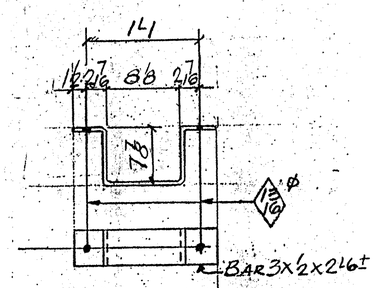

SA1-2-REQ'D

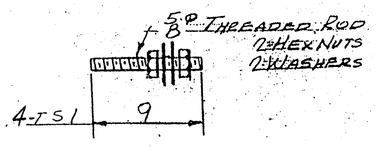

TVGA
Engineering, Surveying, P.C.

☐ NO EXCEPTIONS TAKEN ☐ REJECTED
☒ FURNISH AS CORRECTED
☐ REVISE AND RESUBMIT

ENGINEER has reviewed Shop Drawings and Samples and other data which Contractor is required to submit, only for conformance with the information given in the Contract Documents and compatibility with the design concept of the completed Project as a functioning whole as indicated in the Contract Documents. Such review does not extend to means, methods, techniques, sequences or procedures of construction or to safety precautions and programs incident thereto. Contractor is responsible for dimensions to be confirmed and correlated at the job site; for information that pertains solely to the fabrication processes or to techniques of construction; and for coordination of the work of all trades.

BY: Peter W. Sze
DATE: 4/9/01

REV.	REMARKS	DATE	DWN	CHK	APP.	Q.A.	NO.	DIA.	LGT	TYPE	WASHER
OUT FOR APPROVAL		2-2-01									
OUT FOR APPROVAL											
ISSUED TO SHOP											
FIELD & OFFICE											

PROJECT NO. IM-089-2(26) STATE BRIDGE NO. 50N
MATERIAL: AASHTO M270-Gr36 ELECTRODES: PER PROC. HOLES: AS NOTED SHOP BOLTS:
SURFACE PREP. & PAINT:
GALVANIZED AFTER FAB.

DESCRIPTION: DOWNSPOUTS - ABUT. 2.
JOB: BRIDGE 50N
I 89 OVER U.S. ROUTE 2
MIDDLESEX-BOLTON VT

	DRAWN BY	DATE
	JPF	2-01
	CHKD BY	
	EJ	
	APPROV BY	
	Q.A.	
CUSTOMER: WINTERSET INC.	JOB NO.	DRG. NO.
	127-50N	DS2
	REV	A

CASCO BAY STEEL STRUCTURES, INC.
75 SPRING HILL ROAD SACO, MAINE 04072
PHONE (207) 282-7360 FAX (207) 282-1179

535