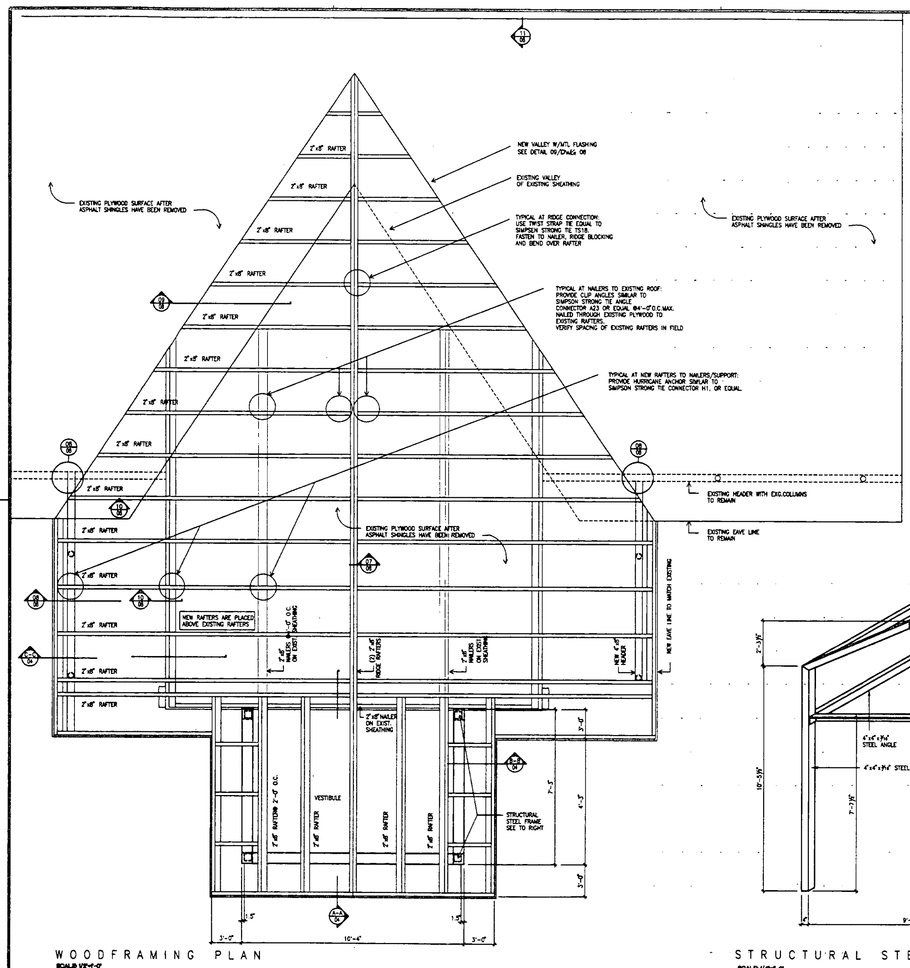

WOODFRAMING PLAN

SCALE: 1/4"=1'-0"

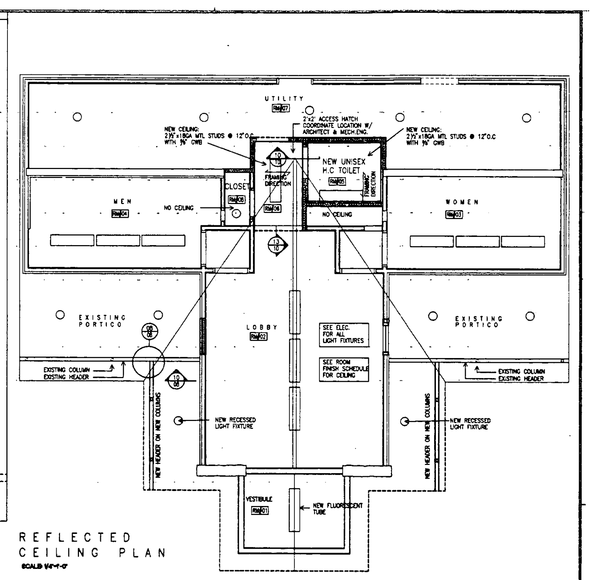

REFLECTED CEILING PLAN

SCALE: 1/4"=1'-0"

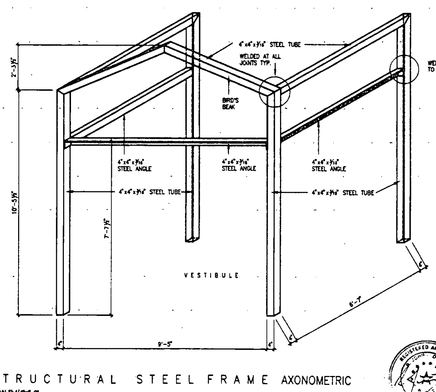

STRUCTURAL STEEL FRAME AXONOMETRIC

SCALE: 1/4"=1'-0"

STATE OF VERMONT
DEPARTMENT OF STATE BUILDINGS
AGENCY OF ADMINISTRATION
MONTPELIER, VERMONT

REST AREA REHABILITATION
LYNDON I-91 SOUTHBOUND
WOODFRAME/REFLEC.CEILING PLAN

DATE: JUNE 6, 1995	SCALE: AS NOTED	REVISIONS:	DRAWING NO: 05
DRAWN BY: BLU APPROVED BY: JBA	PROJECT NO: IM-B1D(12)		SHEET 8 OF 29