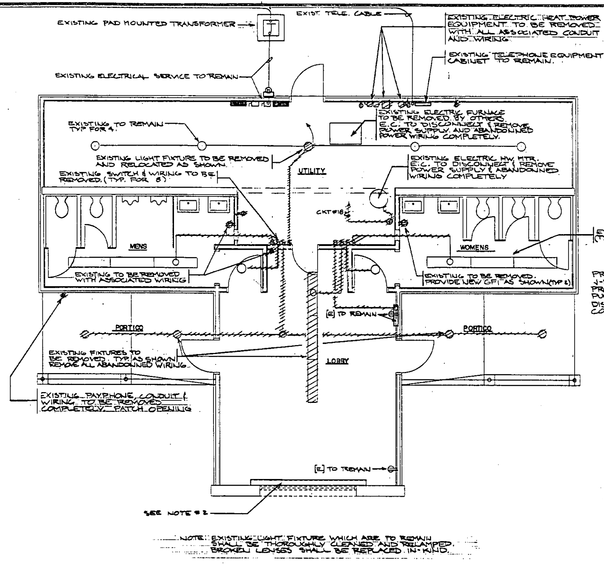

ELECTRICAL FLOOR PLAN - EXISTING CONDITIONS

SCALE: 1/4" = 1'-0"

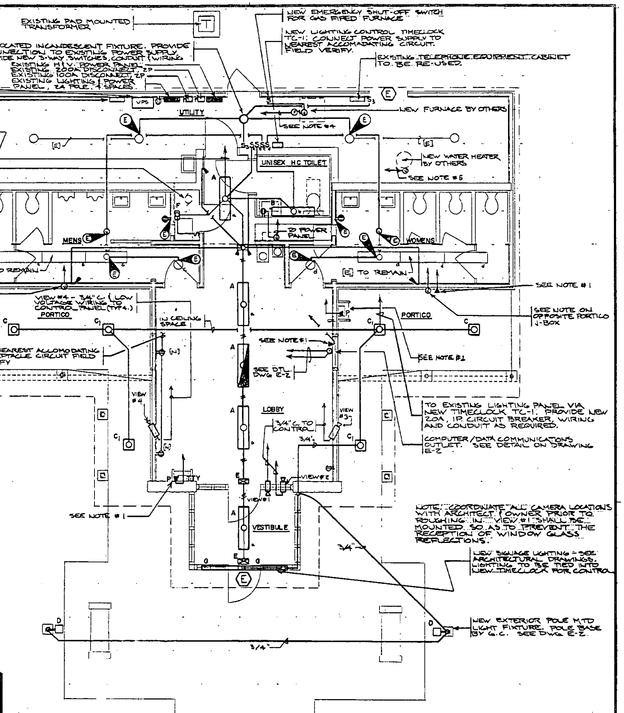

ELECTRICAL FLOOR PLAN - RENOVATIONS

SCALE: 1/4" = 1'-0"

NOTES:

1. THE ELECTRICAL CONTRACTOR SHALL COORDINATE WITH THE OWNER BEFORE INSTALLING TELEPHONE OUTLET BOXES AND CONDUIT TO DETERMINE THE EXACT HEIGHT REQUIREMENTS OF EACH TELEPHONE OUTLET BOX. THESE HEIGHTS MAY VARY DEPENDING ON THE ACTUAL EQUIPMENT PURCHASED BY THE OWNER AND THE INDIVIDUAL TYPE AND ADA REQUIREMENTS OF EACH PHONE LOCATION. THE OWNER SHALL INFORM THE ELECTRICAL CONTRACTOR IN A TIMELY MANNER TO AVOID ANY NOAE DISPUTES OR DELAYS AS TO THE EXACT CHARACTERISTICS OF THE EQUIPMENT TO BE USED.
2. THE ELECTRICAL CONTRACTOR SHALL DISCONNECT OWN ELECTRIC BASE-BOARD HEATER IN THE LOBBY AREA.

   ELECTRICAL CONTRACTOR SHALL REMOVE ALL ABANDONED WIRING AND CONDUIT TO THESE UNITS WHEREVER POSSIBLE. FIELD VERIFY. SEE DRAWING EV-1 FOR ELECTRIC HEATER LOCATION. ELECTRIC HEAT IN EXISTING MENS AND WOMENS ROOMS TO REMAIN IN PLACE. THE HEATING CONTRACTOR SHALL BE RESPONSIBLE FOR THE REMOVAL OF THE DISCONNECTED ELECTRIC BASEBOARD RADIATOR.
3. ALL NEW AND RELOCATED CONDUIT AND WIRING SHALL BE RUN CONCEALED. WHEN NOT POSSIBLE, COORDINATE WITH THE ARCHITECT AND ENGINEER BEFORE INSTALLATION.
4. PROVIDE POWER WIRING, CONDUIT AND CONNECTION TO NEW GAS FIRED FURNACE. PROVIDE NEW 20AMP SINGLE POLE BREAKER IN PANEL IN ABANDONED ELECTRIC FURNACE BREAKER POSITION. PROVIDE WIRING AND CONDUIT TO SERVICE NEW FURNACE, CONTROL POWER SUPPLY, AND NEW WALL MOUNTED TEMPERATURE CONTROL TIMECLOCK. POWER WIRING ONLY. ALL TEMPERATURE CONTROL WIRING BY HV CONTRACTOR. SEE SPEC.
5. PROVIDE POWER WIRING, CONDUIT AND CONNECTION TO NEW GAS FIRED HOT WATER HEATER. PROVIDE NEW 20AMP SINGLE POLE BREAKER IN PANEL ABANDONED ELECTRIC HOT WATER HEATER BREAKER POSITION. SEE SPEC.
6. THE ELECTRICAL CONTRACTOR SHALL, AT THE COMPLETION OF ALL WORK, VERIFY ALL CONNECTED LOADS TO POWER AND LIGHTING PANELS AS TO THE CIRCUIT BREAKER NUMBERS AND FILL OUT A NEW, ACCURATE PANEL SCHEDULE FOR EACH PANEL WHICH HAS BEEN AFFECTED BY THE WORK UNDER THIS CONTRACT.

STATE OF VERMONT
DEPARTMENT OF STATE BUILDINGS
AGENCY OF ADMINISTRATION
MONTPELIER, VERMONT

REST AREA REHABILITATION JM-BLD6(2)
LYNDON I-91 SOUTHBOUND
ELECTRICAL-FLOOR PLAN- EXISTING CONDITIONS & RENOVATIONS

DATE: 6-9-95	SCALE: 1/4"=1'-0"	REVISIONS:	DRAWING NO: E-1
DRAWN BY: DN	APPROVED BY: DAN	DRAWING NAME: ELECTRICAL	SHEET 16 OF 29