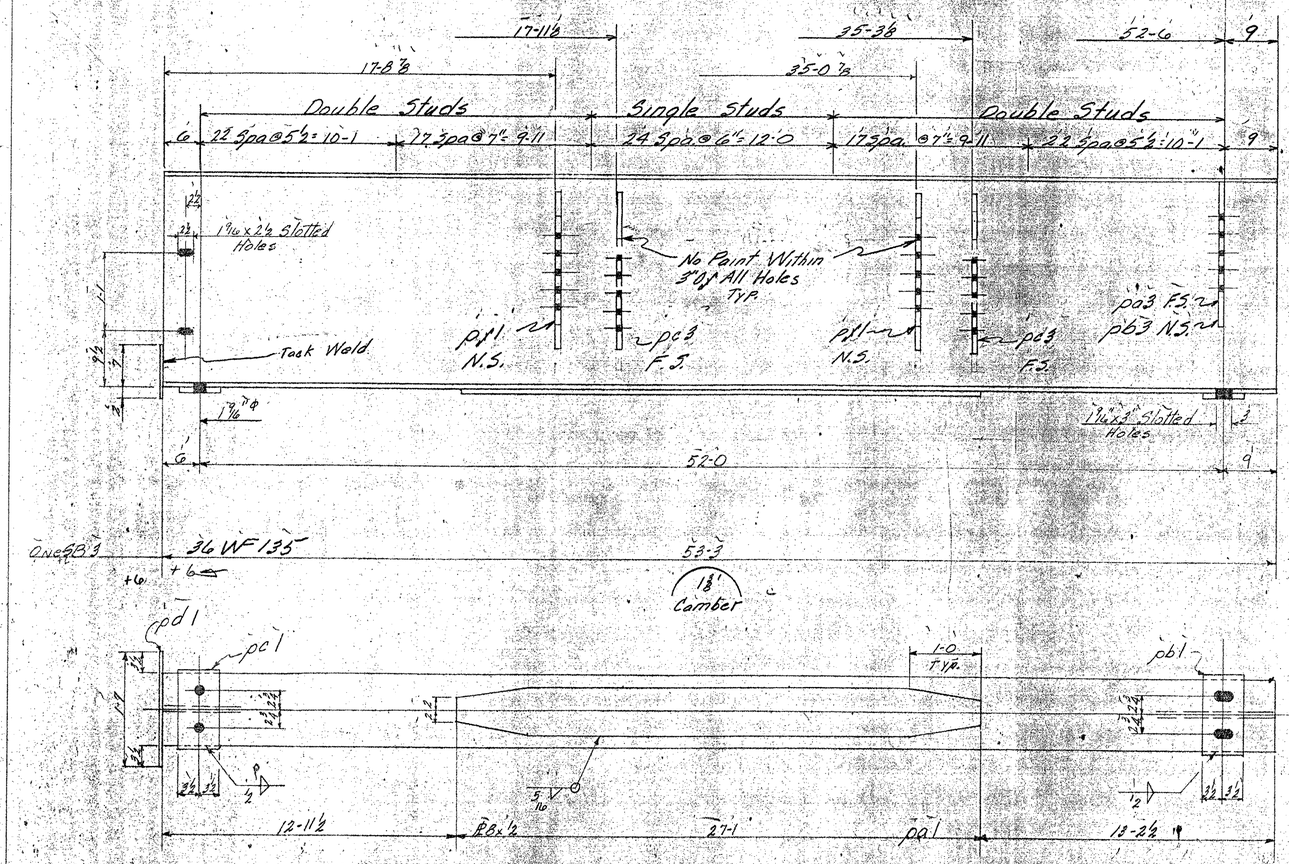

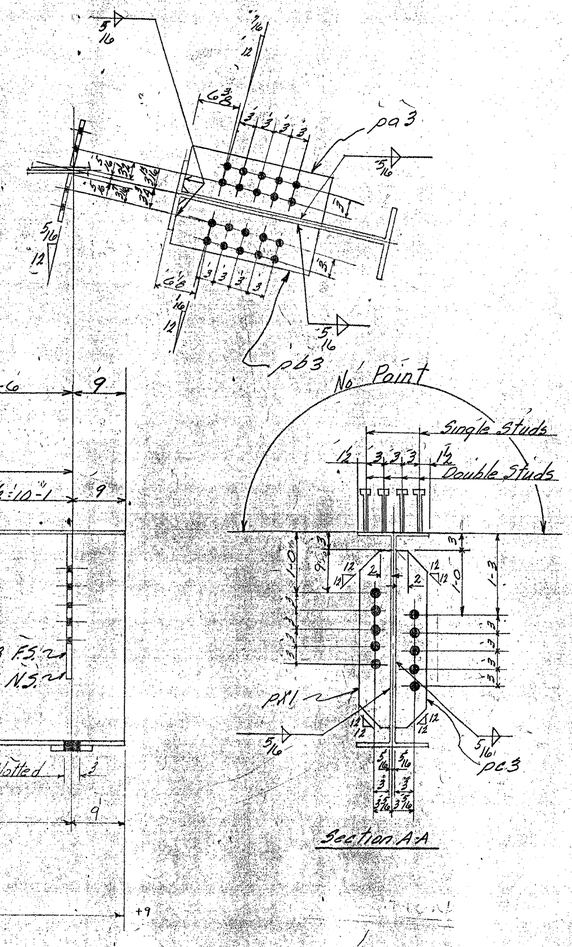

BRIDGE SHEET BR467
REFERENCE SHEET 13 OF 37
SHEET 219 OF 370

BILL OF MATERIAL

NO. PIECES	MARK	DESCRIPTION	LENGTH FT.	LENGTH IN.		WEIGHT	

JOB NO. _____ SHEET NO. _____

BILL OF MATERIAL

(17)

ASTM-A36

NO. PIECES	MARK	DESCRIPTION	LENGTH FT.	LENGTH IN.		WEIGHT	
		Beams					
1	SB3	36 WF 135	53	3	ord. BB6682	7189	✓
1	pa1	Bar 8 x 1/2	27	1	BB6679	368	✓
1	pb1	Bar 7 x 1	1	1	Ras @ 20-0		
1	pc1	do	1	1		52	✓
1	pd1	PL 9 x 1/4	1	7	Ras PL 48 x 4 x 10-0	13	✓
1	pa3	Bar 8 x 1/2	2	0	ord @ 20-0		
1	pb3	do	2	0	BB6679	54	✓
2	pc3	Bar 5 x 1/2	2	6	Ras @ 20-0		
2	pd1	do	2	6		85	✓
		1/2" Weld	2	4		2	✓
		5/16" Weld	84	9		~~31~~ 21	✓
						~~7794~~ 7784	
		Cont # 66-1184-226					
366		3/4" ø Shear Studs	0	7	STK	368	✓
						8162	✓

VERMONT STRUCTURAL STEEL CORPORATION
BURLINGTON, VT.

Proj. No. 167-3(35) #2

		DATE
DRAWN BY	LG	11-8-66
OK'D BY	RLM	11-18-66

HOLES 13/16" Ø As Noted
BOLTS None
PAINT Red Lead
VT. SPEC. (As Noted)

PROJECT I89 Over Approach Road
LOCATION Georgia-Fairfax-Fairfield-St. Albans
CUSTOMER Lane Const. Co.
ARCHITECT State of Vt. Dept. of Hwys.
JOB NO. 66-1184-206 66-1184-226
SHEET NO. 3 STR. 37 Shear Studs

PRINT RECORD		
NO.	FOR	DATE
3	APP	11-21
2	SHOP	11-21
2	Shop	12-5
2	STATE	12-8
2	LANG	12-28