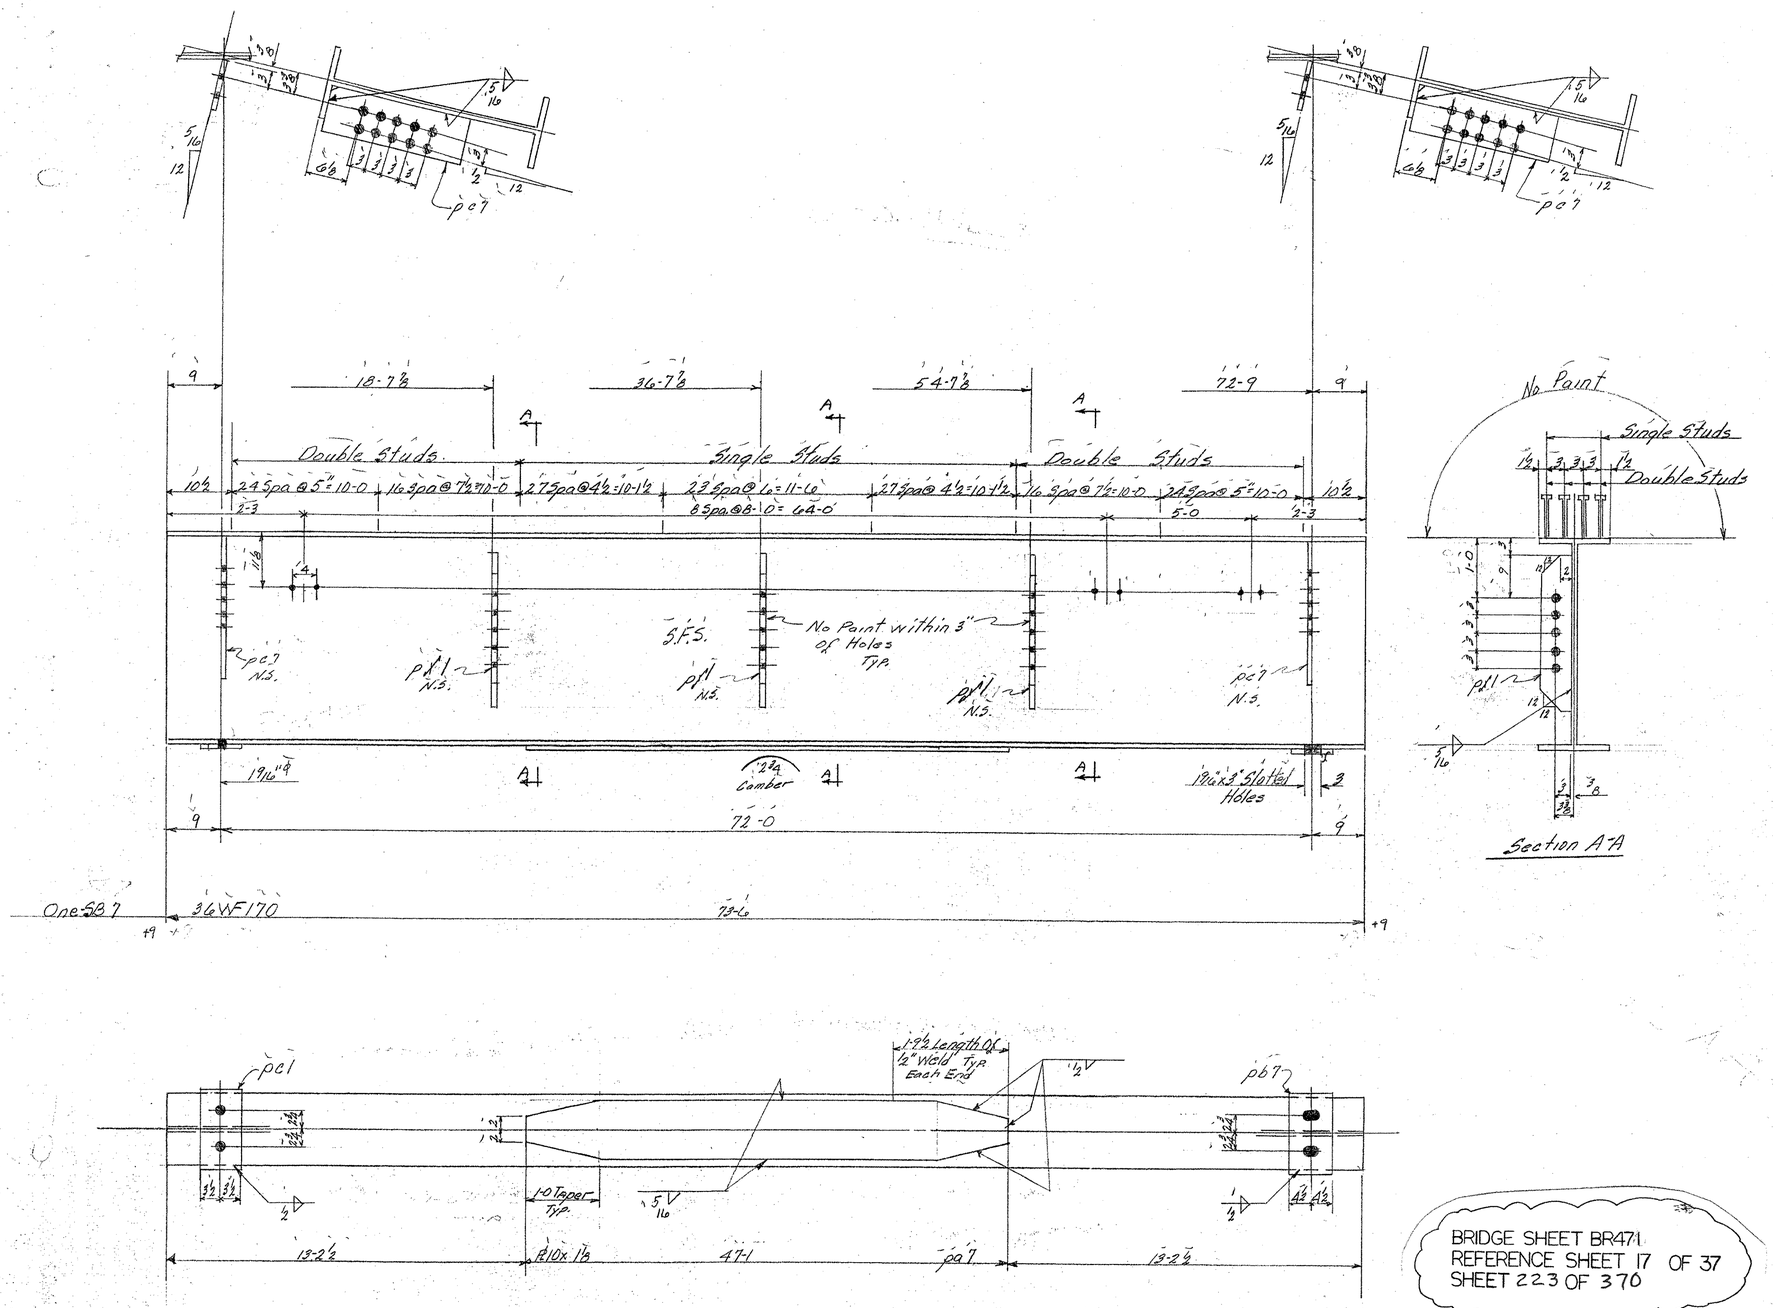

BRIDGE SHEET BR47.1
REFERENCE SHEET 17 OF 37
SHEET 223 OF 370

BILL OF MATERIAL

	NO. PIECES	MARK	DESCRIPTION	LENGTH FT.	LENGTH IN.		WEIGHT	
			21933					

JOB NO. ..... SHEET NO. .....

ASTM-A36

BILL OF MATERIAL

	NO. PIECES	MARK	DESCRIPTION	LENGTH FT.	LENGTH IN.		WEIGHT	
			Beams					
	1	SB7	36WF170	73	6	ord. BRIDGE	12,495	✓
	1	pa1	Bar 7x1	1	1	Reg @ 20-0	26	✓
	1	pa7	P10x1 1/2	47	1	BRIDGE	1832	✓
	1	pb7	P8x1 1/2	1	1	BRIDGE Fastening	53	✓
	2	pd7	Bar 8x1/2	2	0	OTHER 20-0 BRIDGE	54	✓
	3	pf1	Bar 5x1/2	2	6	Reg @ 20-0	64	✓
			1/2" Weld	11	0		~~9~~ 7	
			5/16" Weld	103	0		~~40~~ 28	
			Cont # 66-1184-2216				~~12,559~~ ~~14,573~~	
	480		3/4" Shear Studs	0	7	STK	482	482 ✓
								15,055 ✓

VERMONT STRUCTURAL STEEL CORPORATION
BURLINGTON, VT.

Proj. No. I89-3(35)#2

		DATE
DRAWN BY	L.C.	11-11-66
OK'D BY	RLM	11-18-66

HOLES 15/16" ϕ As Noted
BOLTS None
PAINT Red Lead Vt. Spec. (As Noted)

PROJECT I89-Over Approach Road
LOCATION Georgia-Fairfax-Fairfield-St. Albans
CUSTOMER Lane Constr. Co.
ARCHITECT State of Vt. Dept. of Highways
JOB NO. 66-1184-200 STK. ST. SHEET NO. 7
66-1184-2216 Shear Studs

PRINT RECORD		
NO.	FOR	DATE
3	APP	11-21
2 P	SHOP	11-21
2 ①	Shop	12-5
2	STATE	12-8
2	LANE	12-28