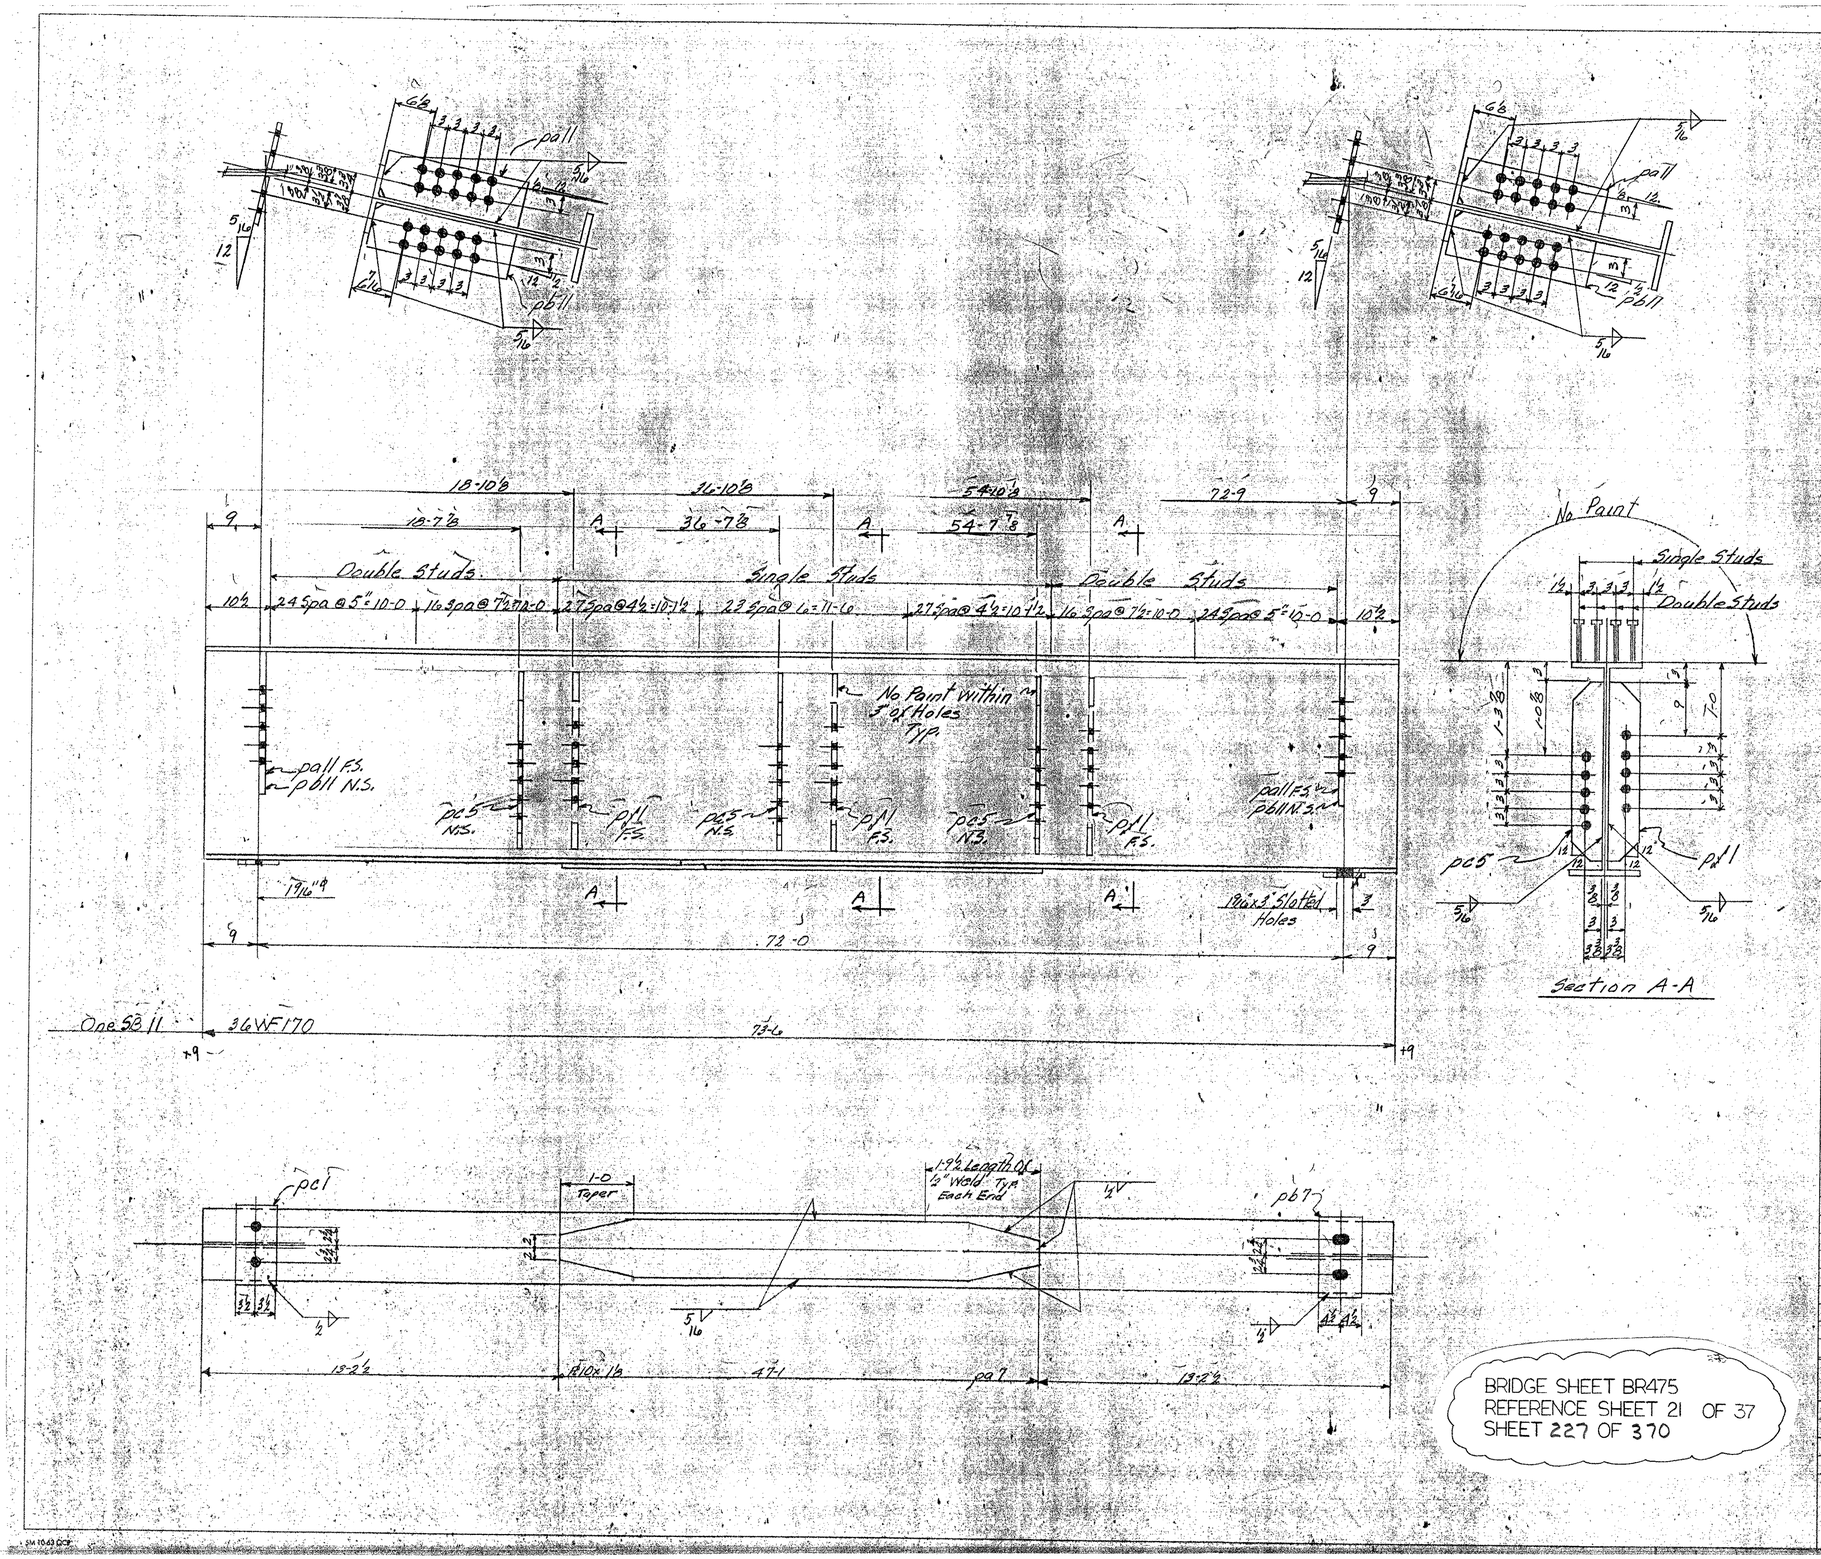

BILL OF MATERIAL

NO. PIECES	MARK	DESCRIPTION	LENGTH FT.	LENGTH IN.		WEIGHT

JOB NO. SHEET NO.

(17.)

ASTM-A36

BILL OF MATERIAL

NO. PIECES	MARK	DESCRIPTION	LENGTH FT.	LENGTH IN.		WEIGHT
		Beams				
1	SB11	36WF170	73	6	BEGLAZ	12,495
1	pa1	Bar 7x1	7	1	RES@10-0	36
1	pa7	R10x16	47	7	BEGLAZ	1832
1	pb7	R9x12	7	1	FOS INC. @ END OVERSIZE-0. BEGLAZ	53
2	pa11	Bar 8x½	2	0	RES@20-0. BEGLAZ	
2	pb11	do	2	0		109
3	pc1	Bar 5x½	2	6	RES@20-0	
3	pc5	do	2	6		128
		½" Weld	11	0		9
		5/16" Weld	137	0		49
		Coat # 66-1189-226				14,684
480		¾" Shear Studs	0	7	STK	482
						15,183

VERMONT STRUCTURAL STEEL CORPORATION
BURLINGTON, VT.

Proj I89-3(35)42

		DATE
DRAWN BY	L.C.	11-11-66
CK'D BY	RLM	11-18-66

HOLES 15/16" ⌀ As Noted
BOLTS None
PAINT Red Lead Vt. Specs. As Noted

PROJECT I89-Over Approach Road
LOCATION Georgia-Fairfax-Fairfield-St Albans
CUSTOMER Lane Constr. Co.
ARCHITECT State of Vt. Dept of Highways
JOB NO. 66-1189-200 66-1189-226 SHEET NO. 11 STR. STL. Shear Studs

PRINT RECORD		
NO.	FOR	DATE
1	KP	1-67
2	Shop	1-67
30	Shop	1-67
2	STATE	1-67
2	LANE	1-67

BRIDGE SHEET BR475
REFERENCE SHEET 21 OF 37
SHEET 227 OF 370

SM 10-63 GCP