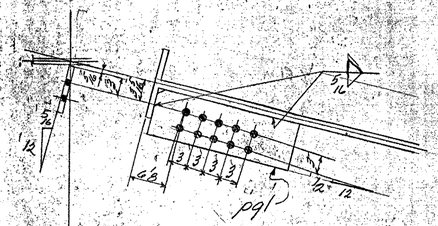

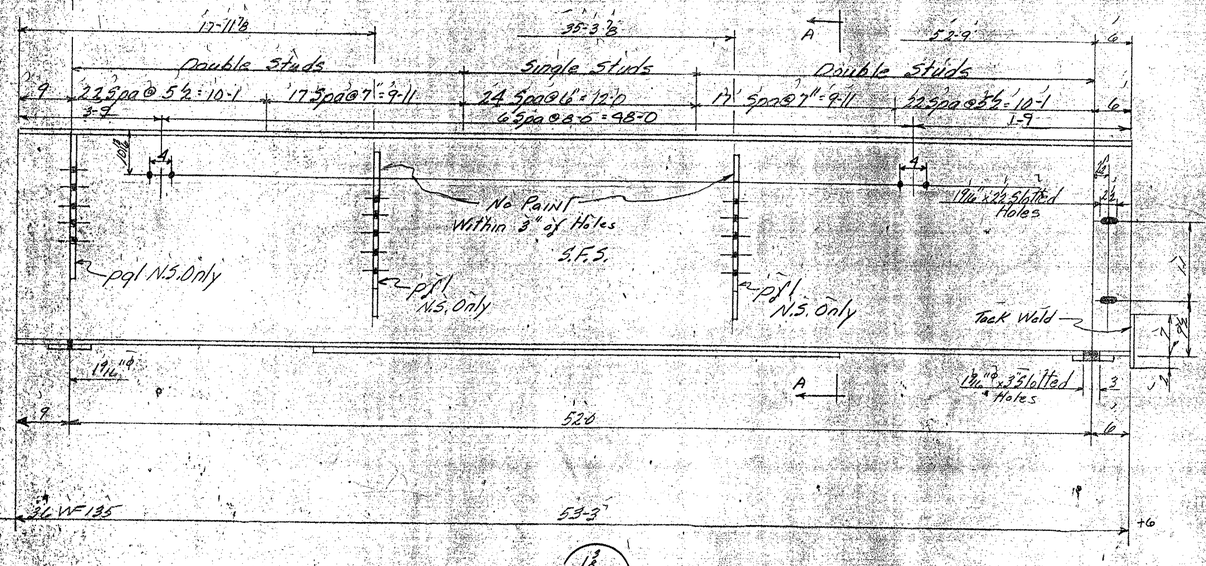

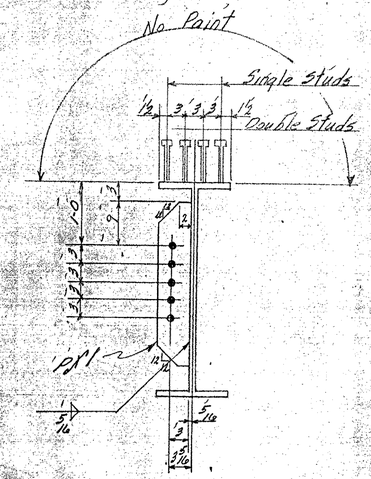

Section AA

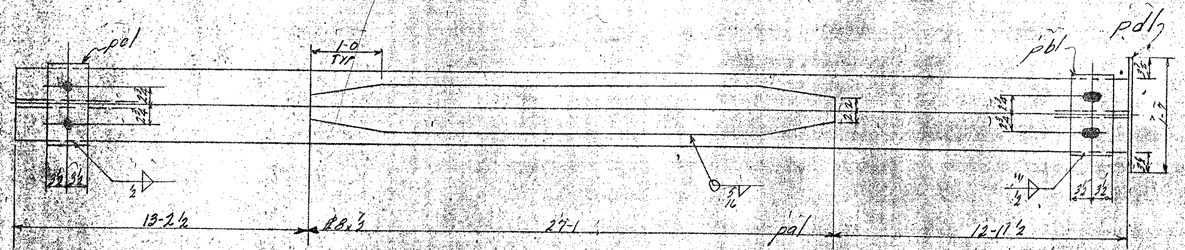

BRIDGE SHEET BR477
REFERENCE SHEET 23 OF 37
SHEET 229 OF 370

BILL OF MATERIAL

NO. PIECES	MARK	DESCRIPTION	LENGTH FT.	LENGTH IN.		WEIGHT	

JOB NO. SHEET NO. (17)

BILL OF MATERIAL

ASTM A36

NO. PIECES	MARK	DESCRIPTION	LENGTH FT	LENGTH IN.		WEIGHT	
		Beam					
1	BB13	36 WF 135	53	3	ord. BB6682	7189	✓
1	pal	Bar 8 x ½	27	1	BB6679	368	✓
1	pbl	Bar 7 x 1	1	1	Res 020-0		
1	pdl	do	1	1		50	✓
1	pdll	R9 x ¼	1	9	Res 020-0 ord. 20-0 BB6679	13	✓
2	pfl	Bar 5 x ½	2	10		43	✓
1	pgl	Bar 8 x ½	2	0		27	✓
		½" x Weld	1	4		24	
		5/16" x Weld	69	10		~~25~~ 17	
						~~7419~~	✓
						7711	
		Cont #66-1184-226					
366		¾" ø Shear Studs	0	7	STK		368 ✓
							8087

VERMONT STRUCTURAL STEEL CORPORATION
BURLINGTON, VT.

Proj No. 189-3(35)#2

		DATE
DRAWN BY	LC	11-10-66
CK'D BY	RLM	11-18-66

HOLES "No" Unless Noted
BOLTS None
PAINT Red Lead VT
Tack (As) Noted

PROJECT I89 Over Approach Road
LOCATION Georgia Fairfax-Fairfield-St Albans
CUSTOMER Lane Const. Co.
ARCHITECT State of Vt Dept. of Highways
JOB NO. 66-1184-200 SHEET NO. 13
66-1184-226 Shear Studs

PRINT RECORD

NO.	FOR	DATE
3	APP	11-21
25	SHOP	11-21
30	SHOP	12-5
2	STATE	12-8
2	LANE	12-23

SM 10-63 OCP