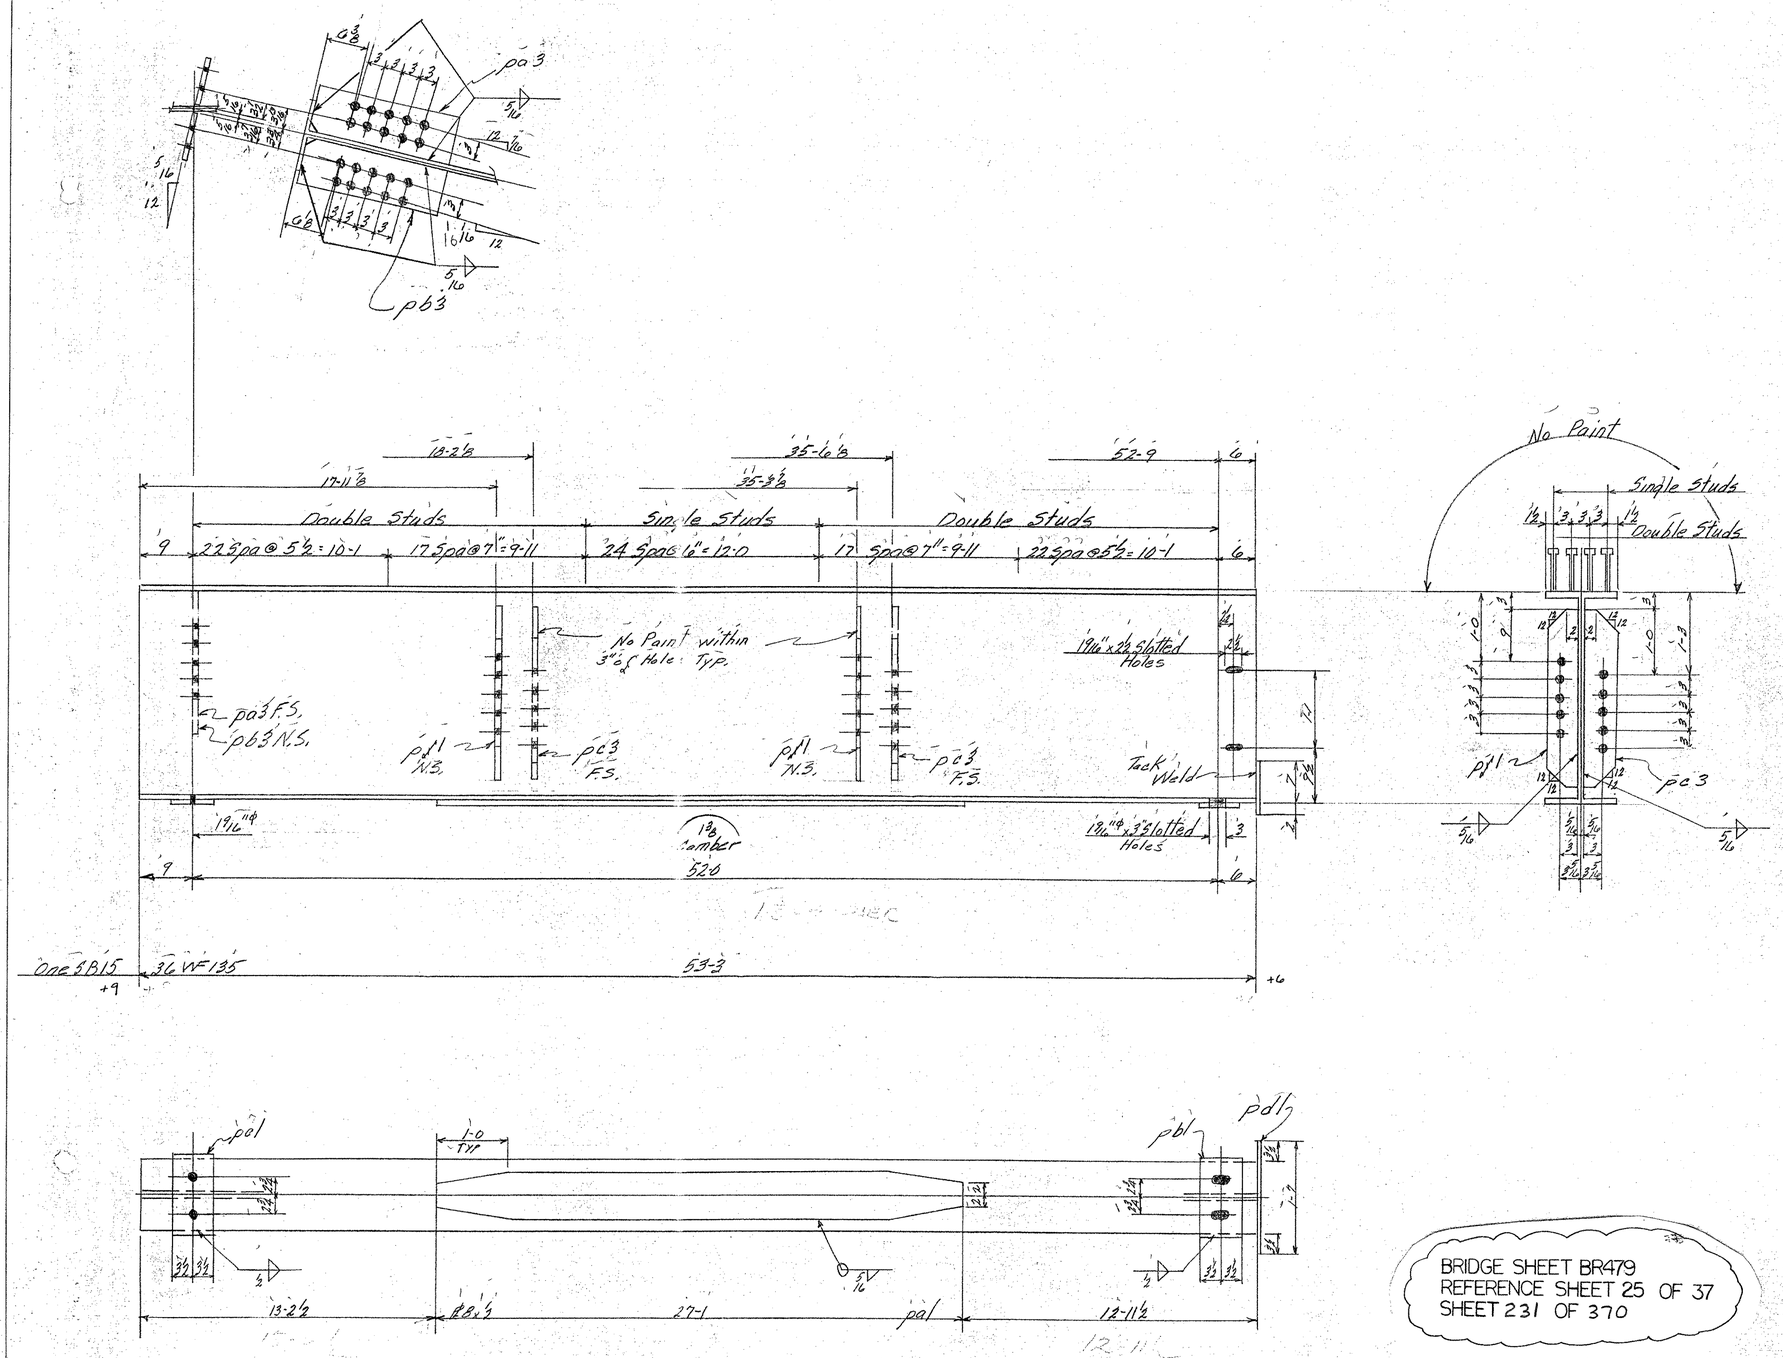

BRIDGE SHEET BR479
REFERENCE SHEET 25 OF 37
SHEET 231 OF 370

BILL OF MATERIAL

NO. PIECES	MARK	DESCRIPTION	LENGTH FT.	LENGTH IN.		WEIGHT	

JOB NO. _____ SHEET NO. _____

ASTM-A36

BILL OF MATERIAL

17 (17)

NO. PIECES	MARK	DESCRIPTION	LENGTH FT.	LENGTH IN.		WEIGHT	
		Beam					
1	SB15	36WF135	53	3	ord. B886B2	7189	✓
1	pa1	Bar 3/8 x 9	27	1	ord. B886-71	368	✓
1	pb1	Bar 7/8	1	1	Ras @ 20-0		
1	pd1	do	1	1		52	✓
1	pd11	PL 9 x 1/4	1	7	Ras PL 9 x 1/4 x 10-0	13	✓
1	pa3	Bar 3 x 1/2	2	0	ord. 20-0		
1	pb3	do	2	0	ord. B886-79	54	✓
2	pa3	Bar 5 x 1/2	2	6	Ras @ 20-0		
2	pd1	do	2	6		85	✓
OMIT							
		1/2" ⌐ Weld	2	4		2	
		5/16" ⌐ Weld	84	9		~~31~~ 21	✓
							~~7794~~
		Cont. # 66-1184-226					7784
	366	3/4" ϕ Shear Studs	0	7	3 ft	368	368 ✓
							8162 ✓

VERMONT STRUCTURAL STEEL CORPORATION
BURLINGTON, VT.

		DATE
DRAWN BY	L.C.	11-11-66
OK'D BY	RLM	11-18-66
HOLES	15/16" ϕ As Noted	
BOLTS	None	
PAINT	Red Lead V.T.	
	Specs. As Noted	

PROJECT I890 over Approach Road
LOCATION Georgia-Fairfax-Fairfield-St. Albans
CUSTOMER Lane Const. Co.
ARCHITECT State of Vt. Dept. of Highways
JOB NO. 66-1184-206 STR. ST. SHEET NO. 15
66-1184-226 Shear Studs

proj. No. IGF 3(35) cont #2

PRINT RECORD

NO.	FOR	DATE
3	APP	11-21
2P	SHOP	11-21
2D	SHOP	12-5
2	STATE	12-8
2	LANE	12-28