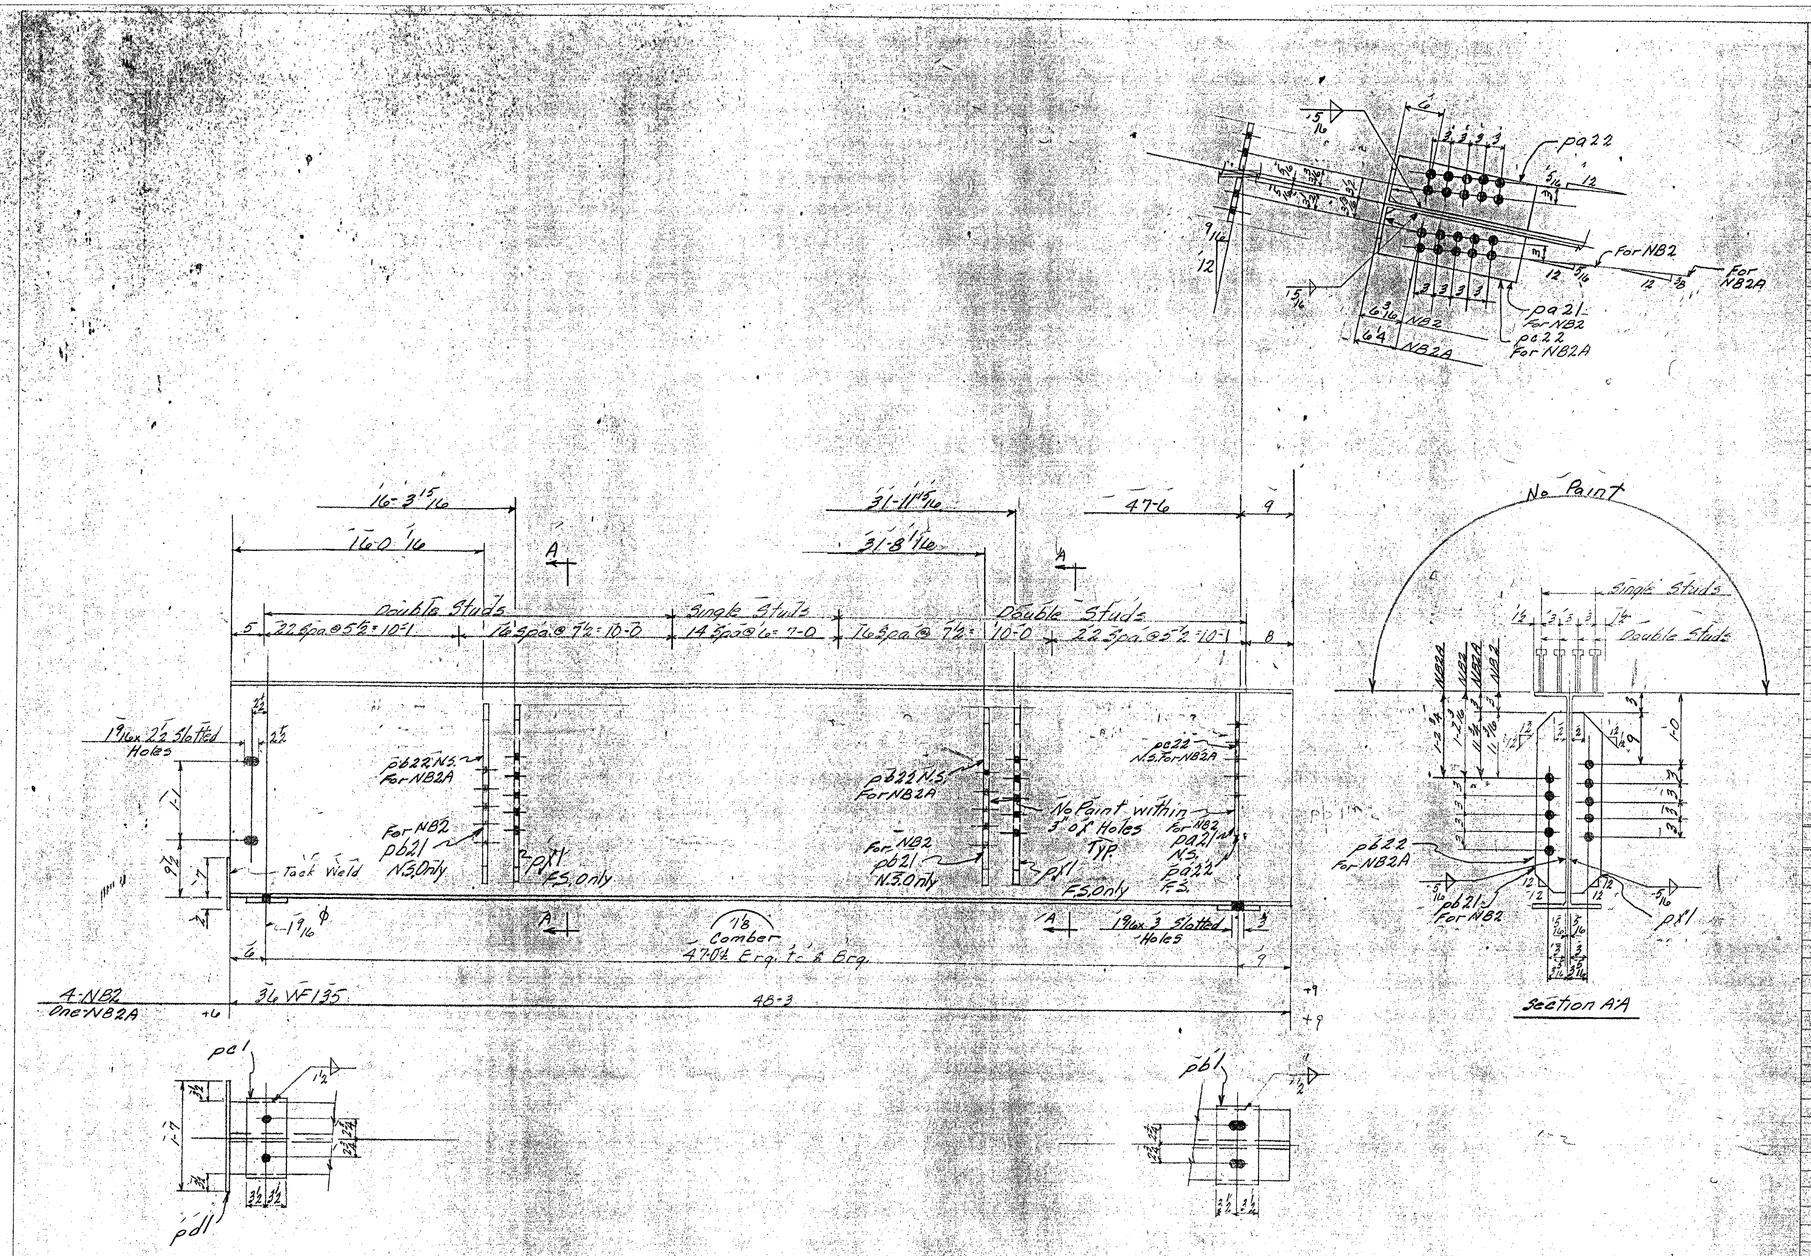

BILL OF MATERIAL

NO. PIECES	MARK	DESCRIPTION	LENGTH FT.	LENGTH IN.		WEIGHT

JOB NO. SHEET NO.

ASTM-A 36

BILL OF MATERIAL (47)

NO. PIECES	MARK	DESCRIPTION	LENGTH FT.	LENGTH IN.		WEIGHT
4	NB2	36 WF135	48	3		
1	NB2A	36 WF135	48	3	ord BB6682	32,569
5	pb1	Bar 7x1	1	1	Reso 20-0	
5	pc1	da	1	1		258
5	pd1	PL 9x¼	1	7	Reso 48x4x10-0 ord@20-0	64
4	pa21	Bar 8x½	2	0	BB6679	109
8	pb21	Bar 5x½	2	6	Reso 20-0	170
5	pa22	Bar 8x½	2	0	ord@20-0 BB6679	136
2	pb22	Bar 3x½	2	6	Reso 20-0	43
11	pa22	Bar 8x½	2	0	ord@20-0 BB6679	27
10	pf1	Bar 5x½	2	6	Reso 20-0	213
		¼" Weld	11	8		~~70~~ 7
		5/16" Weld	150	0		~~51~~ 37
						~~33,453~~
						33,633
		Cont 66-1184-226				
1690		3/4"ø Shear Studs	6	7	Stk	1698 1698
						35,331

VERMONT STRUCTURAL STEEL CORPORATION
BURLINGTON, VT.

Proj "I89-3(35)#2

		DATE
DRAWN BY	J.C.	11-22-66
OK'D BY	R.L.M.	11-29-66

NOTES: 1/16" (as Note 3)
BOLTS: None
PAINT: Red Lead Vt. Specs (as Noted)

PROJECT: I 89 Over Approach Road
LOCATION: Georgia-Fairfax-Fairfield St. Albans
CUSTOMER: Lane Constr. Co.
ARCHITECT: State of Vt. Dept. of Highways
JOB NO. 66-1184-200 St-St SHEET NO. 22
66-1184-226-Shear Studs

PRINT RECORD		
NO.	FOR	DATE
3	APP.	11-29
2	SHOP	11-27
1	Shop	12-5
2	STATE	12-8
2	LANE	12-19

BRIDGE SHEET BR484
REFERENCE SHEET 30 OF 37
SHEET 236 OF 370

SM 10-63 QCP