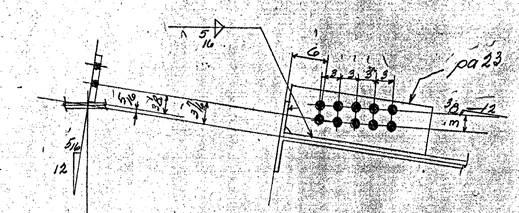

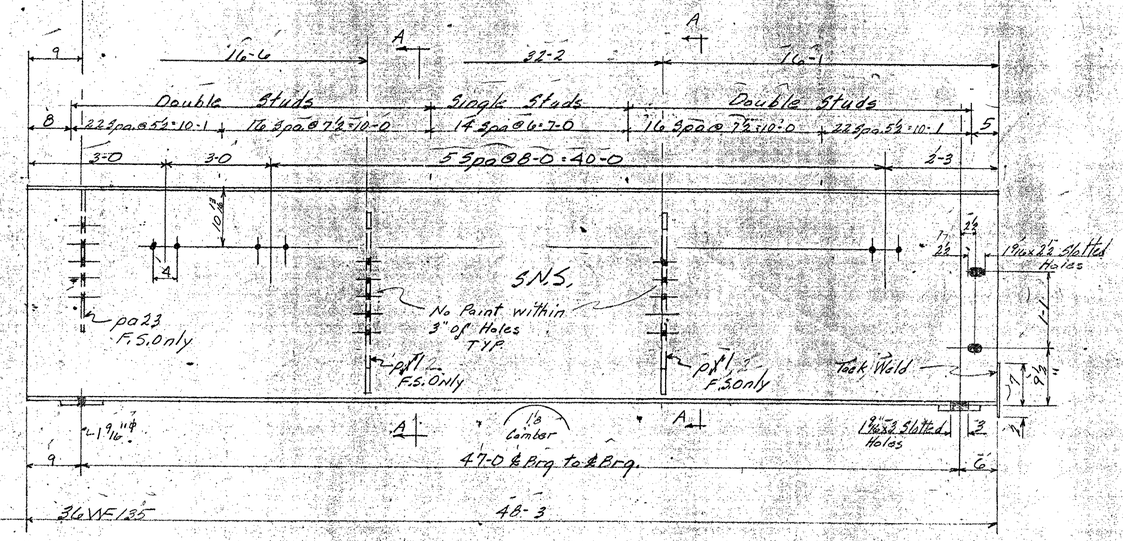

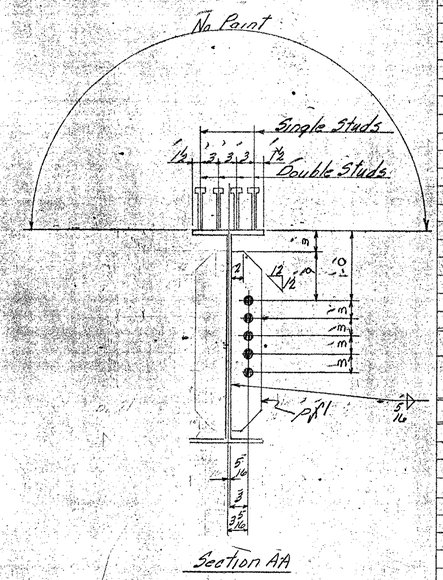

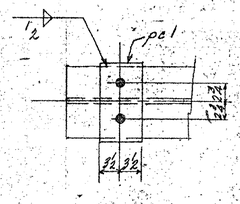

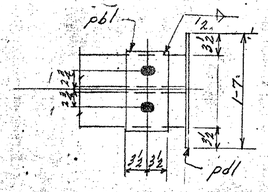

BRIDGE SHEET BR491
REFERENCE SHEET 37 OF 37
SHEET 243 OF 370

BILL OF MATERIAL

NO. PIECES	MARK	DESCRIPTION	LENGTH FT.	LENGTH IN.		WEIGHT	

JOB NO. _____ SHEET NO. _____

ASTM-A36

BILL OF MATERIAL

(47)

NO. PIECES	MARK	DESCRIPTION	LENGTH FT.	LENGTH IN.		WEIGHT	
1	NB9	Beam 36WF135	48	3	ord B816682	6514	✓
1	pd1	Bar 7x1	1	1	Res 020-0		
1	pd1	do	1	1		52	✓
1	pd1	PL 9x¼	1	7	Res B42-4x10-0 ord B20-0	13	✓
1	pa23	Bar 8x½	2	0	B816639	27	✓
2	pd1	Bar 5x½	2	6	Res 020-0	43	✓
		½" ∫ Weld	2	4		24	
		5/16" ∫ Weld	15	0		54	
							6656 ✓
							6655
		Cont. 66-1184-2266					
33B		¾" Shear Studs	0	7	STK	340	340 ✓
							6996 ✓

VERMONT STRUCTURAL STEEL CORPORATION
BURLINGTON, VT.

Proj. No. 189-3(35) #2

		DATE
DRAWN BY	AC	11-22-66
OK'D BY	PLM	11-29-66

HOLES 13/16" ø Reg. Noted.
BOLTS None
PAINT Red Lead Vt. Spec. 1 Reg. Noted

PROJECT 189 Over Approach Road
LOCATION Georgia & Fairfax Fairfield - St. Albans
CUSTOMER Lane Constr. Co.
ARCHITECT State of Vt. Dept. of Highways
JOB NO. 66-1184-2266 Str. St. SHEET NO. 29
66-1184-2266 Shear Studs

PRINT RECORD		
NO.	FOR	DATE
3	APP	1-6
2P	SHOP	11-29
2D	Shop	11-6
2	STATE	12-8
2		