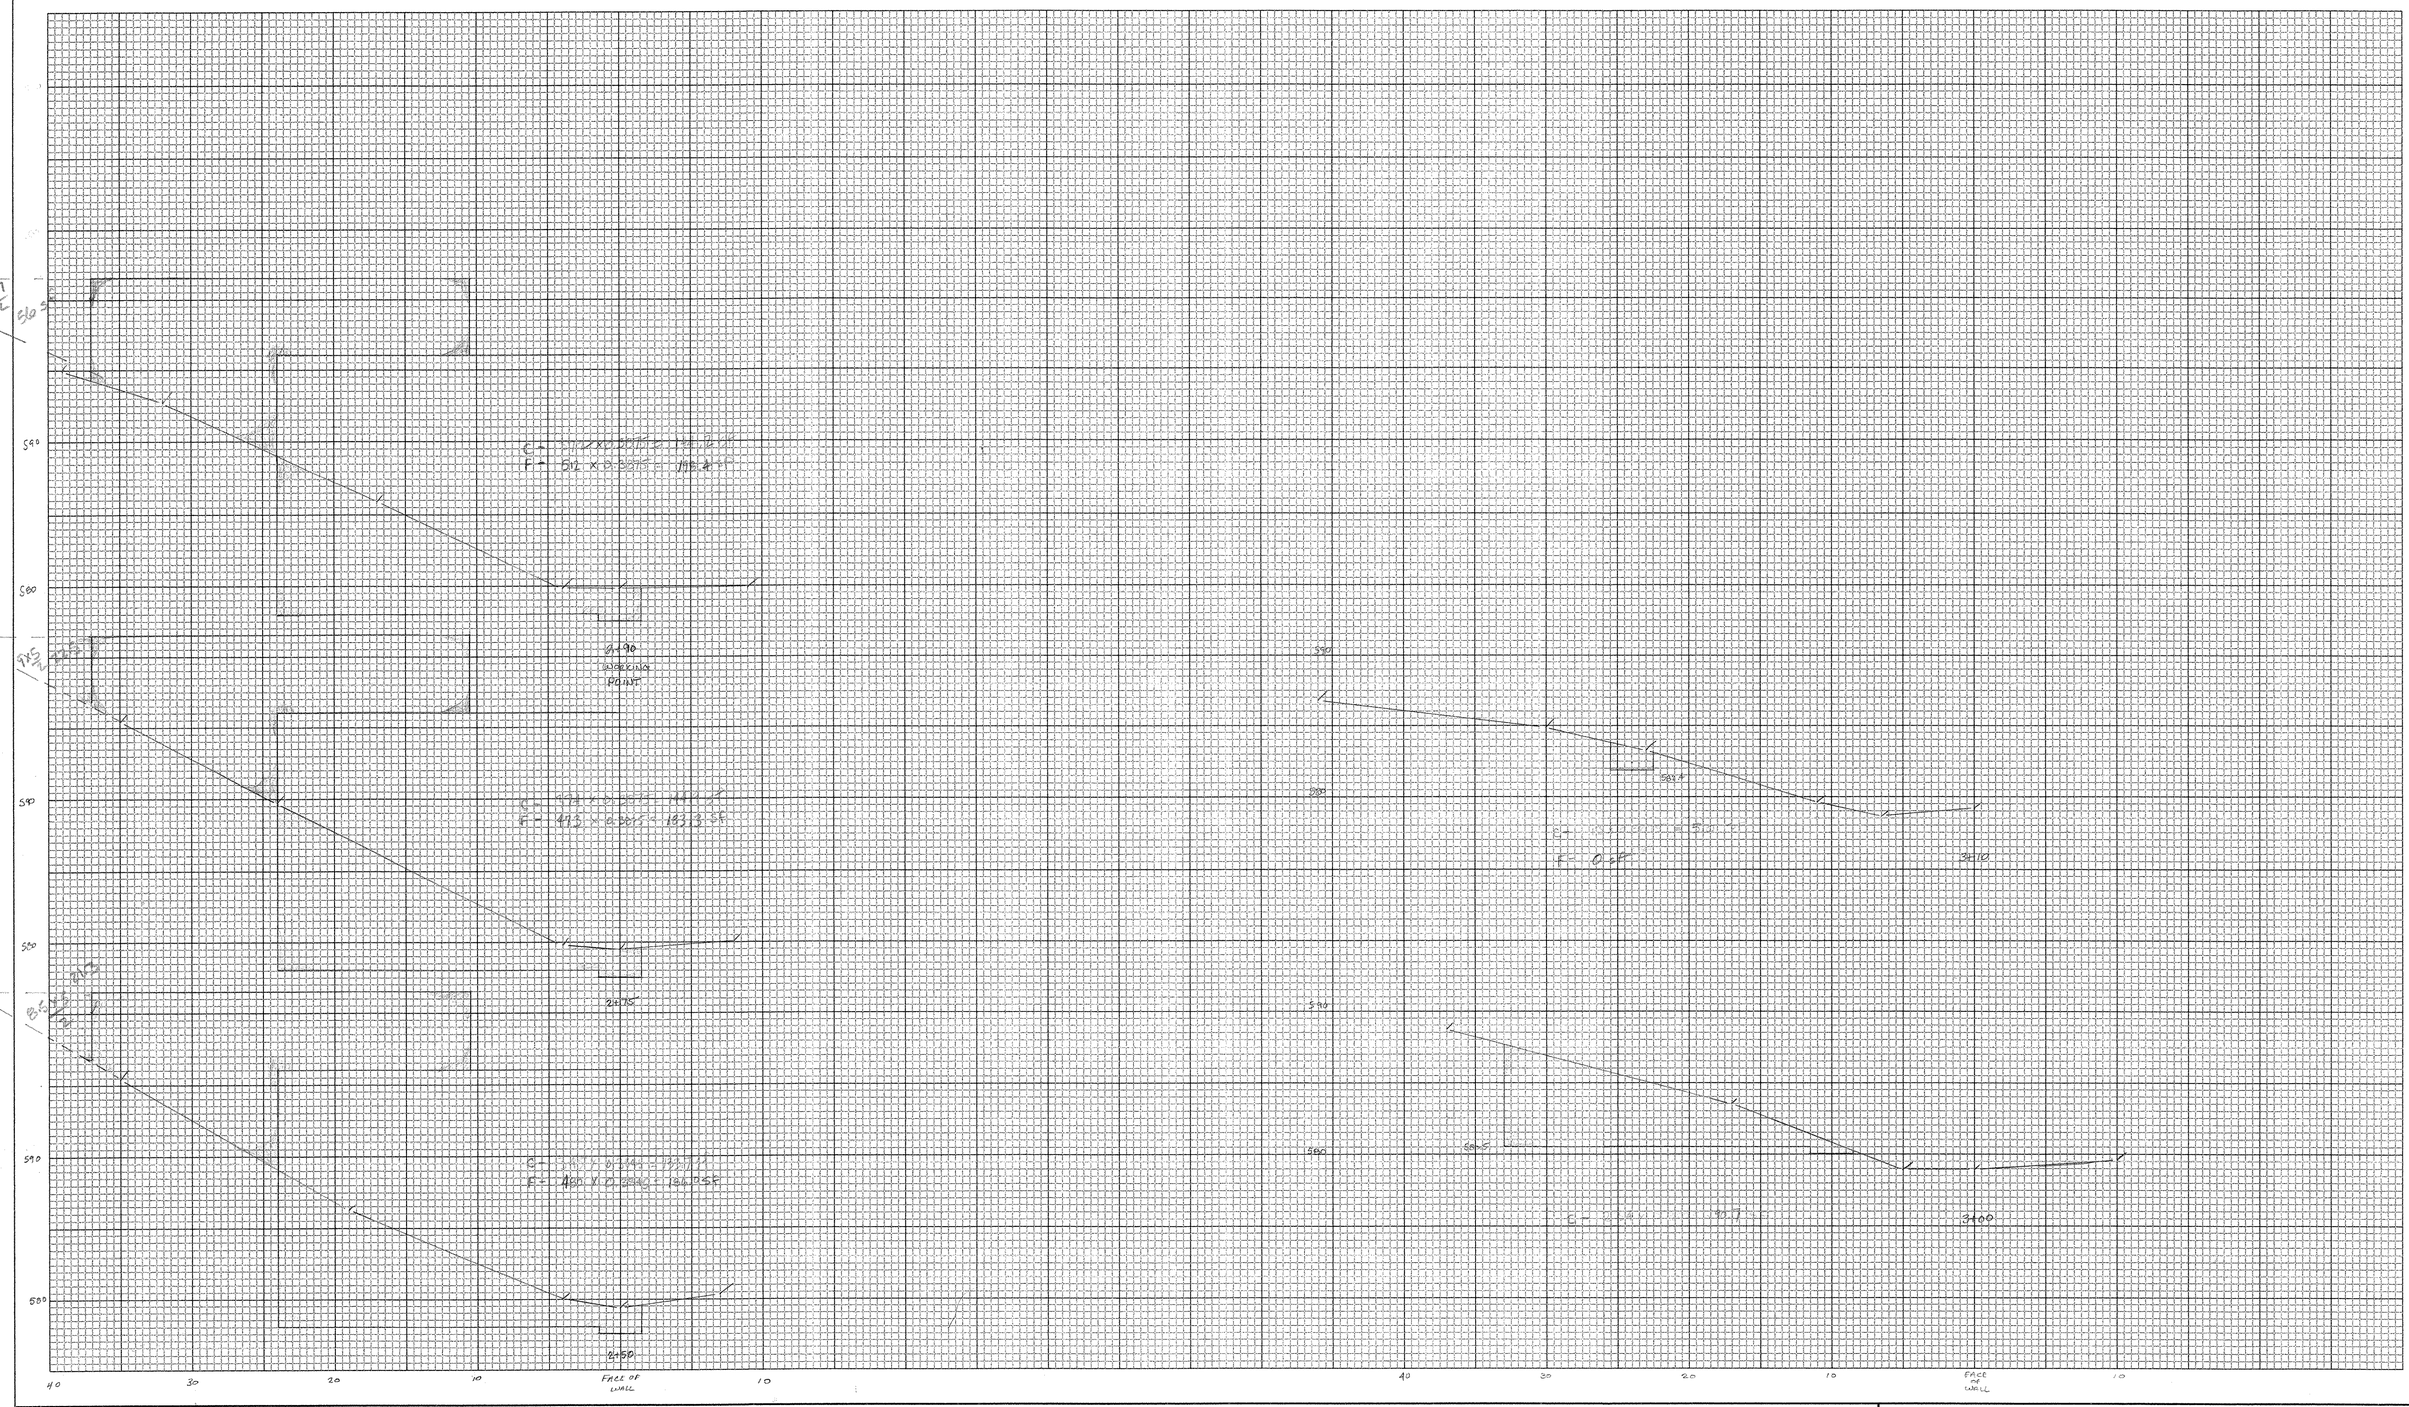

BLUE - SEDIMENTARY OVERBURDEN
GREEN - GRANULAR BORROW

CROSS SECTION SHEET

1" = 5'

PROJECT NAME: FAIRFAX - ST ALBANS
PROJECT NUMBER: IM 089-2(27)

FILE NAME: MSE WALL #1 STRUCTURE EXCAVATION
PLOT DATE: 05-JUN-2000 09
PROJECT LEADER:
DRAWN BY: KNIPES
DESIGNED BY:
CHECKED BY:
const: g:/common/cadd/e-xsection.dgn
SHEET 2 OF 389