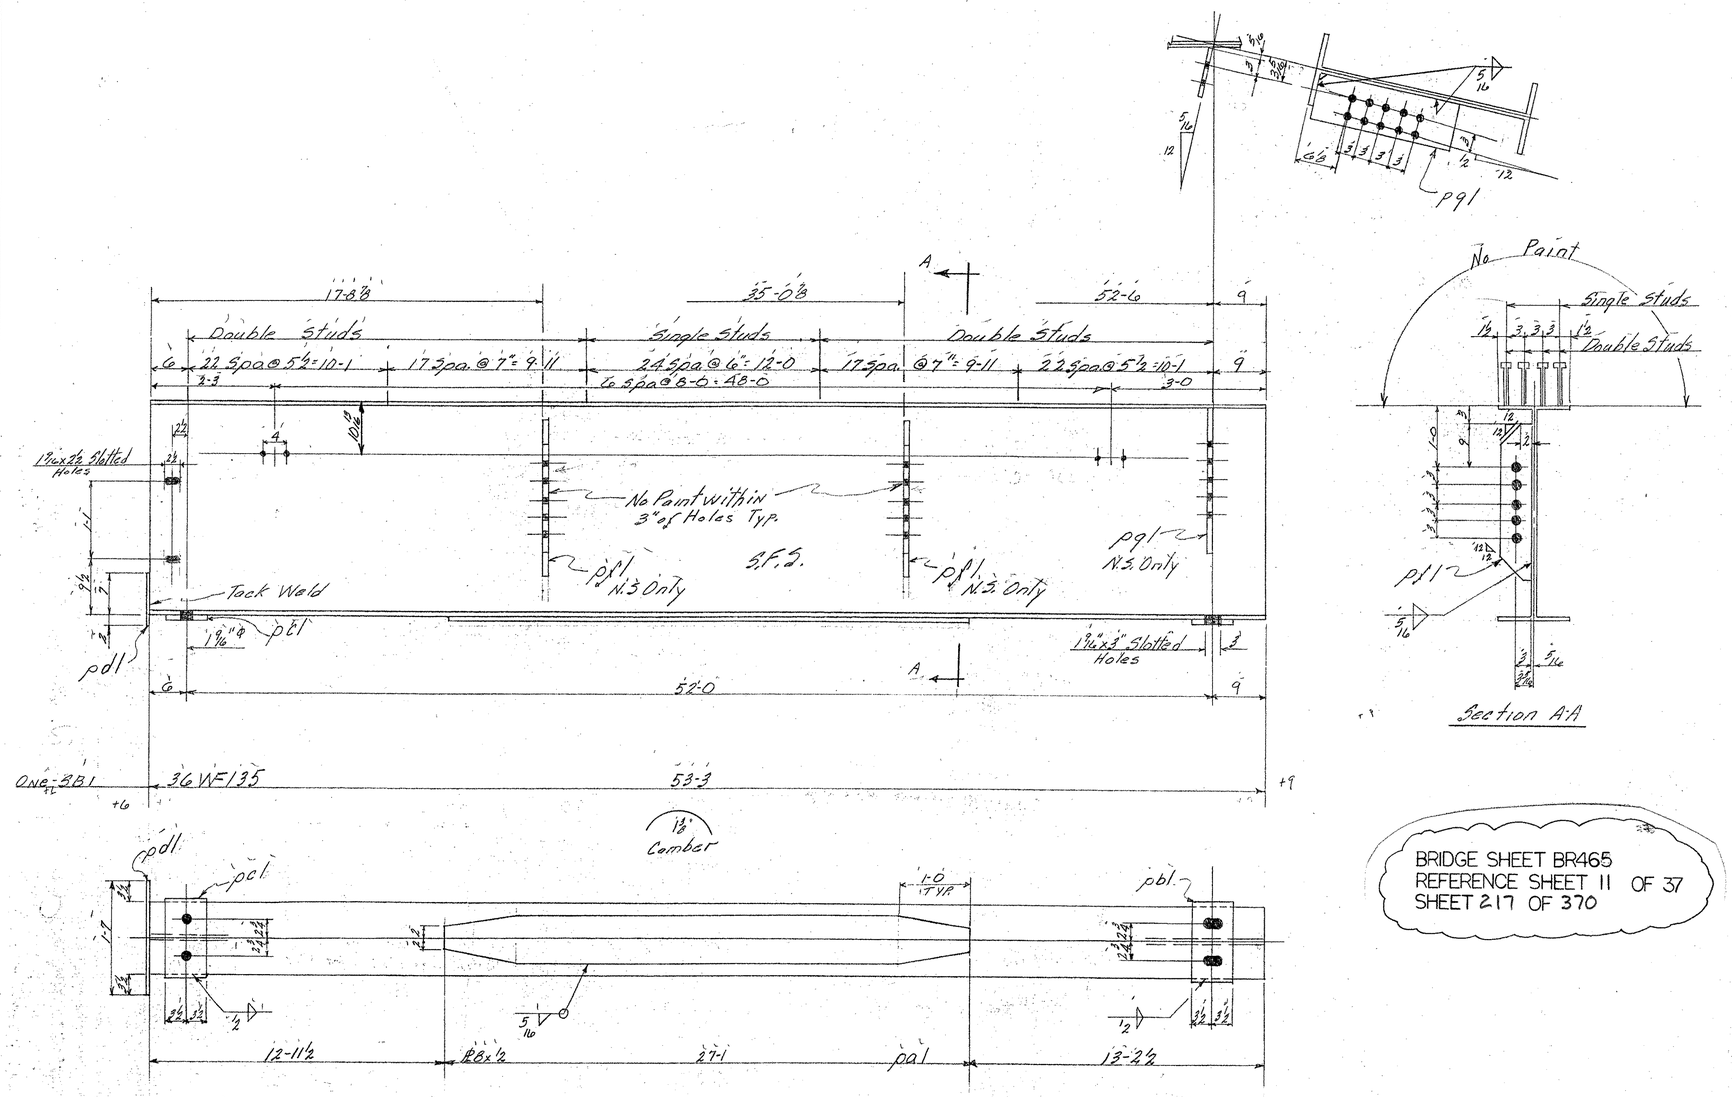

BRIDGE SHEET BR465
REFERENCE SHEET 11 OF 37
SHEET 217 OF 370

BILL OF MATERIAL

	NO. PIECES	MARK	DESCRIPTION	LENGTH FT.	LENGTH IN.		WEIGHT	

JOB NO. _____ SHEET NO. _____

BILL OF MATERIAL

ASTM-A36 (17)

	NO. PIECES	MARK	DESCRIPTION	LENGTH FT.	LENGTH IN.		WEIGHT	
			Beam					
	1	BB1	36 WF 135	53	3	ord BB66B2	7189	✓
	1	pa1	Bar 8 x 1/2	27	1	ord BB66B9	368	✓
	1	pb1	Bar 7x1	1	1	Res @ 20-D		
	1	pc1	do	1	1		52	✓
	1	pd1	PL 9 x 1/4	1	7	Res BM. 40 x 14 x 10-0	13	✓
	2	pf1	Bar 5x1/2	2	6	Res @ 20-D	43	✓
	1	pg1	Bar 8x1/2	2	0	ord @ 20-D BB66B9	~~27~~	✓
			1/4" f Weld	2	4		2	✓
			5/16" f Weld	69	10		~~25~~	✓ 17
								~~7719~~
								7711
		Cont	66-1189-226					
	366		3/4" ϕ Shear Studs	0	7	Stk	368	368 ✓
								8087

VERMONT STRUCTURAL STEEL CORPORATION
BURLINGTON, VT.

Proj. No. IBP-3(35) #2

		DATE
DRAWN BY	LC	11-8-66
OK'D BY	RLM	11-18-66

HOLES 13/16" ϕ Its Noted
BOLTS None
PAINT Red Lead
VT. Specs. (Sec. 7-1)

PROJECT I89 Over Approach Road
LOCATION Georgia-Fairfax-Fairfield St. Albans
CUSTOMER Lane Constr. Co.
ARCHITECT State of Vt. Dept. of High.
JOB NO. 66-1189-200 STRST. SHEET NO. 1
66-1189-226 Shear Studs

PRINT RECORD NO.	FOR	DATE
3	APP	11-21
2	SHOP	11-21
1	Shop	12-5
2	STATE	12-8
2	LANE	12-28

SM 1643 OCP