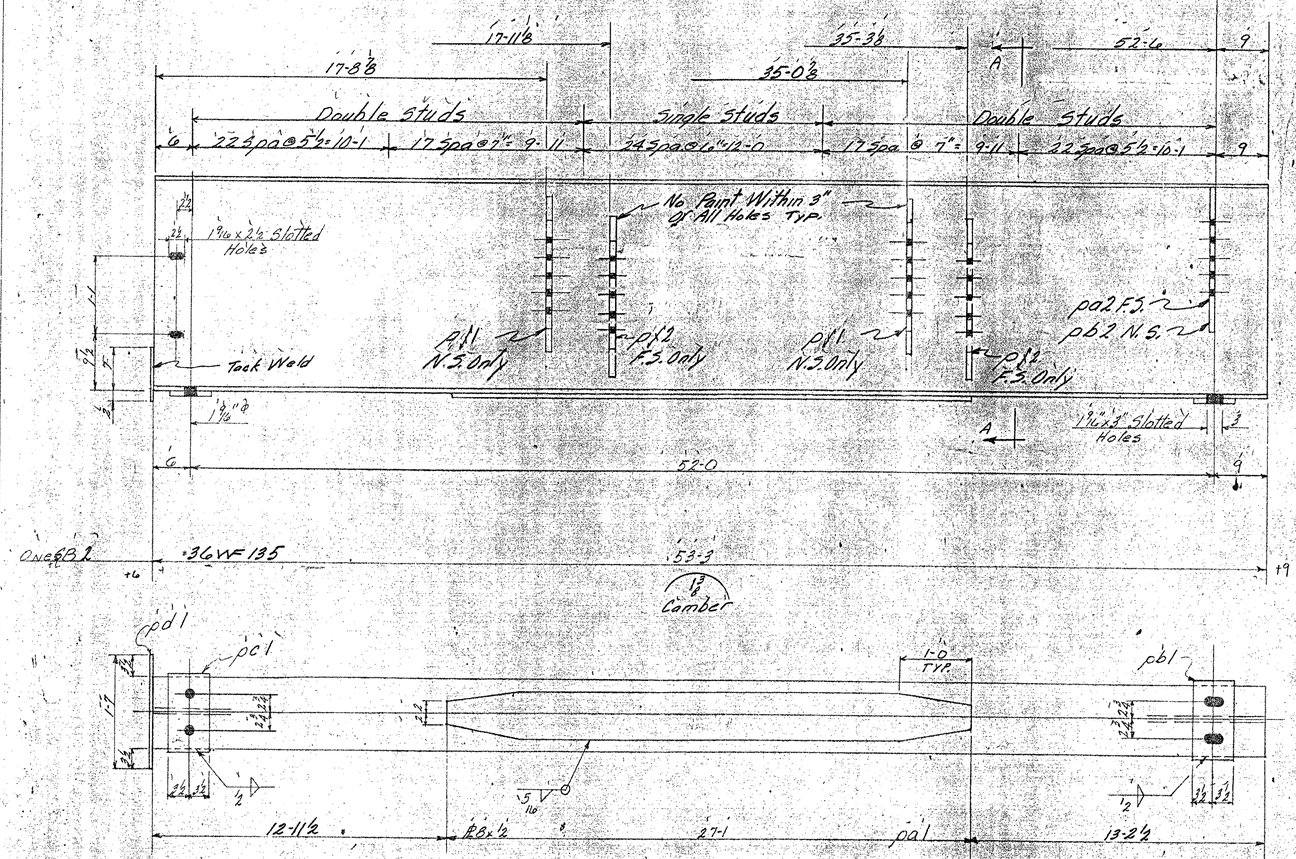

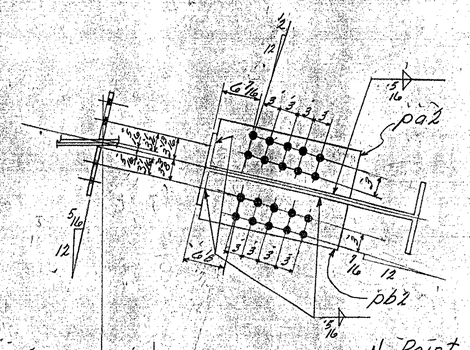

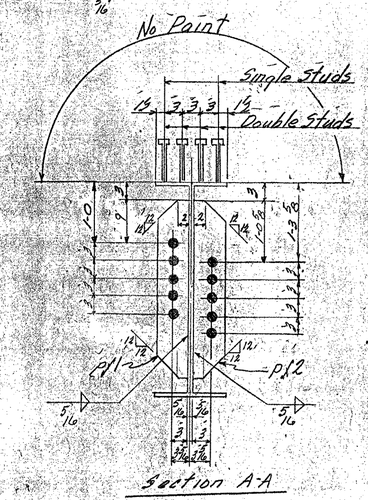

BRIDGE SHEET BR466
REFERENCE SHEET 12 OF 37
SHEET 218 OF 370

BILL OF MATERIAL

NO. PIECES	MARK	DESCRIPTION	LENGTH FT.	LENGTH IN.		WEIGHT	

JOB NO. _____ SHEET NO. _____

BILL OF MATERIAL

(17)

ASTM-A36

NO. PIECES	MARK	DESCRIPTION	LENGTH FT.	LENGTH IN.		WEIGHT	
		Beam					
1	1B2	36 WF 135	53	3	ord BB6679	7189	✓
1	pa1	Bar 8 x ½	27	1	ord BB6679	368	✓
1	pb1	Bar 7 x 1	1	1	Res @ 20-0		
1	pc1	do	1	1		52	✓
1	pd1	PL 9 x 4	1	7	Res # 48 x 14 in 10-0	13	✓
1	pa2	Bar 8 x ½	2	0	ord @ 20-0		
1	pb2	do	2	0	BB6679	54	✓
2	pf1	Bar 5 x ½	2	6			
2	pf2	do	2	6	Res @ 20-0	85	✓
		½" Weld	2	4		2	✓
		5/16" Weld	84	9		31	✓
							7794 ✓
							7784
		Cont. "66-1184-226"					
	366	3/4" ø Shear Studs	0	7	STK	368	368 ✓
							8162

VERMONT STRUCTURAL STEEL CORPORATION
BURLINGTON, VT.

Proj. No. 189-3(35)"2

		DATE
DRAWN BY	LC	11-8-66
OK'D BY	RLM	11-18-66

HOLES 5/16" ø As Noted
BOLTS None
PAINT Red Lead V.S. 30533 As Noted

PROJECT I 89 Over Approach Road
LOCATION Georgia-Fairfax-Fairfield-St Albans
CUSTOMER Lane Constr. Co.
ARCHITECT State of Vt. Dept of High.
JOB NO. 66-1184-200 STR SHEET NO. 2
66-1184-226 Shear Studs

PRINT RECORD NO.	PURP.	DATE
3	APP.	11-21
2	SHOP	11-21
1	Ship	12-5
2	STATE	12-8
2	LANE	12-28

SM 10-63 QCP