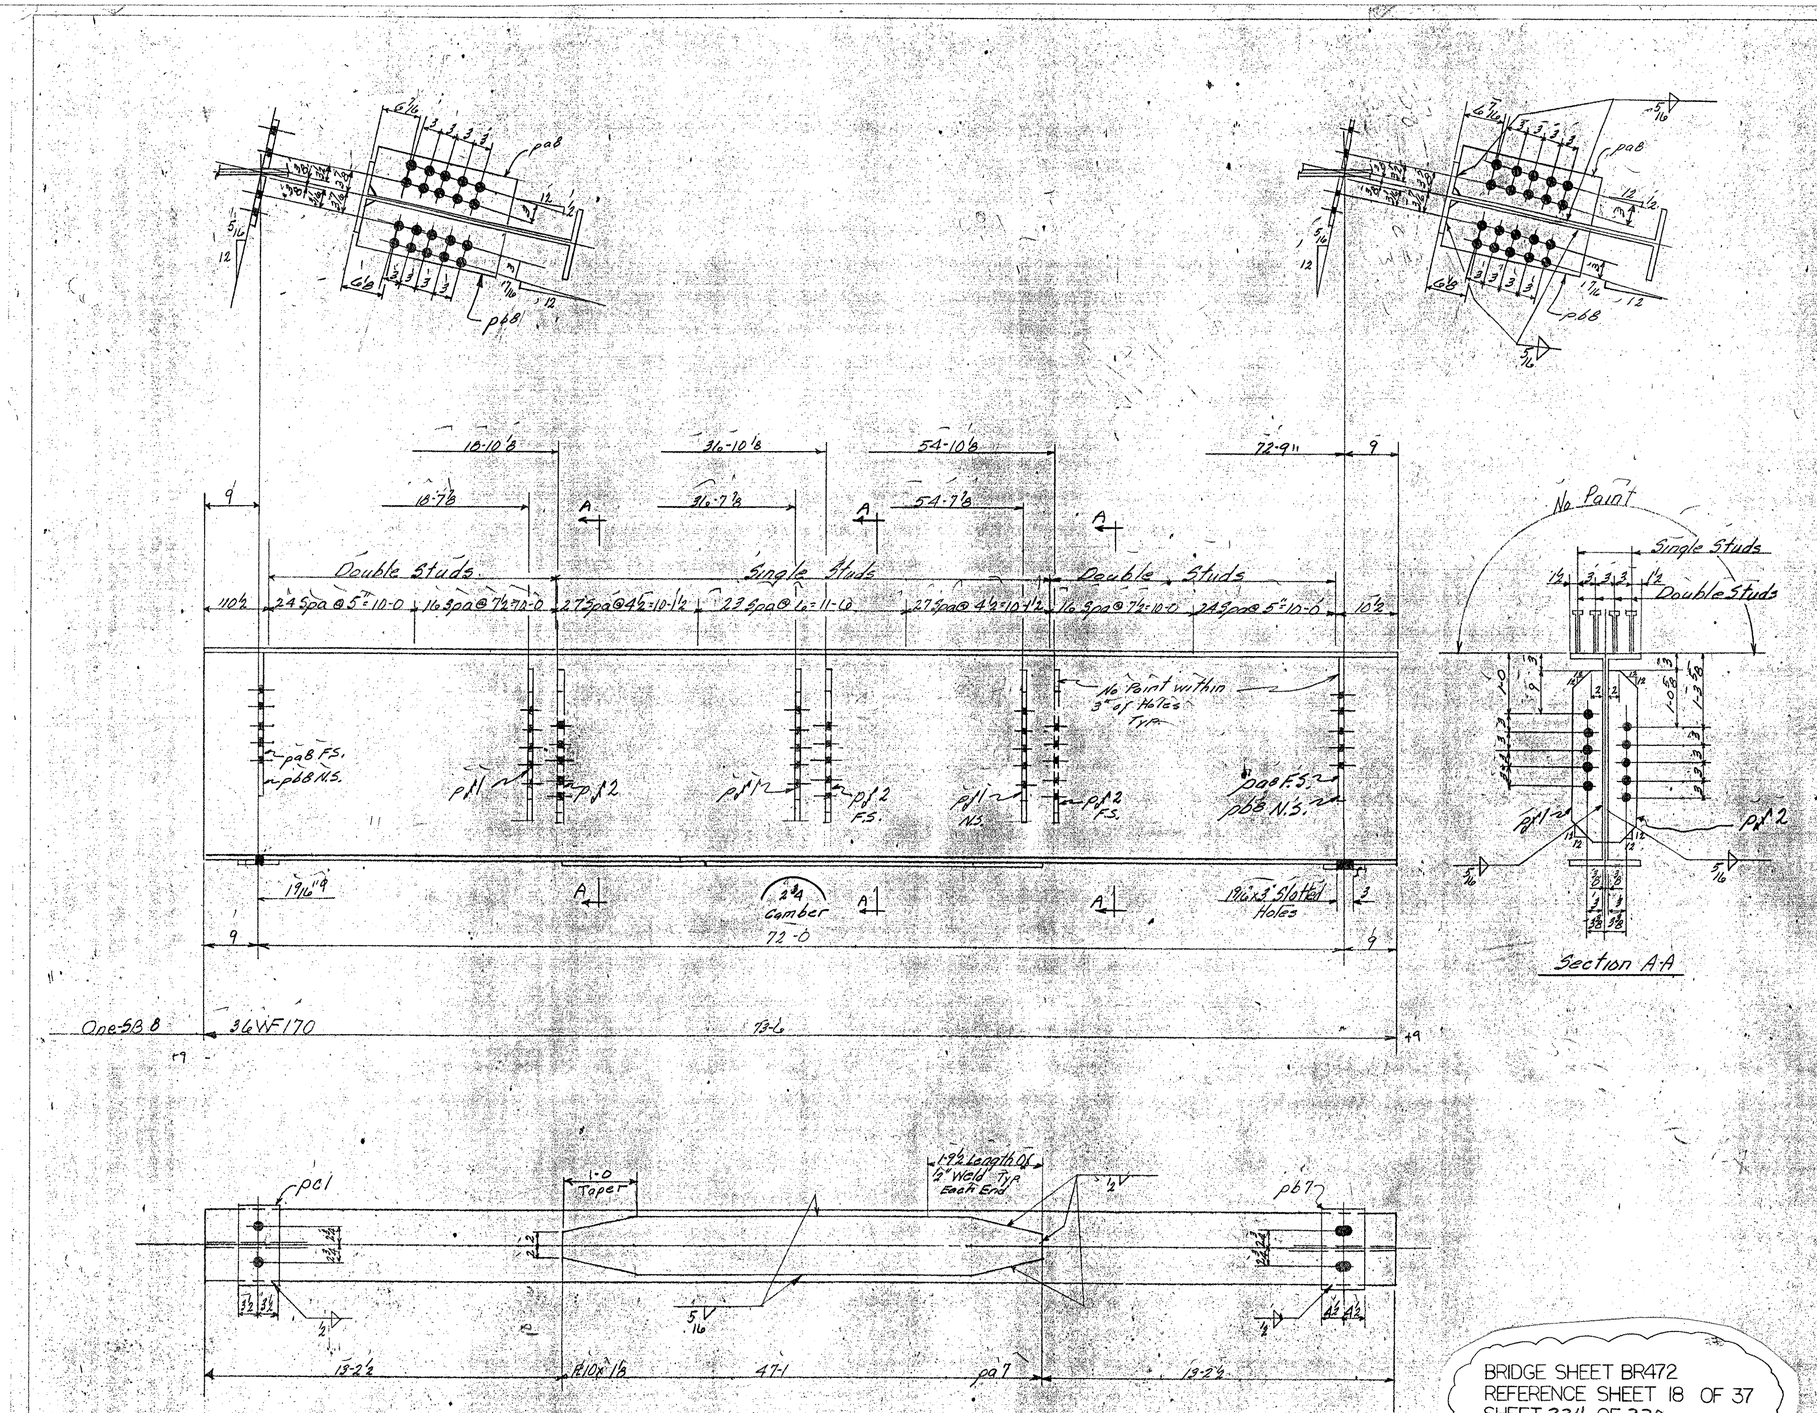

BRIDGE SHEET BR472
REFERENCE SHEET 18 OF 37
SHEET 224 OF 370

BILL OF MATERIAL

NO. PIECES	MARK	DESCRIPTION	LENGTH FT.	LENGTH IN.		WEIGHT

JOB NO. ..... SHEET NO. .....

ASTM-A36

BILL OF MATERIAL

(17)

NO. PIECES	MARK	DESCRIPTION	LENGTH FT.	LENGTH IN.		WEIGHT
		Beams				
1	SBB	36WF170	73	6	Rec. Rolled	12,495
1	pcl	Bar 7x1	1	1	Rec. 8-5-70-0	26
4	pa7	PL 10x1/8	47	1	Rolled Rec. 8-5-70-0	1832
1	pb7	PL 8x1/4	1	1	Rolled Rec. 8-5-70-0	53
2	pa8	Bar 8x1/2	2	0	Rec. 8-6-67 Rec. 8-5-70-0	109
2	pb8	do	2	0		
3	pd1	Bar 5x1/2	2	6	Rec. 8-7-70-0	128
3	pd2	do	2	6		
		~~3/16" Fillet Weld~~	~~11~~	~~0~~		~~7~~
		~~5/16" Fillet Weld~~	~~137~~	~~0~~		~~49.34~~
		~~Cont. # 66-1184-226~~				~~14,684~~ ~~14,701~~
480		3/4" Shear Studs	0	7	STK	482 482
						15,183

VERMONT STRUCTURAL STEEL CORPORATION
BURLINGTON, VT.

Proj. No. 189-3(35)^2

		DATE
DRAWN BY	L.C.	11-11-66
CK'D BY	RLM	11-18-66

HOLES 15/16" ø As Noted
BOLTS None
PAINT Red Lead Vt. Specs. Is Used

PROJECT 189: Over Approach Road
LOCATION Georgia-Fairfax-Fairfield-St. Albans
CUSTOMER Lane Constr. Co.
ARCHITECT State of Vt. Dept. of Highways
JOB NO. 66-1184-200 STR. SHEET NO. 3
66-1184-226 Shear Studs

PRINT RECORD

NO.	FOR	DATE
3	APP	11-21
2	SHOP	11-21
3	SHOP	12-5
3	STRTE	12-8
2	LANE	12-28