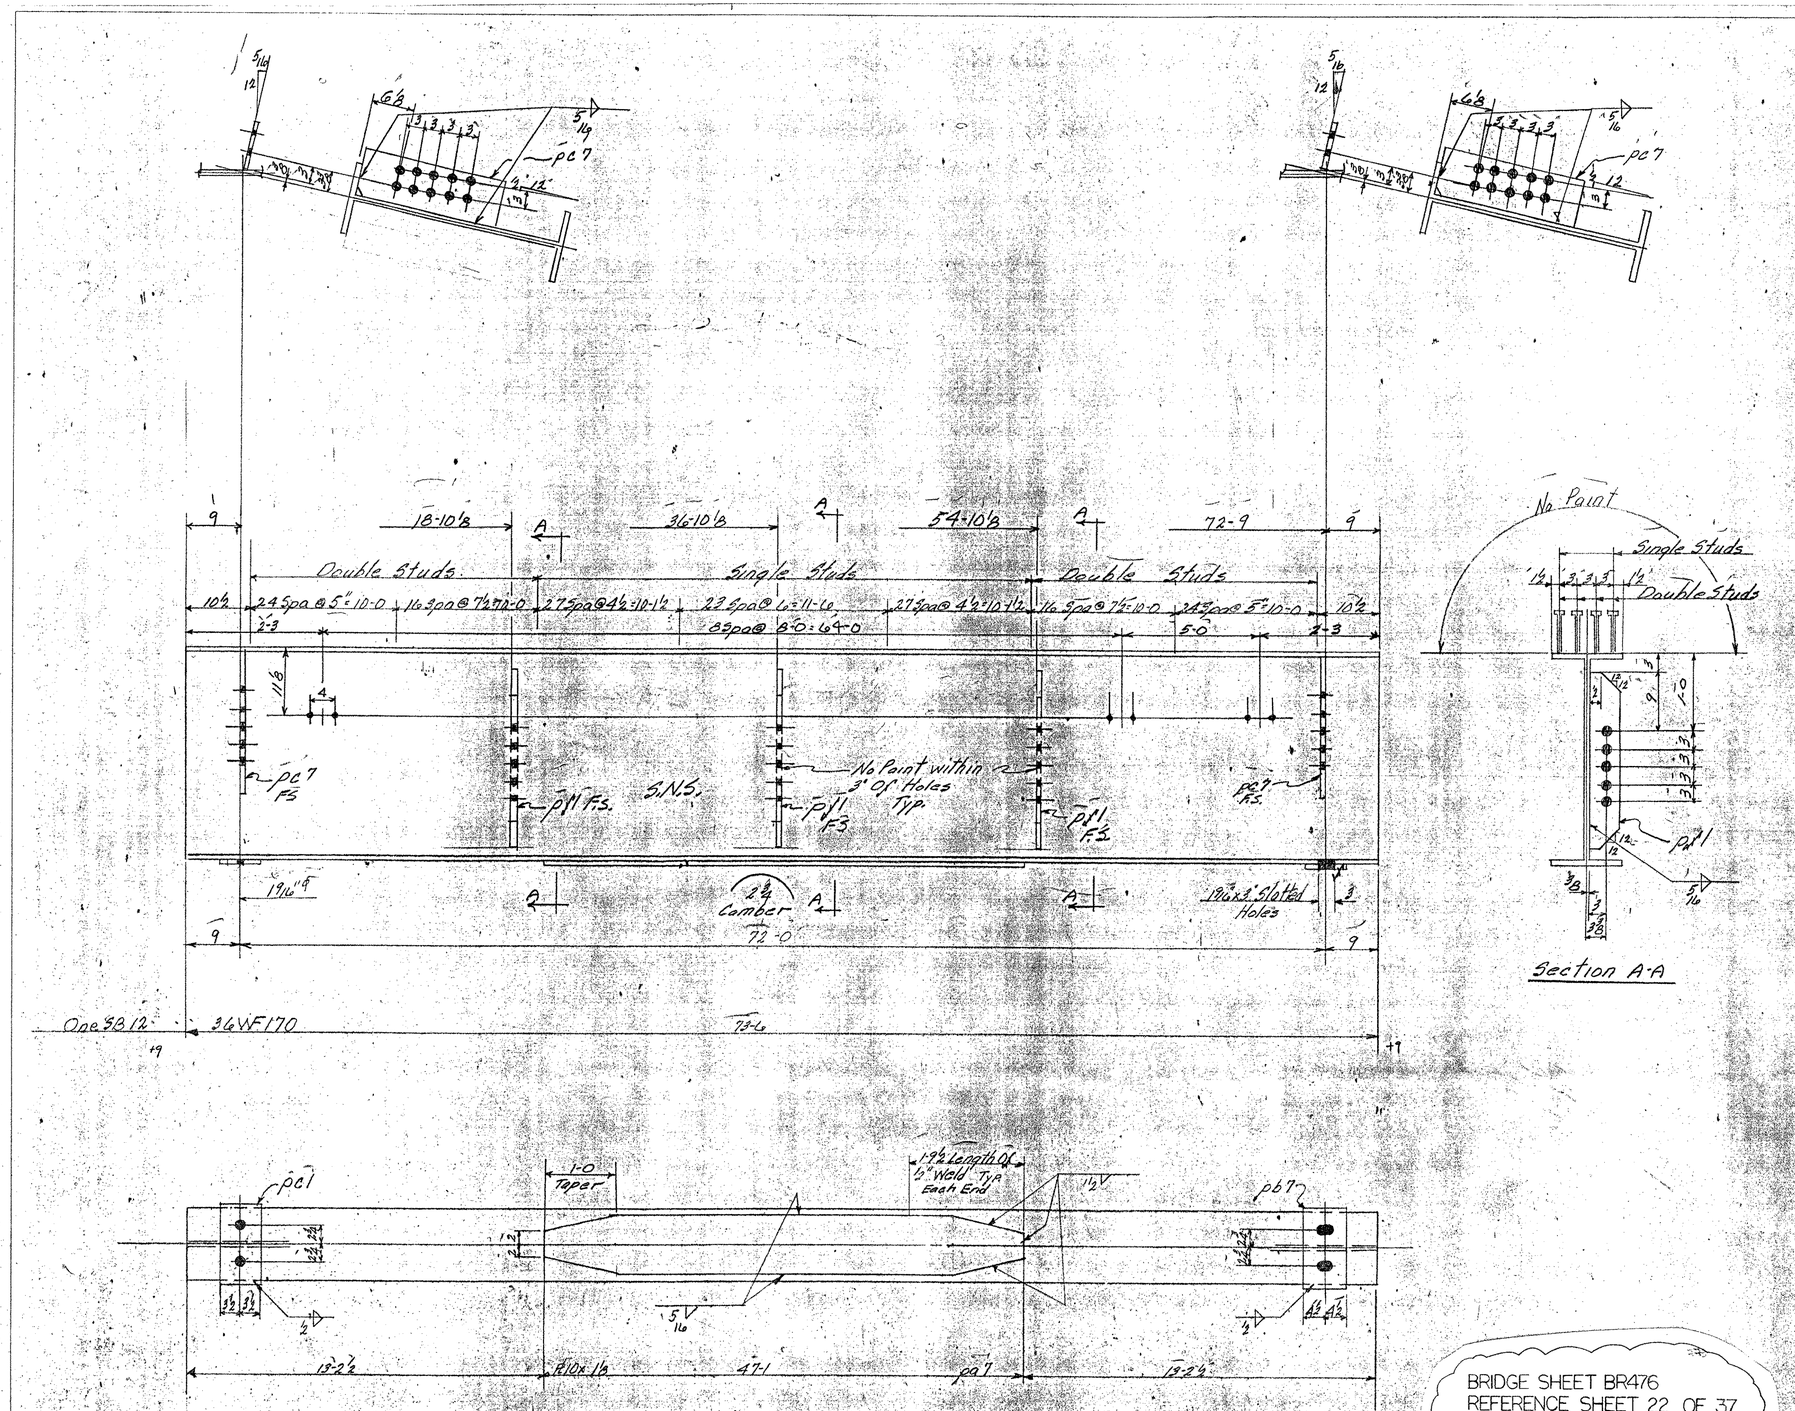

BILL OF MATERIAL

NO. PIECES	MARK	DESCRIPTION	LENGTH FT.	LENGTH IN.		WEIGHT

JOB NO. SHEET NO.

ASTM-A36

BILL OF MATERIAL (17)

NO. PIECES	MARK	DESCRIPTION	LENGTH FT.	LENGTH IN.		WEIGHT
		Beams				
1	36B12	36 WF 170	73	6	ord. 88L682	12,495
7	pa7	Bar 7x1	1	1	Rec 820-0	26
7	pa7	PL 10x1/2	47	1	88L681 Recd 1820	1832
1	pb7	PL 9x1/2	1	1		53
2	pa7	Bar 8x1/2	2	0	ord 1920-088L679	54
3	pb1	Bar 5x1/2	2	6	Rec 820-0	64
		5/16" Weld	11	0		9
		3/16" Weld	112	0		40
		Coat # 66-1189-226				14,559
480		3/4" Shear Studs	0	7	STK	482
						15,055

VERMONT STRUCTURAL STEEL CORPORATION
BURLINGTON, VT.

Proj. No. I89-3(35)72

		DATE
DRAWN BY	L.C.	11-11-66
CK'D BY	RLM	11-12-66

HOLES 15/16" ø As Noted
BOLTS None
PAINT Red Lead Vt. Specs. As Noted

PROJECT I89-Over Approach Road
LOCATION Georgia-Fairfax-Fairfield-St. Albans
CUSTOMER Lane Constr. Co.
ARCHITECT State of Vt. Dept. of Highways
JOB NO. 66-1189-200 STK. S.T. SHEET NO. 17
66-1189-226 Shear Studs

PRINT RECORD			
NO.	FOR	DATE
3	LAP	11-21
2P	SHOP	11-21
2D	Shop	12-5
2	STATE	12-8
2	LANE	12-28

BRIDGE SHEET BR476
REFERENCE SHEET 22 OF 37
SHEET 228 OF 370