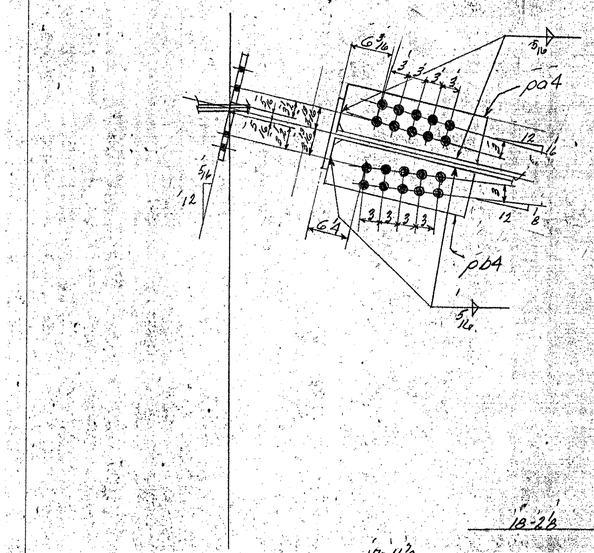

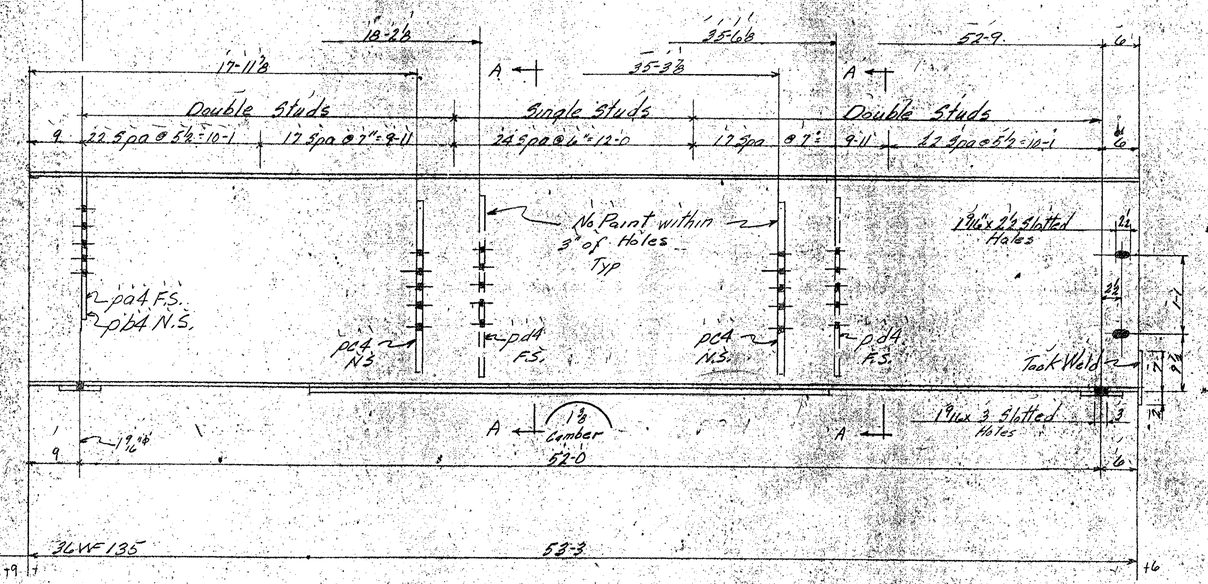

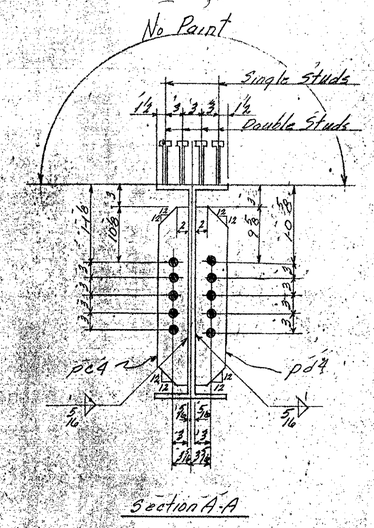

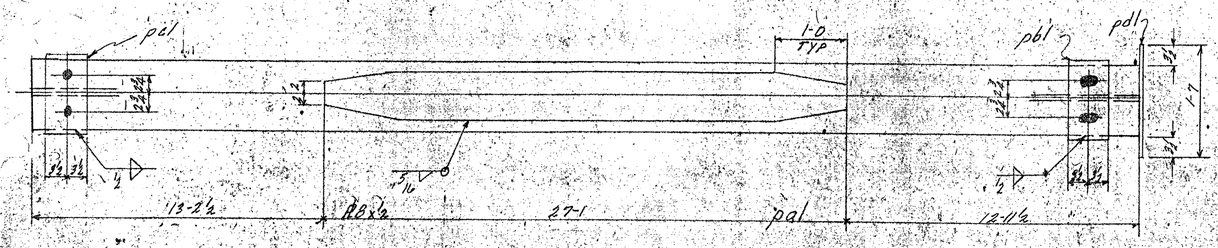

BRIDGE SHEET BR480
REFERENCE SHEET 26 OF 37
SHEET 232 OF 370

BILL OF MATERIAL

NO. PIECES	MARK	DESCRIPTION	LENGTH FT.	LENGTH IN.		WEIGHT	

JOB NO. SHEET NO.

BILL OF MATERIAL

ASTM-A36 (17)

NO. PIECES	MARK	DESCRIPTION	LENGTH FT.	LENGTH IN.		WEIGHT	
		Beam					
1	3B16	36WF135	53	3	and BB6682	7189	
1	pa1	Bar 8x½	27	1	~~BB6679~~	368	
1	pb1	Bar 7x1	1	1	Re 2020-6		
1	pa1	do	1	1		52	
1	pd1	PL 9x4	1	7	Re BB6682	113	
2	pd4	Bar 5x½	2	6	Re 2020-6	43	
1	pa4	Bar 8x½	2	0	Re 2020-6		
1	pb4	do	2	0	BB6679	54	
2	pc4	Bar 5x½	2	6	Re 2020-6	43	
		½" Weld	2	4		2K	
		5/16" Weld	44	9		34	21
							~~7795~~
		Coat # 66-1184-226					7785
366		3/4" Shear Studs	0	7	STK	368	368
							8163

VERMONT STRUCTURAL STEEL CORPORATION
BURLINGTON, VT.

		DATE
DRAWN BY	L.C.	12-1-66
CHKD BY	R.L.M.	11-18-66

HOLES 13/16" Pins Dated
BOLTS None
PAINT Red Lead VT. Spots touched

PROJECT 189 Over Approach Road
LOCATION Georgia Tanker Storage Tank & Shore
CUSTOMER Lane Const. Co.
ARCHITECT State Of Vt. Highways
JOB NO. 66-1184-200 Pt. 5
SHEET NO. 16
66-1184-226 Shear Studs

ORDER NO. 189-3-45-2

PRINT RECORD		
S.	A.H.	12-6
2.P	Shop	12-6
2.D		12-6
2.	STATE	12-8
2.	LANE	12-28