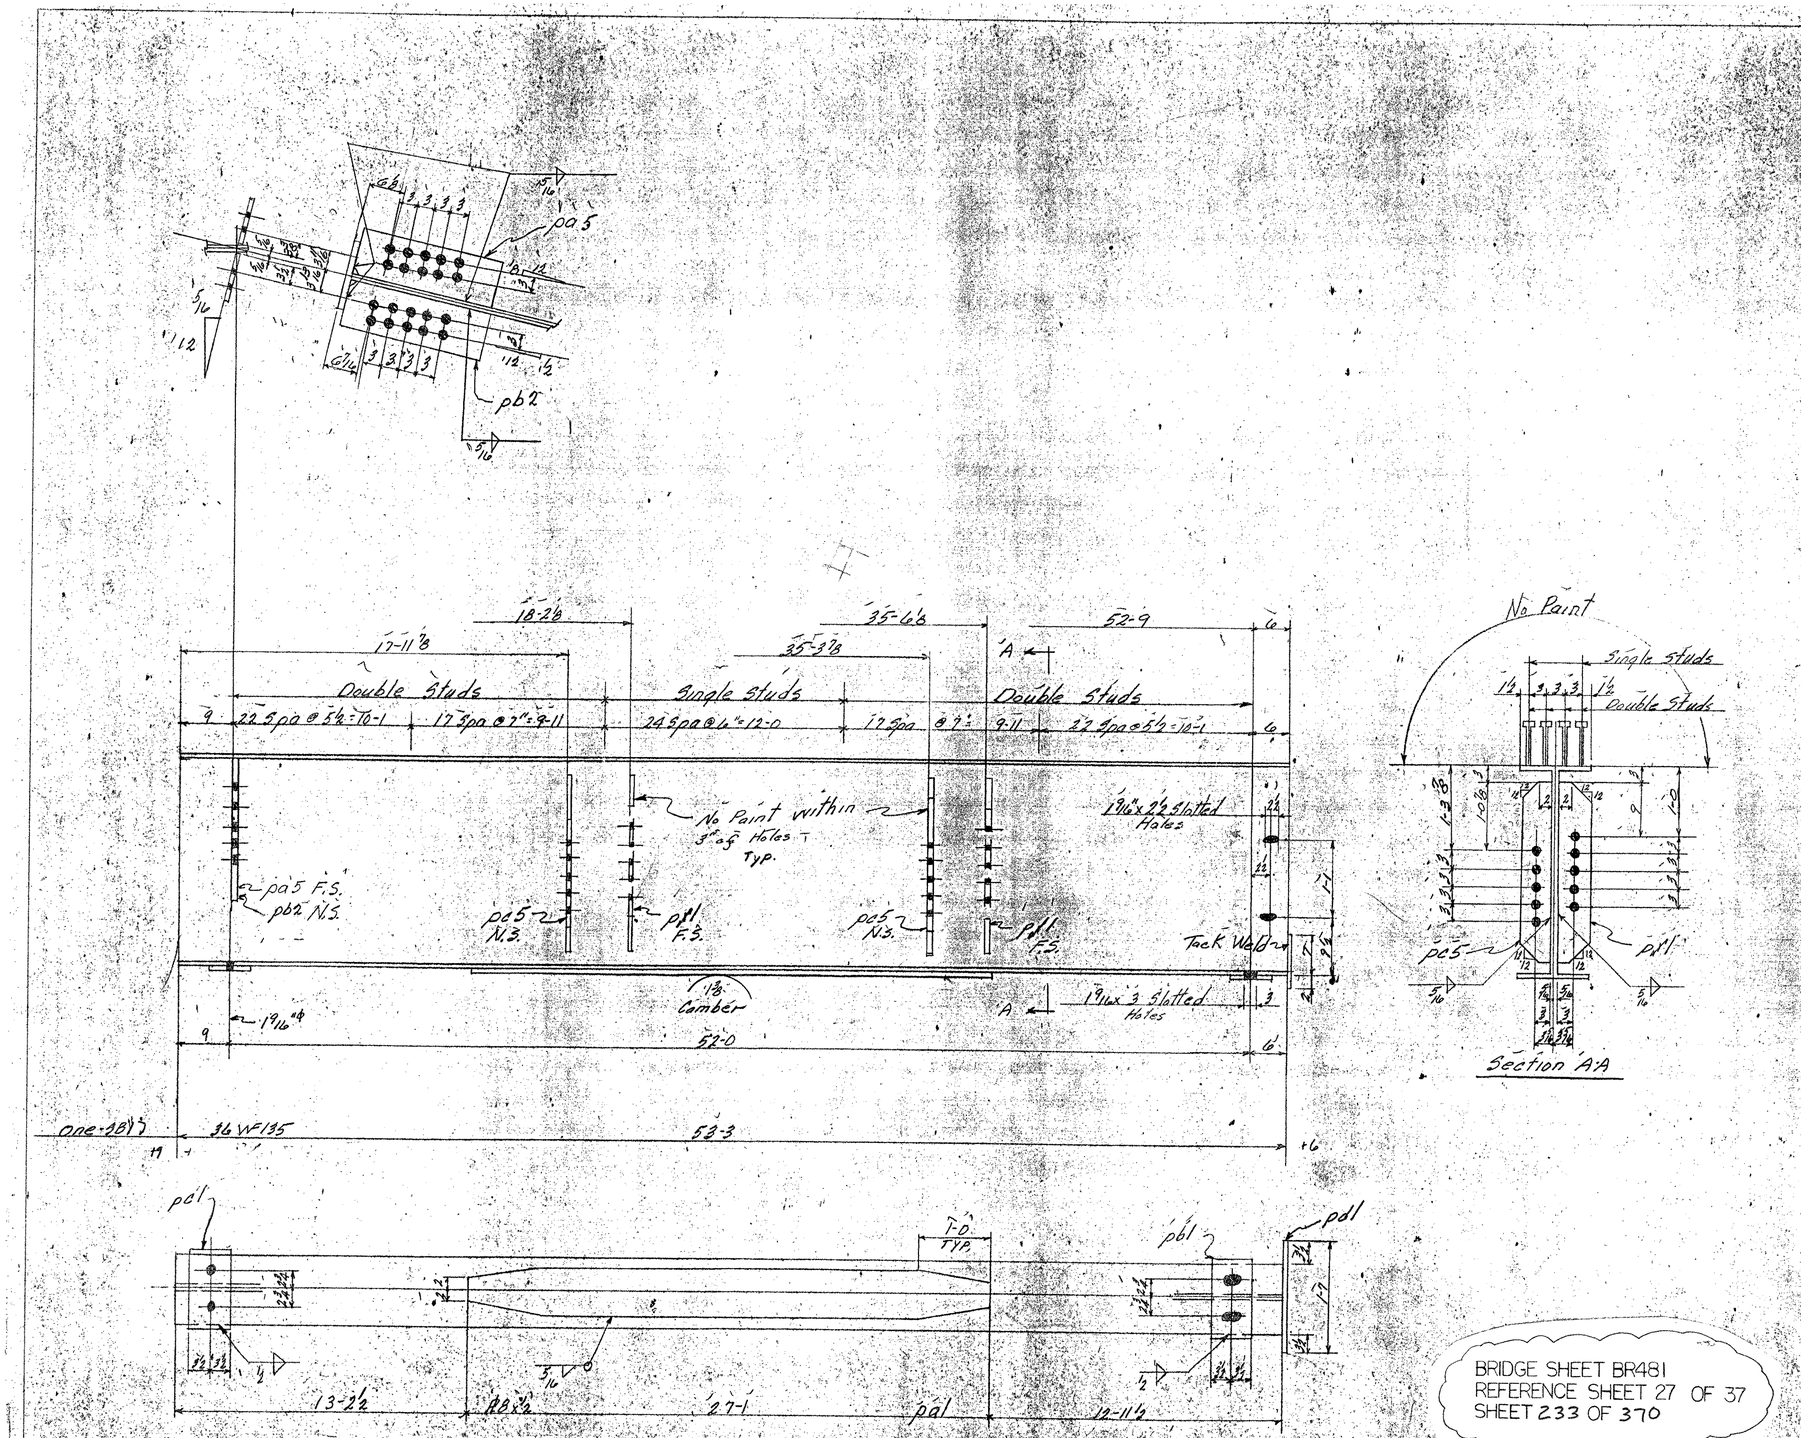

BRIDGE SHEET BR481
REFERENCE SHEET 27 OF 37
SHEET 233 OF 370

BILL OF MATERIAL

NO. PIECES	MARK	DESCRIPTION	LENGTH FT.	LENGTH IN.		WEIGHT

JOB NO. SHEET NO.

ASTM-A36

BILL OF MATERIAL (17)

NO. PIECES	MARK	DESCRIPTION	LENGTH FT.	LENGTH IN.		WEIGHT
		Beam				
1	3817	36 WF 135	53	3	ord BR6683	7189
1	pa1	Bar 8 x 1/2	27	7	" 66-119	368
1	pb1	Bar 7 x 1	1	1	Res @ 20-0	
1	pd1	do	7	7		52
1	pd1	PL 9 x 9	1	7	Res @ 33 x 4 x 10-0	13
2	pf1	Bar 3 x 1/2	2	6	Res @ 30-0	43
1	pa5	Bar 8 x 1/2	2	0	2 ord @ 20-0	
1	pb2	do	2	0	BR 66-119	54
2	pa5	Bar 8 x 1/2	2	6	Res @ 20-0	43
		1/4" Weld	1	9		21
		5/16" Weld	84	9		~~31~~ 21
						~~7795~~
		Cont. # 66-184-226				7785
366		3/4" ø Shear Studs	0	7	STK	368 318
						8163

VERMONT STRUCTURAL STEEL CORPORATION
BURLINGTON, VT.

		DATE
DRAWN BY	L.C.	11-17-66
CHKD BY	RKM	11-18-66

NOTES 5/16" ø Res Dated
BOLTS None
PAINT Red Lead VT. Specs Noted

PROJECT I89 Over Approach Road
LOCATION Georgia Fairfax Fonda St. Albans
CUSTOMER Lane Const. Co.
ARCHITECT State Of Vermont Highw.
JOB NO. 66-184-200 STR SHEET NO. VT
66-184-226 Shear Ste

Proj. I89-3(35)2

NO.	REVISIONS	DATE
3	Add	12
2	Sup	12
1	Sup	12
2	Stat	12