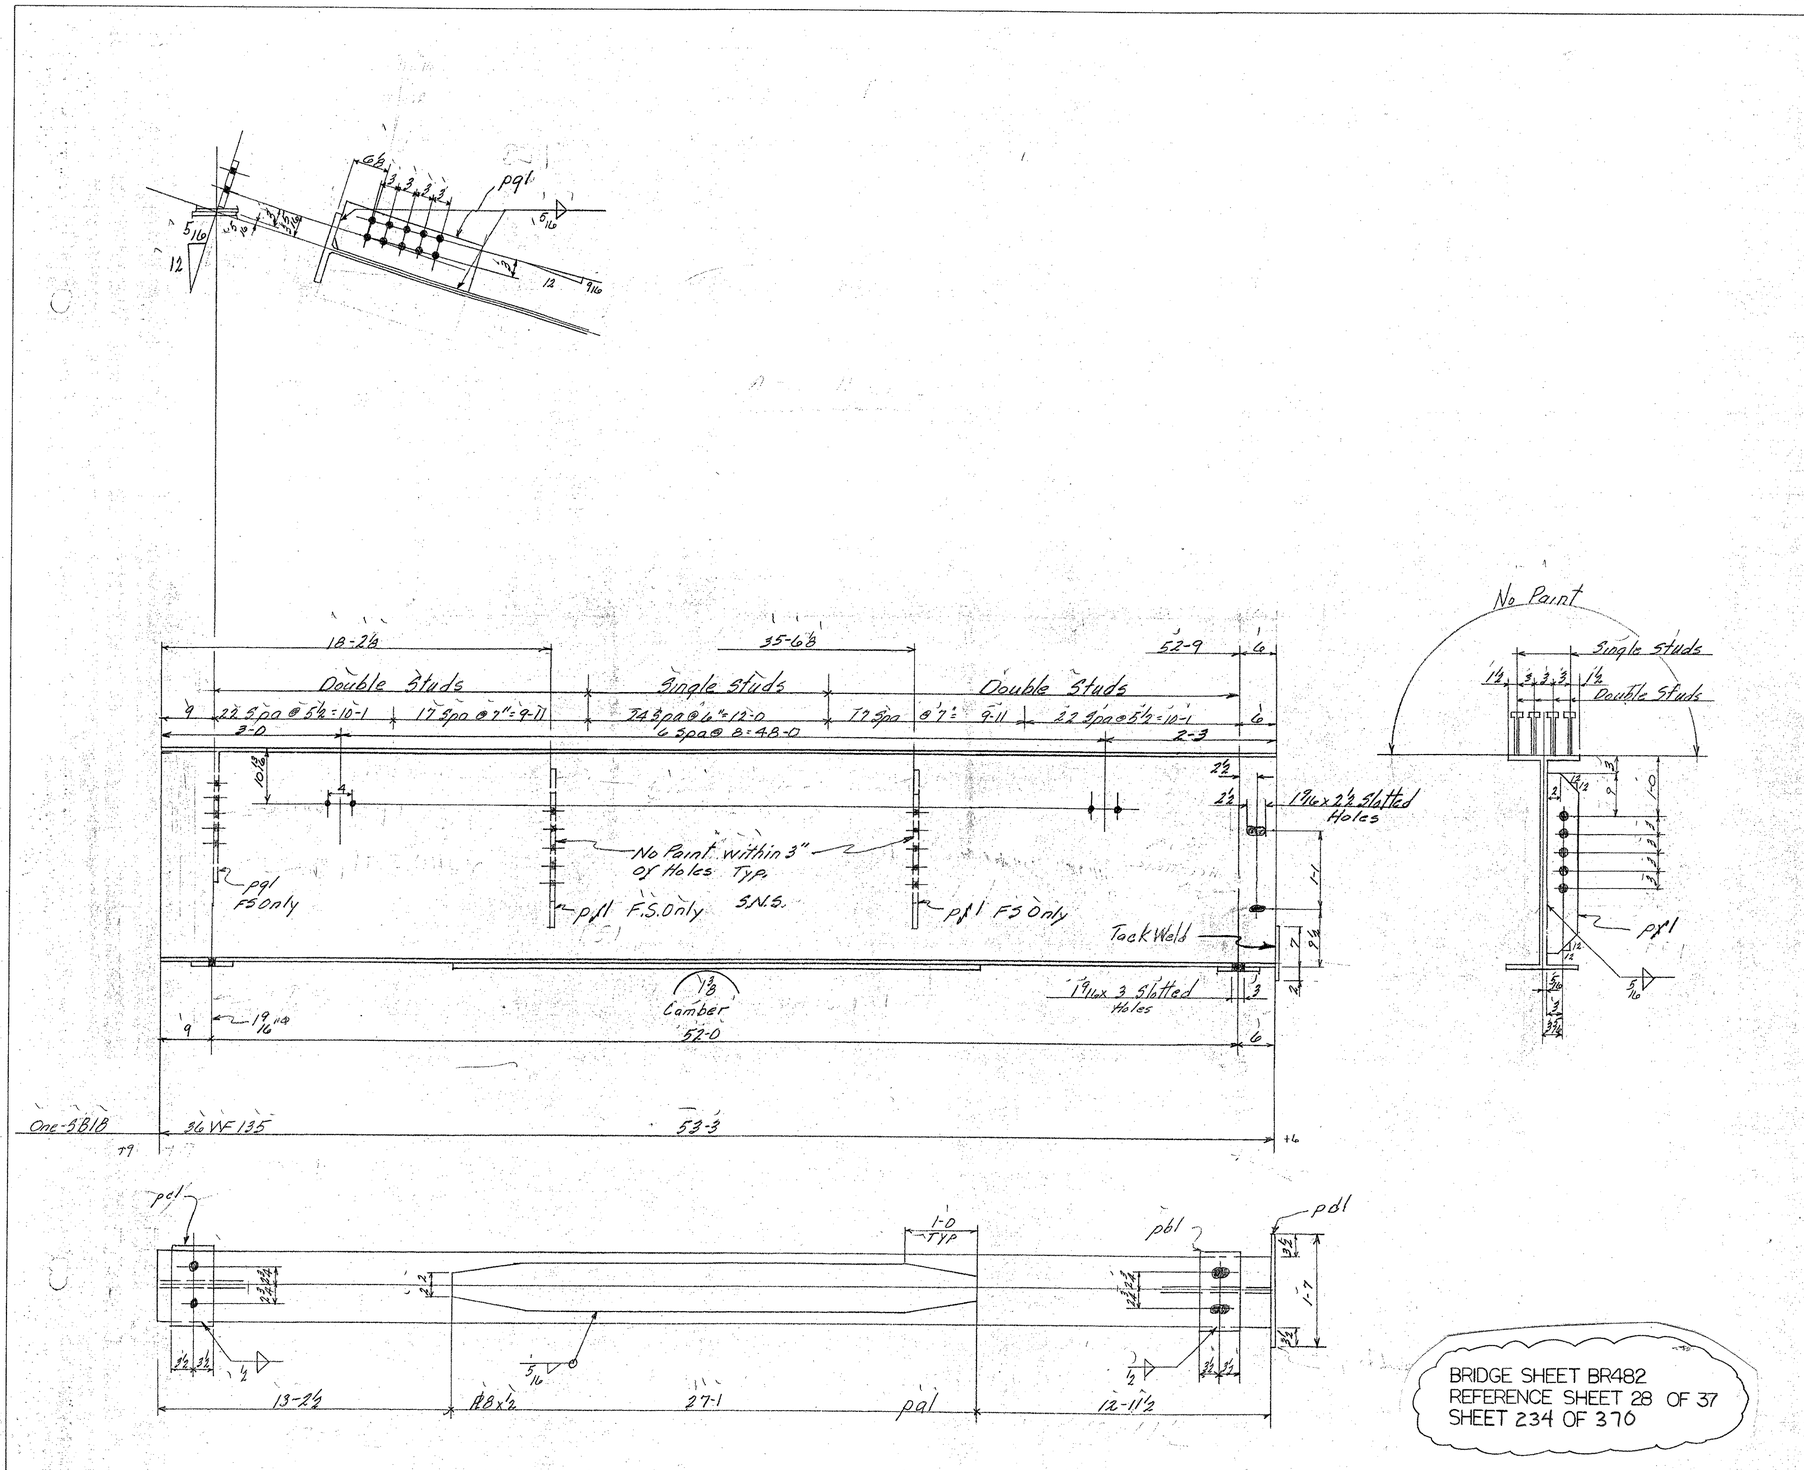

BRIDGE SHEET BR482
REFERENCE SHEET 28 OF 37
SHEET 234 OF 370

BILL OF MATERIAL

	NO. PIECES	MARK	DESCRIPTION	LENGTH FT.	LENGTH IN.		WEIGHT	

JOB NO. _____ SHEET NO. _____

ASTM-A36

BILL OF MATERIAL

17 (17)

	NO. PIECES	MARK	DESCRIPTION	LENGTH FT.	LENGTH IN.		WEIGHT	
			Beam					
	1	5B18	36 WF 135	53	3	and PB6682	7189	✓
	1	pdl	Bar 8 x 1/2	27	1	PB66-79	368	✓
	1	pbl	Bar 7 x 1	1	1	Reso 20-0		
	1	pdl	do	1	1		52	✓
	1	pdl	PL 9 x 4	1	7	Bar PB 48 x 4 x 10-0	13	✓
	2	pgl	Bar 5 x 1/2	2	6	Reso 20-0	43	✓
	1	pgl	Bar 8 x 1/2	2	0	order 40-0 PB66-79	27	✓
			1/2" Weld	2	4		2	✓
			5/16" f Weld	69	10		~~25~~	✓ 17
								~~7919~~
			Cont #66-1184-226					7711
	366		3/4" ⌀ Shear Studs	0	7	STK	368	368 ✓
								8087 ✓

VERMONT STRUCTURAL STEEL CORPORATION
BURLINGTON, VT.

proj #189-3(35)"2

		DATE
DRAWN BY	L.C.	11-11-66
OK'D BY	RLM	11-21-66

HOLES 15/16" ⌀ As Noted
BOLTS None
PAINT Red Lead Vt. Spec as Noted

PROJECT 189 Over Approach Road
LOCATION Georgia-Fairfax-Fairfield-St. Albans
CUSTOMER Lane Const. Co.
ARCHITECT State Of Vt. Dept Of Hgh.
JOB NO. 66-1184-200 STR SHEET NO. 18
66-1184-226 Shear Studs

PRINT RECORD

NO.	FOR	DATE
3	APP	11-21
2	SHOP	11-21
1	SHOP	12-5
2	STATE	12-8
2	LANE	12-28

SM-10-63 QCP