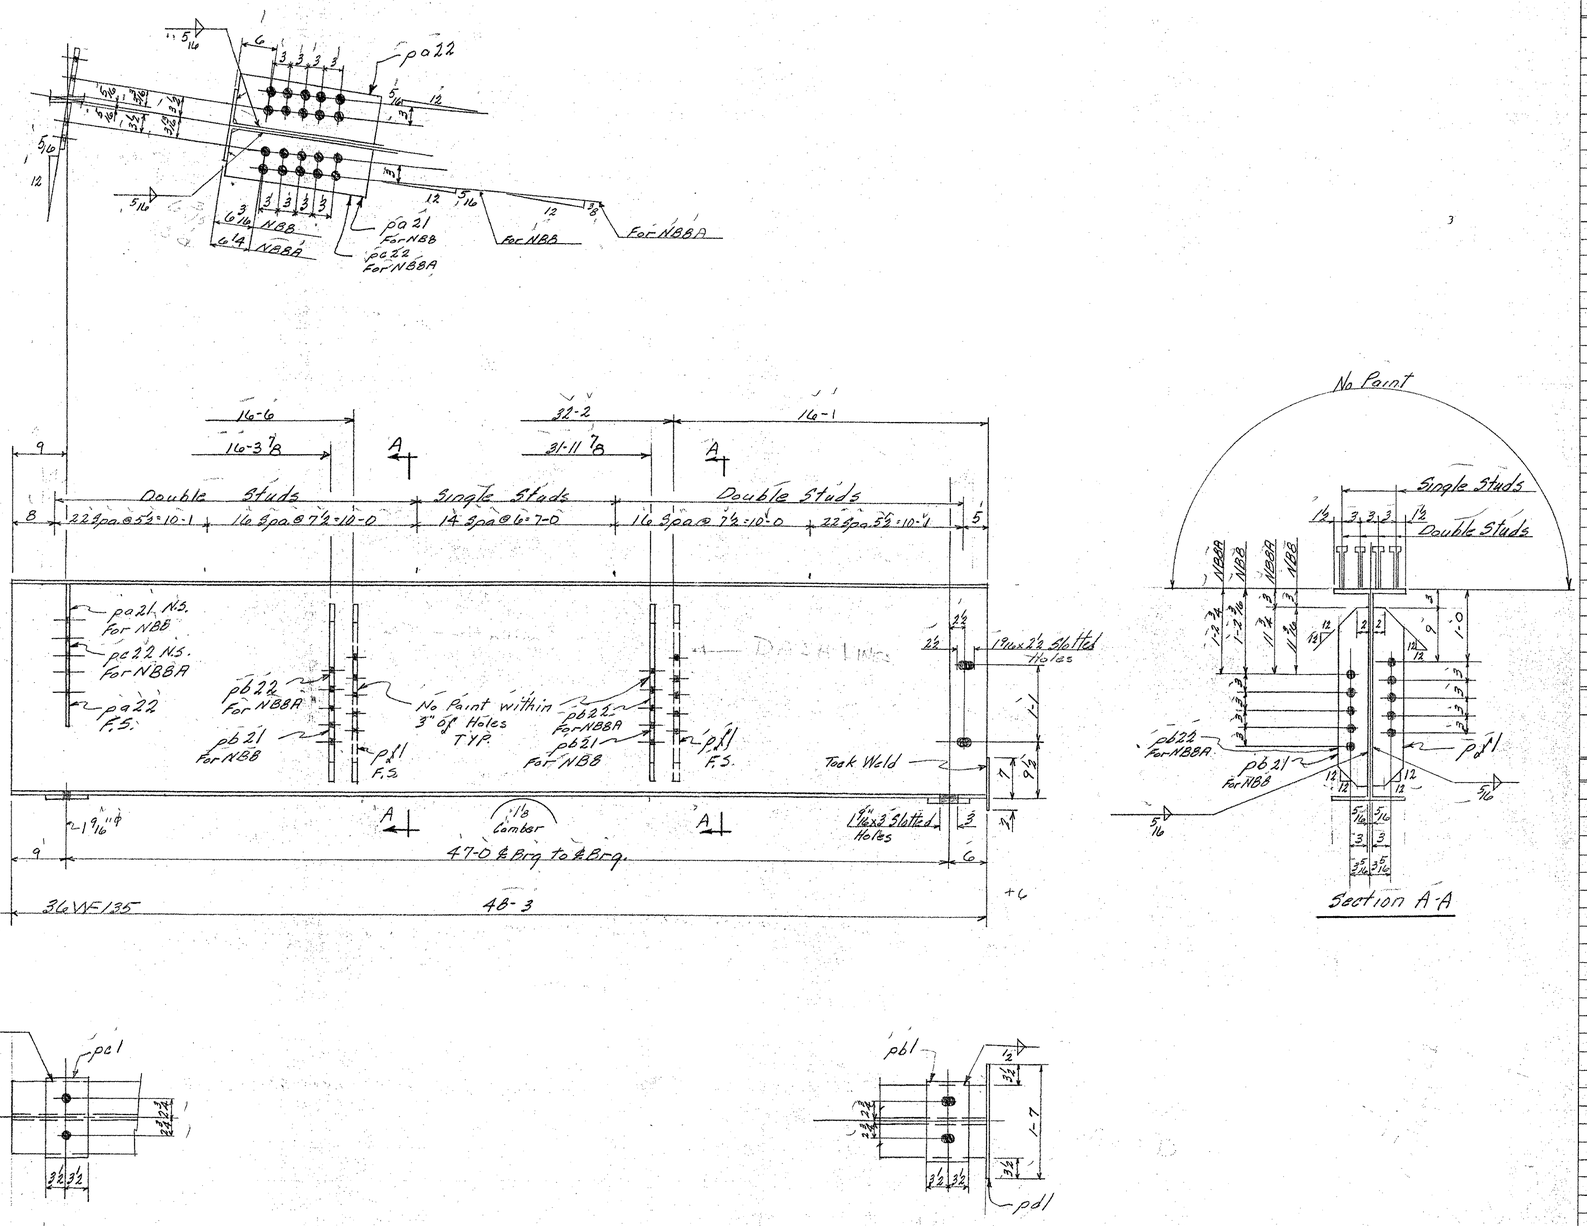

BRIDGE SHEET BR490
REFERENCE SHEET 36 OF 37
SHEET 242 OF 370

BILL OF MATERIAL

NO. PIECES	MARK	DESCRIPTION	LENGTH FT.	LENGTH IN.		WEIGHT

JOB NO. _____ SHEET NO. _____

BILL OF MATERIAL

ASTM-A36 (47)

NO. PIECES	MARK	DESCRIPTION	LENGTH FT.	LENGTH IN.		WEIGHT
1	NBBA	36WF135	48	3		
4	NBB	36WF135	48	3	ord. Backer	32,569 ✓
5	pb1	Bar 7x1	1	1	Res @ 20-0	
5	pc1	— do	1	1		258 ✓
5	pd1	PL 9x¼	1	7	Res PL 4 8x¼x10-0	64 ✓
4	pa21	Bar 8x½	2	6	ord. 50-0 B26639	109 ✓
18	pb21	Bar 5x½	2	6	Res @ 20-0	170 ✓
5	pa22	Bar 8x½	12	0	ord. 20-0 B26639	136 ✓
12	pb22	Bar 5x½	2	6	Res @ 20-0	43 ✓
4	pa22	Bar 8x½	2	0	ord. 20-0 B26639	27 ✓
10	pd1	Bar 5x½	2	6	Res @ 20-0	213 ✓
		½" Weld	11	8		~~48~~ ✓ 7
		5/16" Weld	150	0		~~54~~ ✓ 37
						~~33,653~~ ✓
						33,633
		Cont 66-1184-226				
1690		3/4" ⌀ Shear Studs	0	7	Stk	1698 1698 ✓
						35,351 ✓

VERMONT STRUCTURAL STEEL CORPORATION
BURLINGTON, VT.

Proj. No. I89-3(35)#2

		DATE
DRAWN BY	L.C.	11-22-66
OK'D BY	R.L.M.	11-29-66

HOLES 15/16" ⌀ As Noted
BOLTS None
PAINT Red Lead Vt. Spec. As Noted

PROJECT I89 Over Approach Road
LOCATION Georgia Fairfax Fairfield - St. Albans
CUSTOMER Lane Constr. Co.
ARCHITECT State of Vt. Dept of Highways
JOB NO. 66-I89-2(3) Str. St. SHEET NO. 36
66-1184-226 Shear Studs

PRINT RECORD NO.	FOR	DATE
3	APP	11-8
2 P	SHOP	11-29
2D	Shop	12-5
R	STATE	12-8
2	LANE	12-28

SM 10-63 QCP