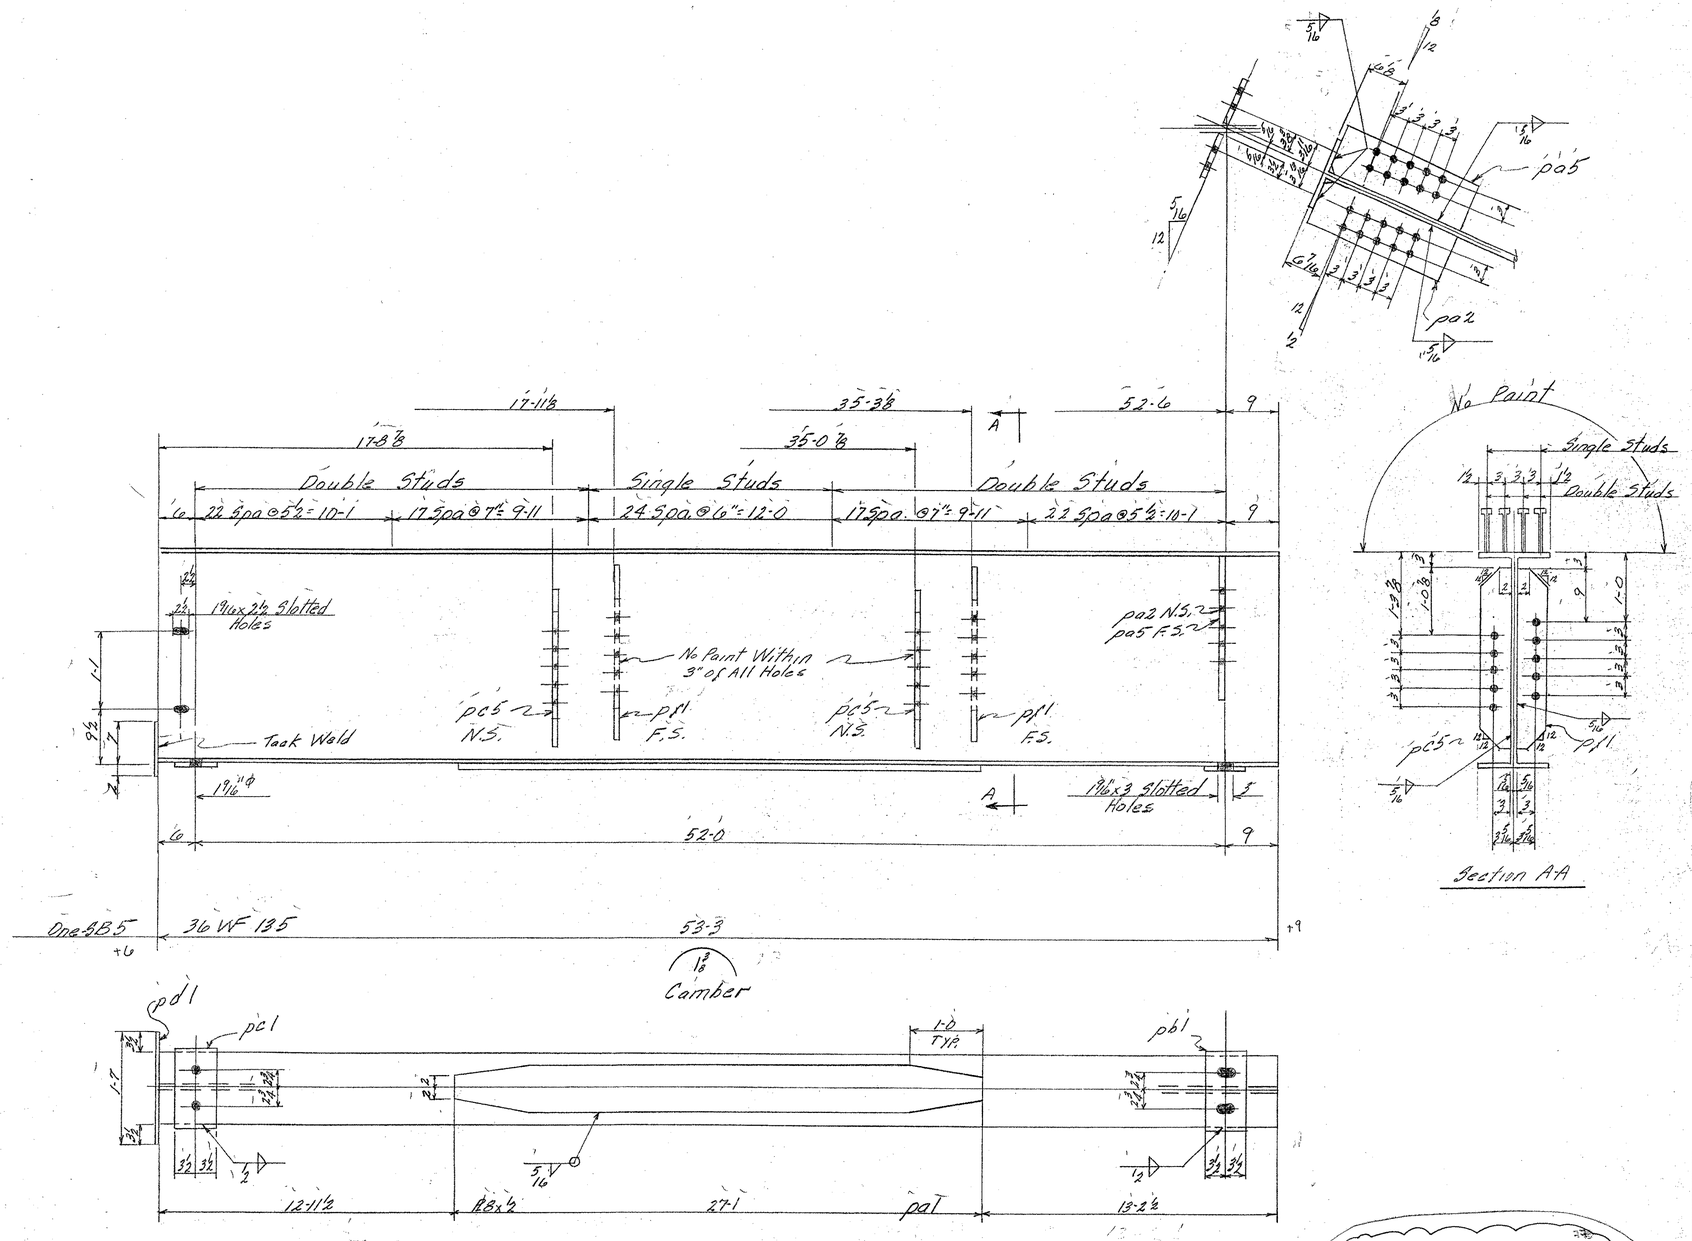

BRIDGE SHEET BR469
REFERENCE SHEET 15 OF 37
SHEET 221 OF 370

BILL OF MATERIAL

NO. PIECES	MARK	DESCRIPTION	LENGTH FT.	LENGTH IN.		WEIGHT	

JOB NO. _____ SHEET NO. _____

ASTM - A36

BILL OF MATERIAL

(17)

NO. PIECES	MARK	DESCRIPTION	LENGTH FT.	LENGTH IN.		WEIGHT	
		Beams					
1	36B5	36 WF 135	53	3	ord PBI-662	7189	✓
1	pa1	Bar 8 x ½	27	1	PB66-19	368	✓
1	pb1	Bar 7 x 1	1	1	Res @ 20'-0"		
1	pd1	do	1	1		52	✓
1	pd1	PL 9 x ¼	1	9	Res #485 x 6 x 10'-0	13	✓
2	pf1	Bar 5 x ½	2	6	Res @ 20'-0"	43	✓
1	pa5	Bar 8 x ½	3	0	ord @ 20'-0"		
1	pa2	do	3	0	PB66-19	54	✓
2	pc5	Bar 5 x ½	2	6	Res @ 20'-0"	43	✓
		½ ϕ Weld	2	4		2	✓
		5/16 ϕ Weld	84	9		21	✓
							7995
							7785
		Cont # 66-1189-226					
366		¾ ϕ x 4" Shear Studs	0	7	STK	368	368
							8163 ✓

VERMONT STRUCTURAL STEEL CORPORATION
BURLINGTON, VT.

Proj # 189-3(35) Cont # 2

		DATE
DRAWN BY	LC	10-10-66
OK'D BY	RLM	11-18-66

HOLES 13/16" ϕ As Noted
BOLTS None
PAINT Red Lead VT.
Specs As Noted

PROJECT I 89 Over Approach Road
LOCATION Georgia - Fairfax - Fairfield - St. Albans
CUSTOMER Lane Constr. Co.
ARCHITECT State Of Vt. Dept. Of Highways
JOB NO. 66-1189-200, 176-5 SHEET NO. 5
66-1189-226 Shear Stud.

PRINT RECORD		
NO.	FOR	DATE
3	APP	11-21
2 P	SHOP	11-21
8 O	Shop	12-5
2	STATE	12-8
2	LANE	12-28

SM 10-63 QCP