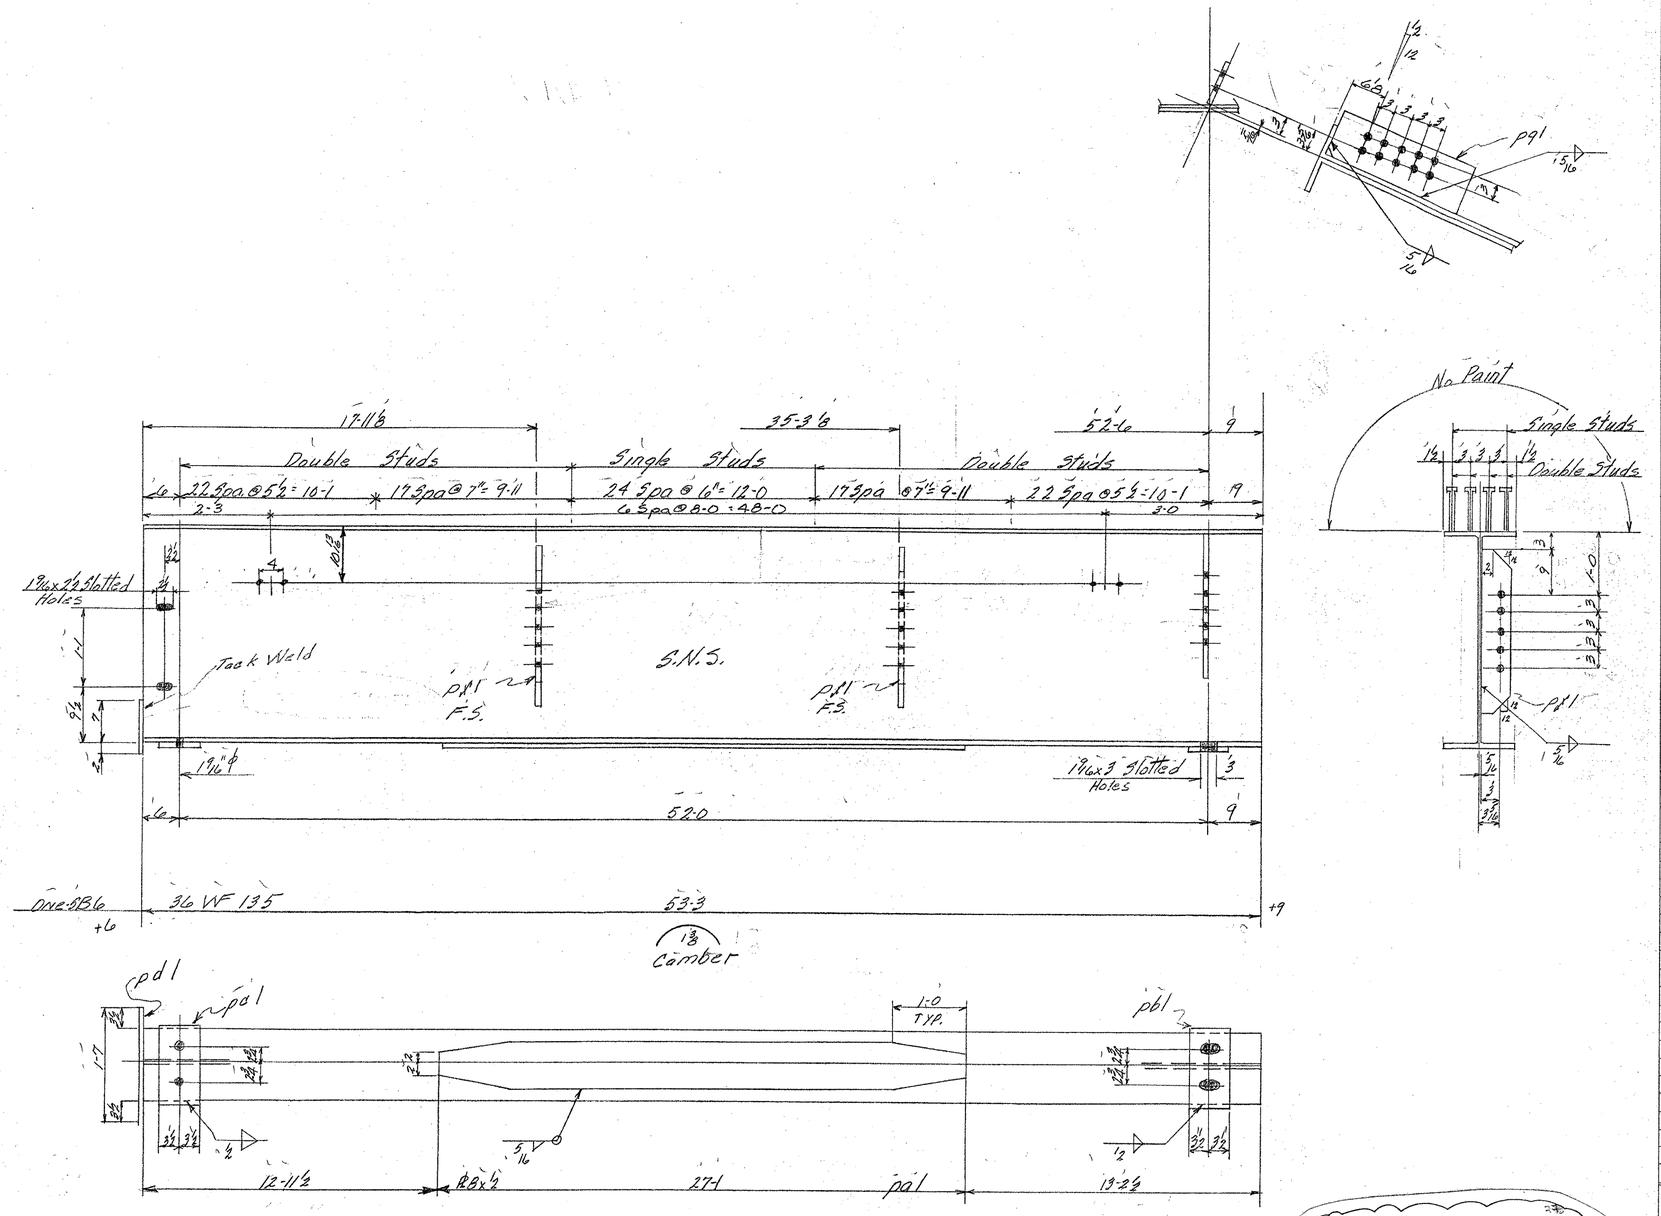

BILL OF MATERIAL

NO. PIECES	MARK	DESCRIPTION	LENGTH FT.	LENGTH IN.		WEIGHT	

JOB NO. _____ SHEET NO. _____

BILL OF MATERIAL

ASTM-A36

(17)

NO. PIECES	MARK	DESCRIPTION	LENGTH FT.	LENGTH IN.		WEIGHT	
		Beam					
1	Stb6	36 WF 135	53	3	ord BB6682	7189	✓
1	pdl	Bar 8 x 1/2	27	1	ASTM-A36-74	368	✓
1	pbl	Bar 7 x 1	1	1	Res 9-20-0		
1	pdl	do.	1	1		52	✓
1	pdl	PL 9 x 1/4	1	7	Res 12-48 x 1/4 x 10-0	13	✓
2	pfl	Bar 5 x 1/2	2	0	Res @ 20-0	43	✓
1	pgl	Bar 8 x 1/2	2	0	ord @ 20-0 ASTM-A36-74	27	✓
		1/2" ⌐ Weld	2	4		21	✓
		5/16" ⌐ Weld	169	10		~~55~~	✓17
							~~7719~~
							7711
		Cont. 66-1184-226					
	3/66	3/4" ϕ Shear Studs	0	7	STK	368	368 ✓
							8087

VERMONT STRUCTURAL STEEL CORPORATION
BURLINGTON, VT.

Proj. FB-3(35) Cont #2

		DATE
DRAWN BY	L.C.	11-10-66
OK'D BY	RLM	11-21-66

HOLES 15/16" ϕ Unless Noted
BOLTS None
PAINT Red Lead VT. Specs & as Noted

PROJECT I-89 Over Approach Road
LOCATION Georgia-Fairfax-Fairfield-St. Albans
CUSTOMER Lane Const. Co.
ARCHITECT State of Vt. Dept. of Highways
JOB NO. 66-1184-200 STRUCT. 66-1184-226 Shear Studs
SHEET NO. 6

PRINT RECORD		
NO.	FOR	DATE
3	APP	11-21
2 P	SHOP	11-21
2 Ⓟ	Shop	12-5
2	STATE	12-8
2	LANE	12-28

BRIDGE SHEET BR470
REFERENCE SHEET 16 OF 37
SHEET 222 OF 370

SM 10-63 GCP