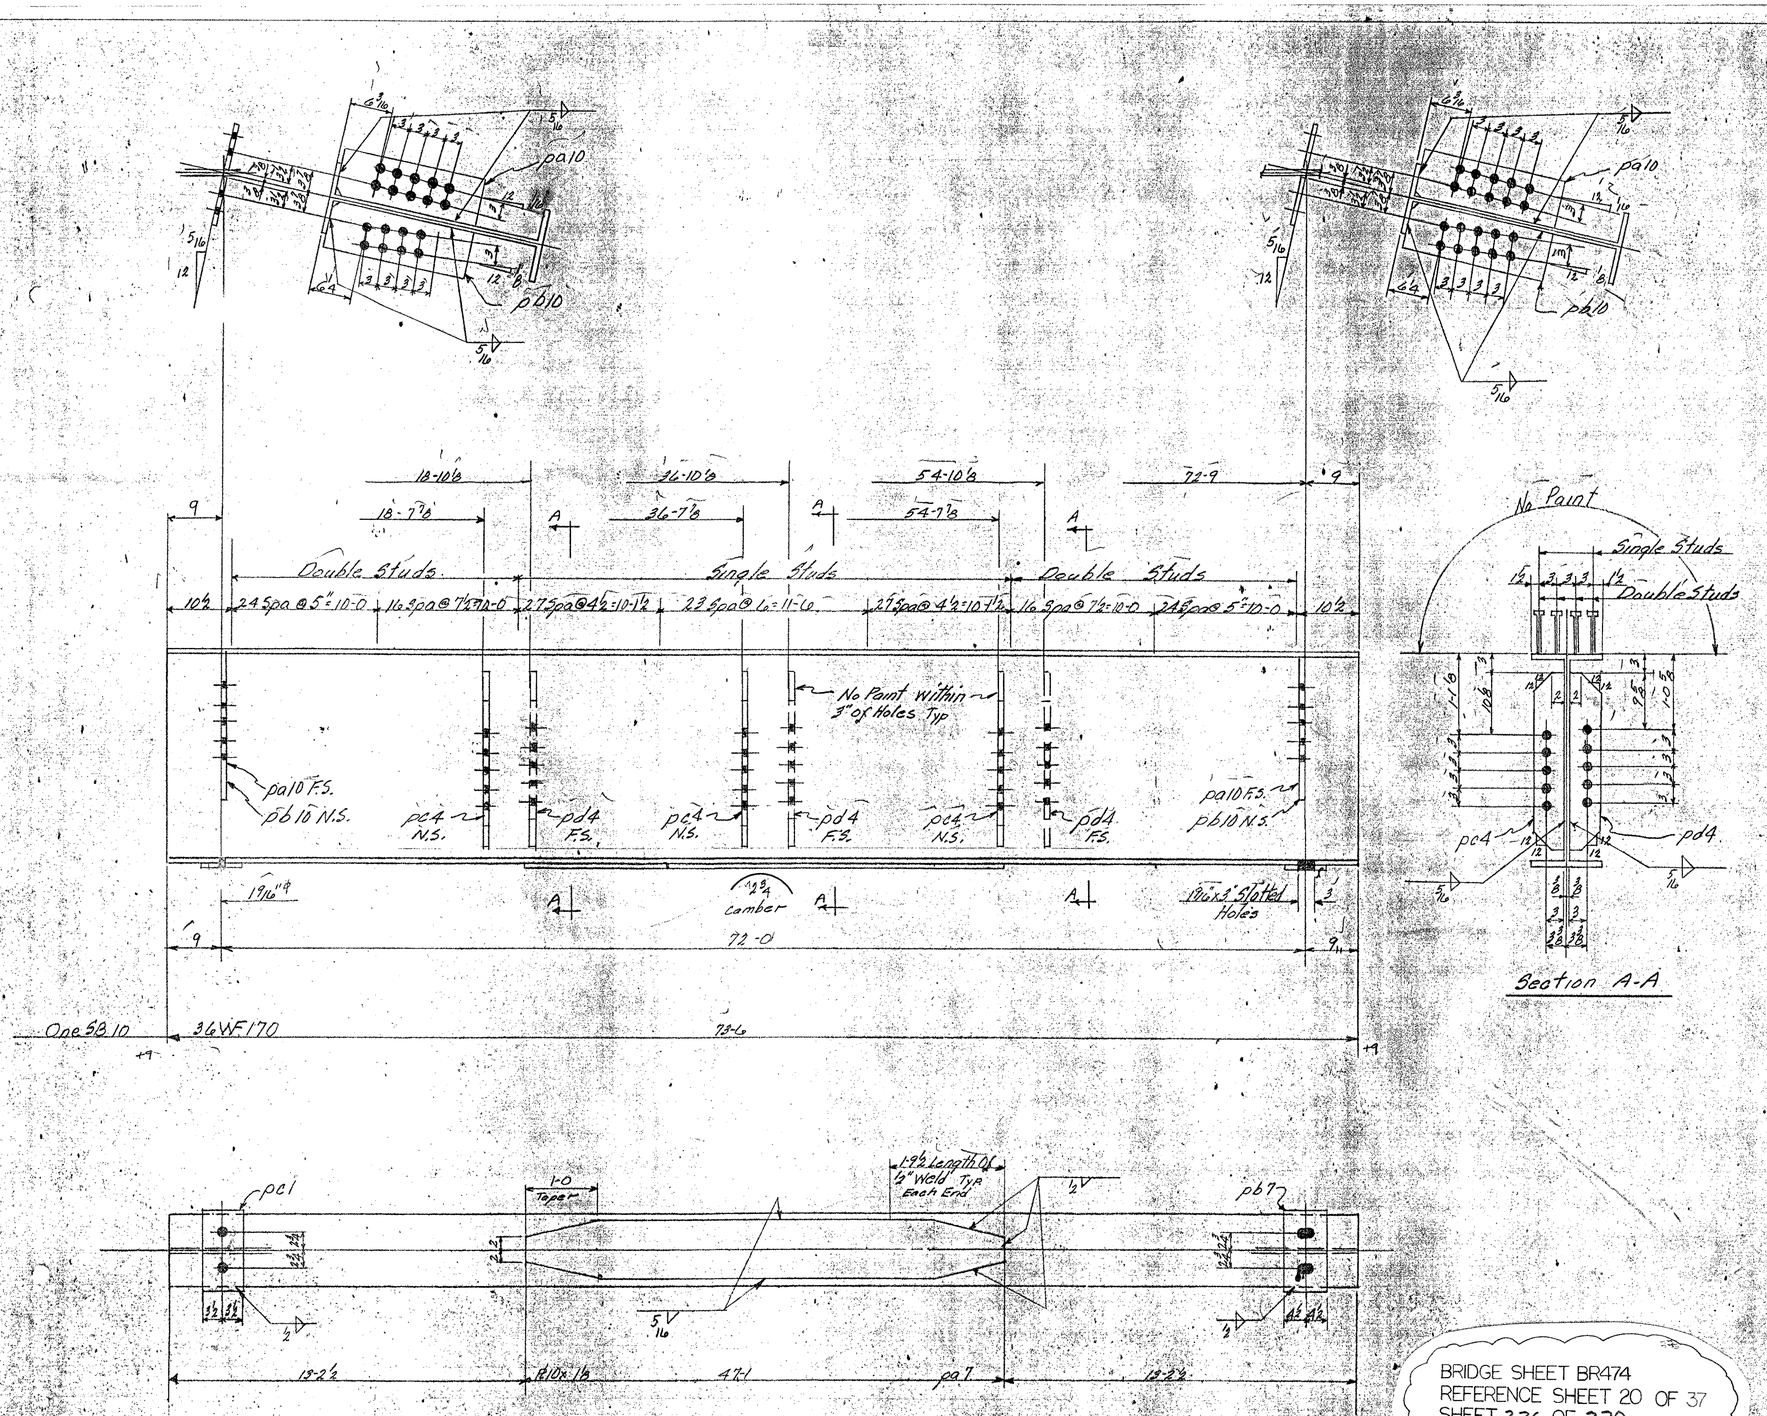

BRIDGE SHEET BR474
REFERENCE SHEET 20 OF 37
SHEET 226 OF 370

BILL OF MATERIAL

NO. PIECES	MARK	DESCRIPTION	LENGTH FT.	LENGTH IN.		WEIGHT	

JOB NO. SHEET NO. 17

ASTM-A36

BILL OF MATERIAL

NO. PIECES	MARK	DESCRIPTION	LENGTH FT.	LENGTH IN.		WEIGHT	
		Beams					
1	5B10	36 WF 170	73	6	ord 8266B2	12,495	✓
1	pa1	Bar 7x1	1	1	Rec @ 20-0	26	✓
1	pb7	R10x15	47	1	Regular Rolling @ 12-0	1832	✓
1	pb7	Pl 9x1½	1	1		53	✓
3	pa10	Bar 8x½	2	0	ord @ 20-0 BB6679	109	✓
2	pb10	do	2	0			
3	pc4	Bar 5x½	2	6	Rec @ 20-0	128	✓
3	pd4	do	2	6			
		½" Weld	11	0		~~9~~ 7	
		5/16" Weld	127	0		~~49~~ 38	
		Coat # 66-1189-326				14,684	~~14701~~
180		¾"ø Shear Studs	0	7	STK		~~482~~
							15,183

VERMONT STRUCTURAL STEEL CORPORATION
BURLINGTON, VT.

Proj # IDT-3(35) #2

		DATE
DRAWN BY	L.C.	11-11-66
CK'D BY	RLM	11-18-66

HOLES 15/16" ø As Noted
BOLTS None
PAINT Red Lead Vt. Spec. As Noted

PROJECT I89-Otter Approach Road
LOCATION Georgia-Fairfax-Fairfield-St. Albans
CUSTOMER Lane Constr. Co.
ARCHITECT State of Vt. Dept. of Highways
JOB NO. 66-1189-320 66-1189-326 STRUCT. SHEET NO. 10
Shear Studs

PRINT RECORD

NO.	FOR	DATE
13	APP	11-21
2	SHOP	11-21
20	Ship	12-6
1	STRUCT	12-8
2	LANE	11-29