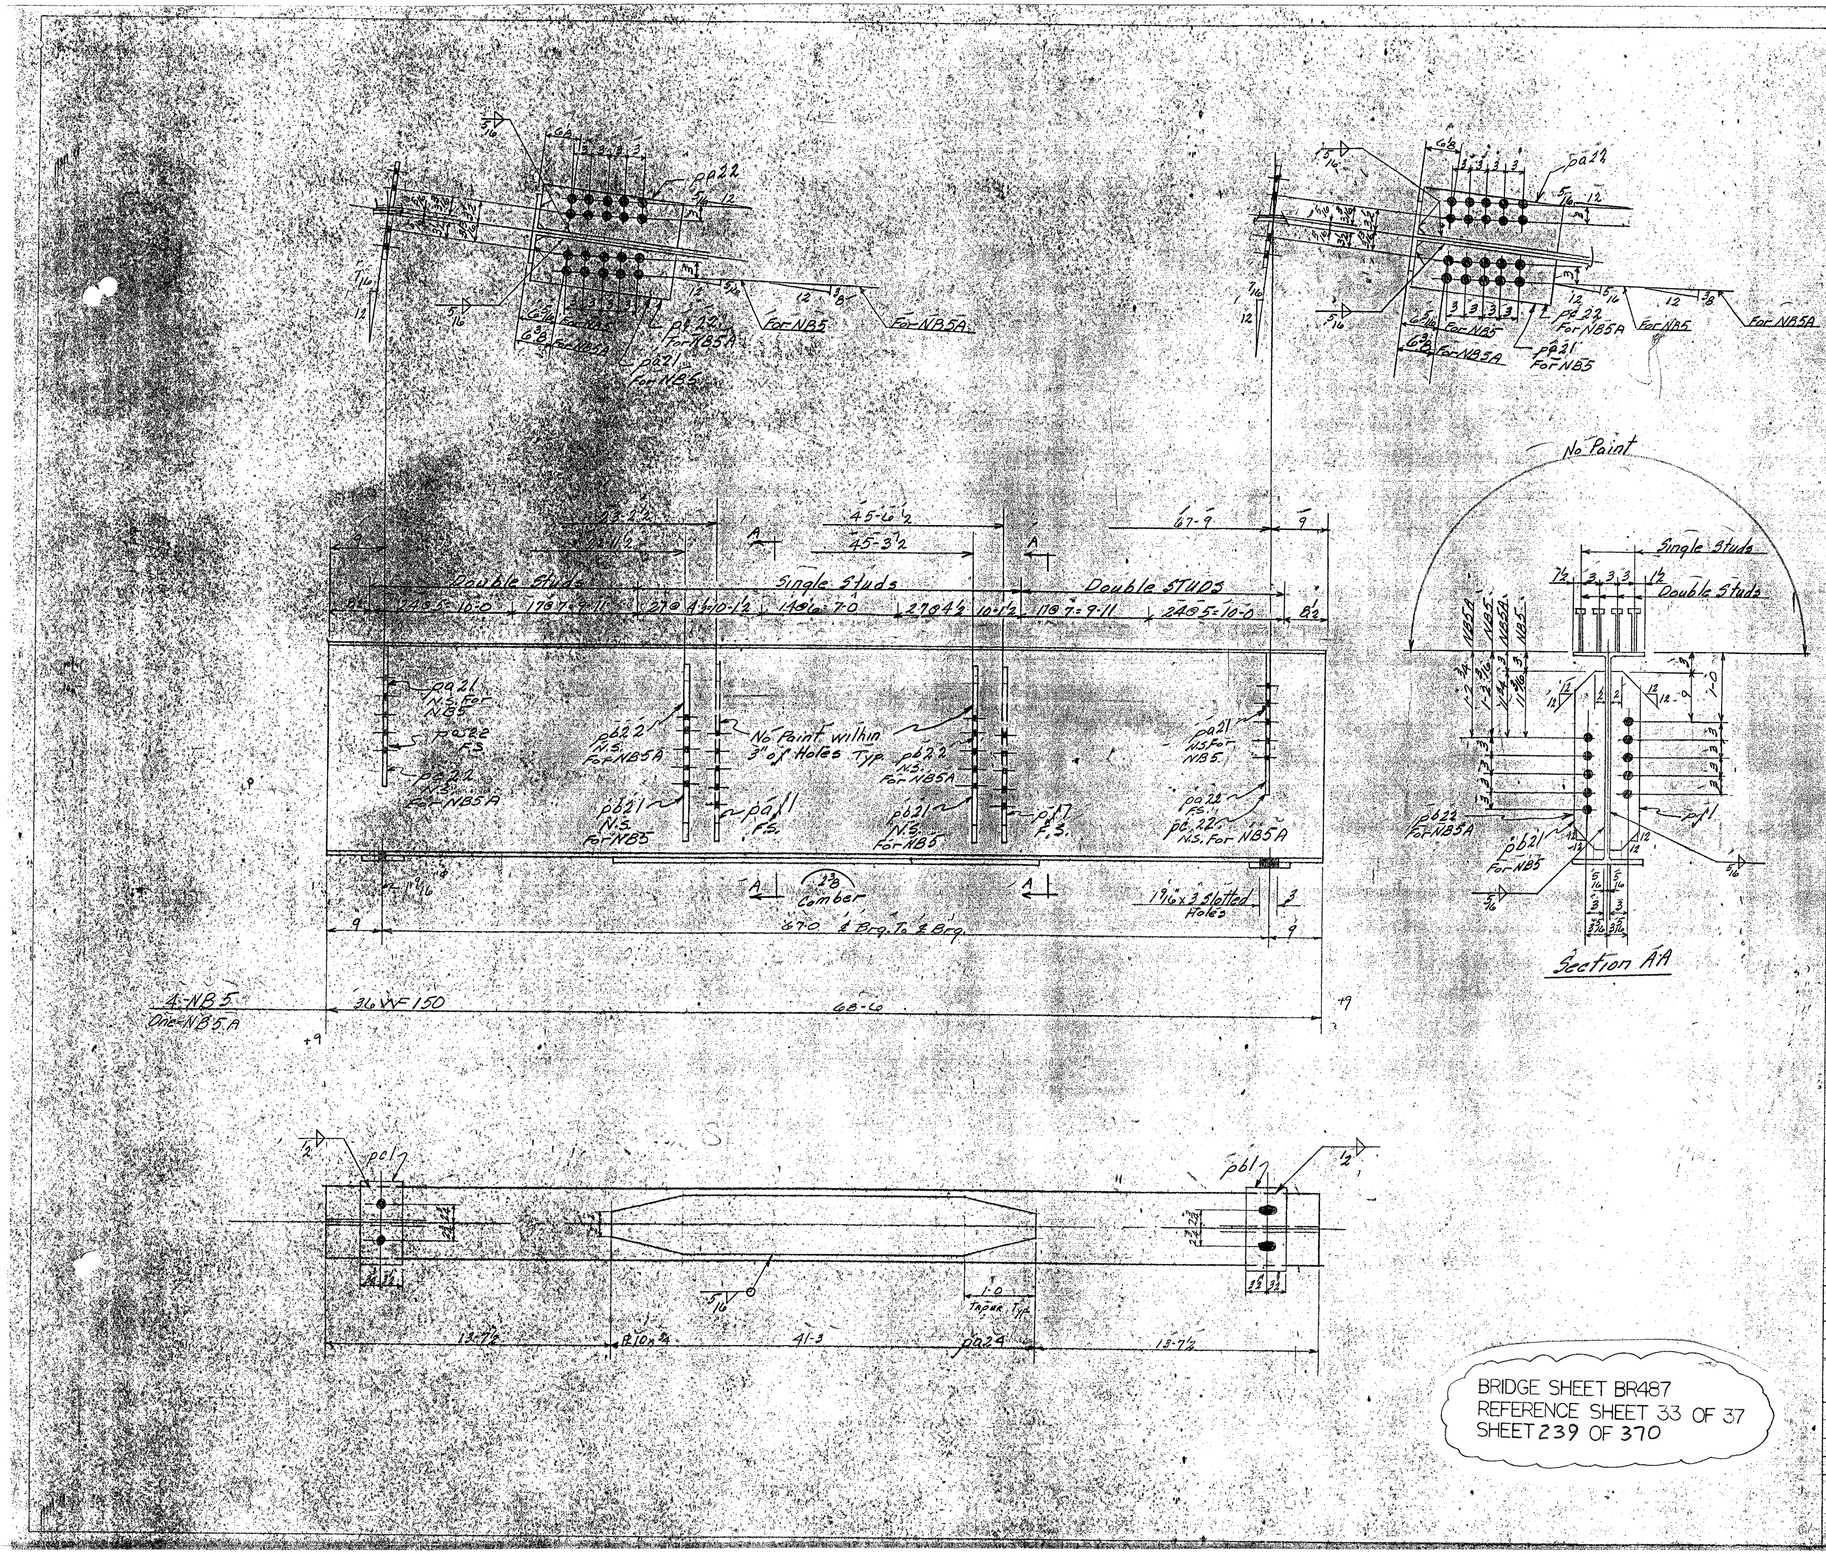

BRIDGE SHEET BR487
REFERENCE SHEET 33 OF 37
SHEET 239 OF 370

BILL OF MATERIAL

NO. PIECES	MARK	DESCRIPTION	LENGTH FT.	LENGTH IN.		WEIGHT	

JOB NO. _____ SHEET NO. _____

ASTM-A36

BILL OF MATERIAL

(17)

NO. PIECES	MARK	DESCRIPTION	LENGTH FT.	LENGTH IN.		WEIGHT	
		Beams					
4	NB5	36WF150	68	6	ord BB6682		
1	NB5A	do	68	6		51,375	✓
5	pa1	Bar 7x1	1	1	Ras@20-0		
5	pb1	do	1	1		258	✓
10	pa21	Bar 5x½	2	6	Ras@20-0		
8	pb21	do	2	6		383	✓
8	pa22	Bar 8x½	2	0	ord@20-0		
2	pa22	do	2	0	BB6677		
10	pa22	do	2	0		544	✓
5	pa24	PL 10x¾	41	3	ord BB6681	5351	✓
2	pb22	Bar 5x½	2	6	Ras@20-0	43	✓
		¼" Weld	11	8		~~70~~	✓7
		5/16" Weld	617	6		~~223~~	✓194
		Cont 66-1189-226					58186
							58,115
2362		3/4" ϕ Shear Studs	0	7	Stk	2362	2362✓
							60,548✓

VERMONT STRUCTURAL STEEL CORPORATION
BURLINGTON, VT.

Proj No. I89-3(35)72

		DATE
DRAWN BY	L.L.	11-21-66
CK'D BY	RLM	11-29-66

HOLES 3/4 ϕ As Noted
BOLTS None
PAINT Red Lead, Vt. Specs (As Noted)

PROJECT I89 Over Approach Road
LOCATION Georgia-Fairfax-Fairfield-St. Albans
CUSTOMER Lane Con Str. Co.
ARCHITECT State of Vt. Dept. of Highways
JOB NO. 66-1189-260 Str. St. SHEET NO. 23
66-1189-226 Shear Studs

PRINT RECORD		
NO.	FOR	DATE
3	APP	2-9
2	SHOP	11-29
1	Slip	12-5
2	STATE	12-8
2	LANE	12-28