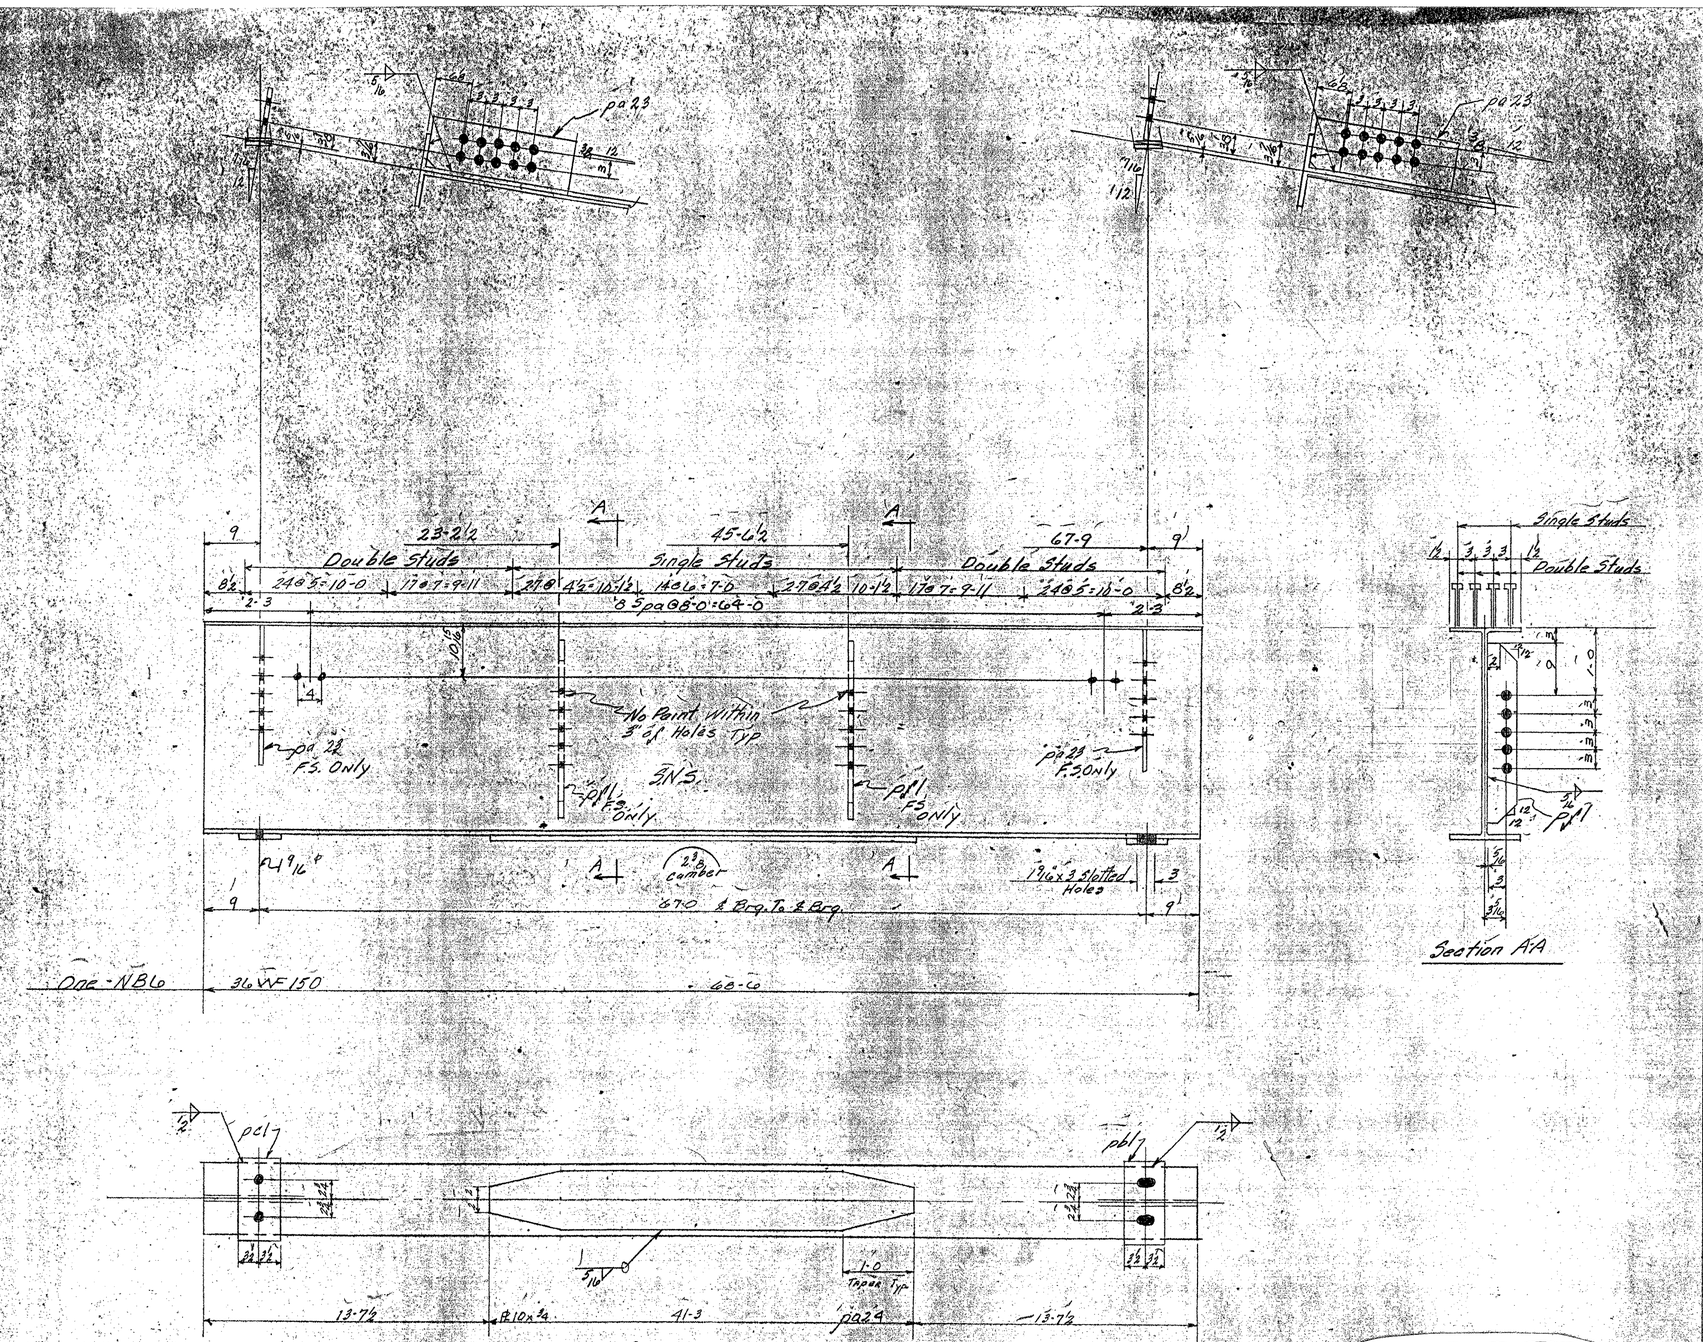

BRIDGE SHEET BR488
REFERENCE SHEET 34 OF 37
SHEET 240 OF 370

BILL OF MATERIAL

NO. PIECES	MARK	DESCRIPTION	LENGTH FT.	LENGTH IN.		WEIGHT

JOB NO. SHEET NO.

ASTM-A36

BILL OF MATERIAL (17)

NO. PIECES	MARK	DESCRIPTION	LENGTH FT.	LENGTH IN.		WEIGHT
		Beam				
1	NB16	36 WF 150	68	6	or Bill 81	10275
1	pb1	Bar 7x1	1	1	Res 020-0	
1	pc1	do	1	1		52
2	pf1	Bar 5x½	2	6	Res 020-0	43
2	pa23	Bar 8x½	2	0	or Bill 79	54
1	pa24	R10x34	41	3	or Bill 81	1070
		½" Weld	2	4		2
		5/16" Weld	103	6		~~37~~ 126
						~~11533~~
						11,522
		Cont 66-1184-226				
470		¾" Shear Studs	0	7	STK	472
						12,005

VERMONT STRUCTURAL STEEL CORPORATION
BURLINGTON, VT.

Proj. No. I89-3(35)72

		DATE
DRAWN BY	L.C.	11-21-66
CK'D BY	RLM	11-29-66

HOLES 15/16" as Noted
BOLTS None
PAINT Ballast. Vt. Specs. as Noted

PROJECT I89 Over Approach Road
LOCATION Georgia-Fairfax-Fairfield-St Albans
CUSTOMER Lane Const. Co.
ARCHITECT State of Vt. Dept. of Highways
JOB NO. 66-1184-200 Str. Stl. SHEET NO. 26
66-1184-226 Shear Studs

PRINT RECORD

NO.	FOR	DATE
3	APP	11-29
2	SHOP	11-29
2	Shop	12-5
2	STATE	12-8
2	LANE	12-29