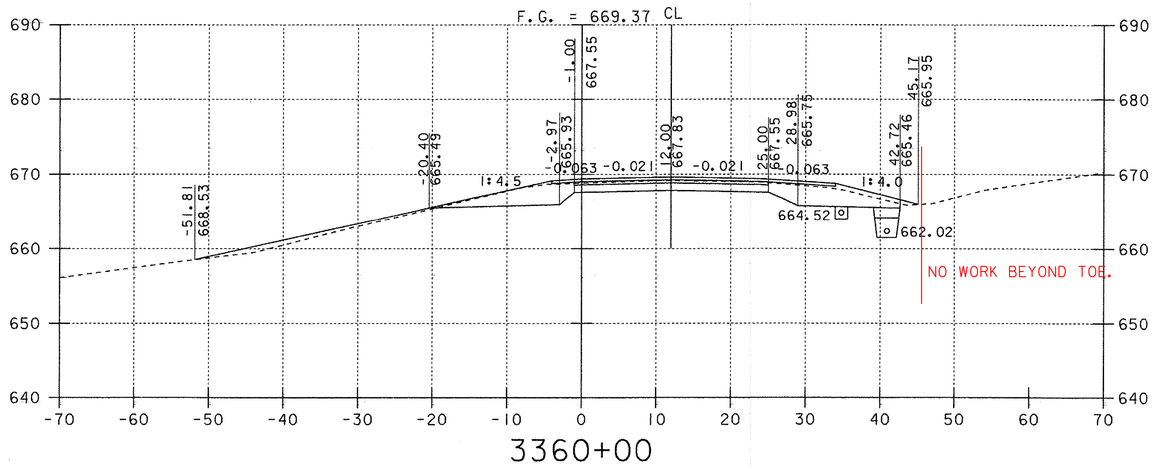


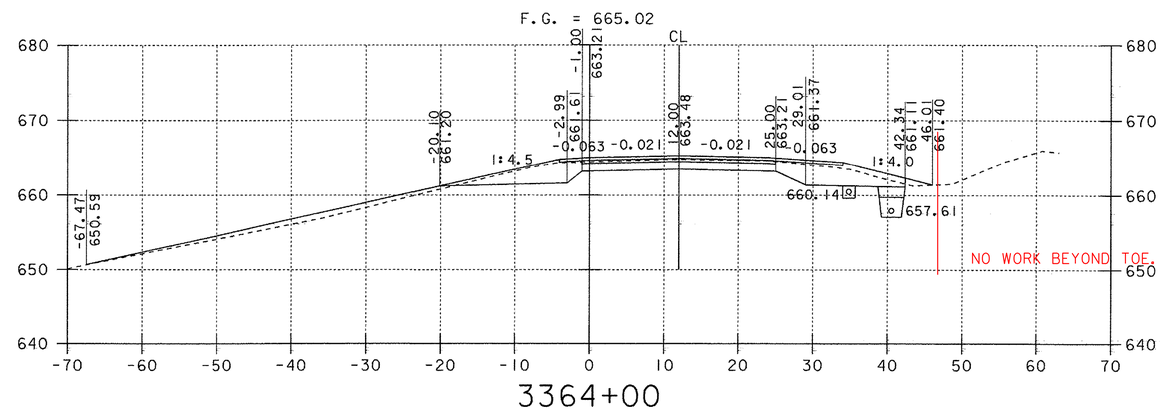


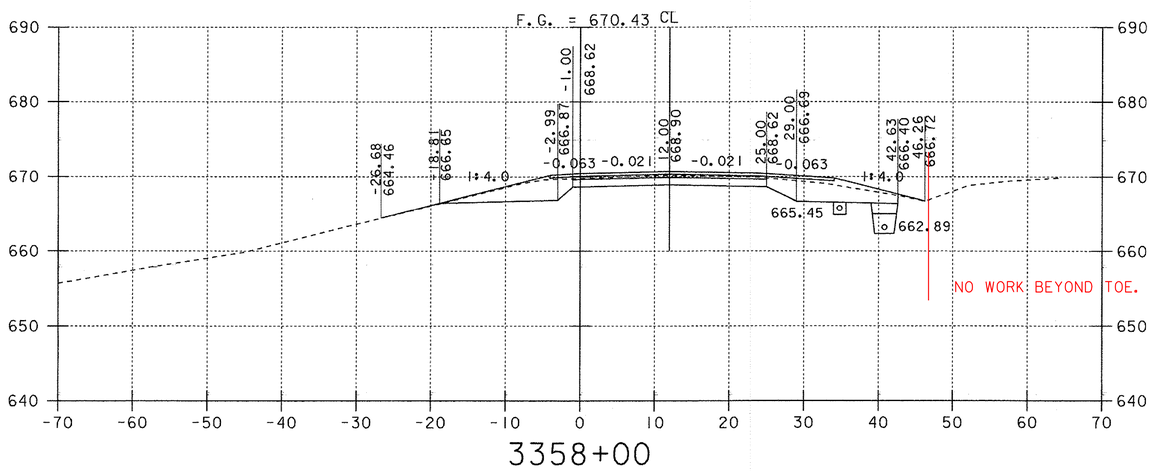


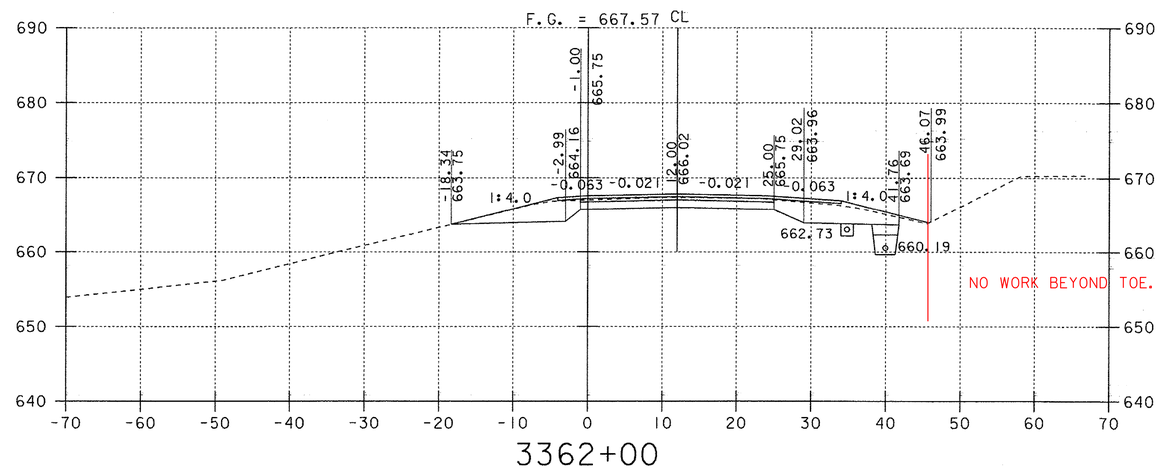


NOTE: OFFSET DISTANCES ARE MEASURED FROM THE GRADE LINE.

0 10 20
SCALE IN FEET

# NORTHBOUND CROSS SECTIONS

| | |
|---|---|
| PROJECT: FAIRFAX - FAIRFIELD - ST. ALBANS | PROJECT NO.: IM 089-3(27) |
| DESIGN FILE NAME: /87A007B/DESIGN/DA007XSI.DGN | |
| IPARM FILE NAME: DA007XIO | PLOT DATE: 25-JAN-2002 |
| SURVEYED BY: ORVIS | SURVEY DATE: 6/98 |
| SQUAD LEADER: DELLA SANTA | DRAWN BY: SQUAD B |
| | SHEET: 349 OF 370 |