ABM INFO PAGE	LINE	NO.	DESCRIPTION	FT	IN	ASSEM. MARK	SHIPPING MARK	REMARKS	WEIGHT
		2	DOWNSPOUT	5	0±		DS1		—
		1	DO	5	0±		DS2		—
		3	TS 8x8x¼	6	2½±1			ASTM A500-A501	
		3	BAR 4x⅜	1	3		SB1		
		6	DO	2	7±		SA1	BEND	
		6	¾"Φ THREADED ROD	1	0		BA1	BEND	
		12	¾"Φ HEX NUTS						
		12	¾"Φ WASHER						
		6	¾"Φ EXP. ANC		9		MA1	W/NEW.	

JOB NO. 132 DRG. NO. D1

PAY ITEM 506.60

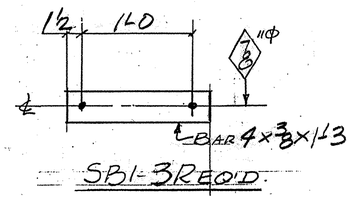

SB1-3 REQ'D

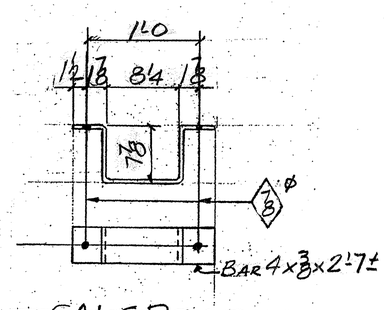

SA1-6 REQ'D

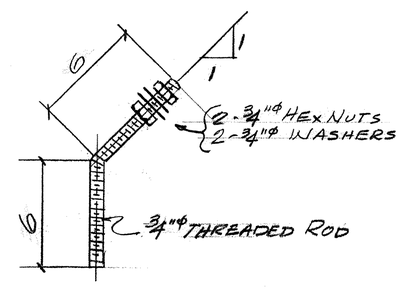

BA1-6 REQ'D

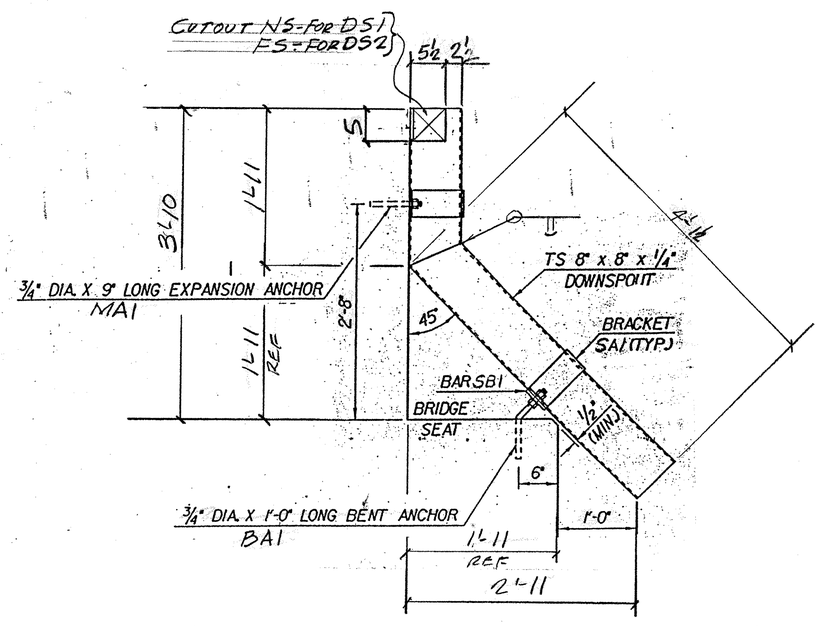

DS1-2 REQ'D (@ EAST END OF ABUT. 6 & 8)
DS2-ONE REQ'D (@ WEST END OF ABUT. 8)

VAOT
RECEIVED
CK'D BY ___ OK'D BY G. Roy 4-30-01
MAR 29 2001
RESUBMIT ___ APPROVED ✓
BY ___ DATE 4-17-01

REV.	REMARKS	DATE	DWN	CHK	APP	Q.A.	NO.	DIA.	LGT	TYPE	WASHER
	OUT FOR APPROVAL	3-23-01									
	OUT FOR APPROVAL										
	ISSUED TO SHOP										
	FIELD & OFFICE										

PROJECT NO. IM-089-3(27) STATE BRIDGE NO. 88S & 88N

MATERIAL: AASHTO M270-Gr36 ELECTRODES: PER PROC. HOLES: AS NOTED SHOP BOLTS: —

SURFACE PREP. & PAINT:

GALVANIZED AFTER FAB. PER ASTM-A-123

DESCRIPTION: DOWNSPOUTS ABUT. 5 & 8

JOB: BRIDGE 88S & 88N

I-89 OVER ST. ALBANS SO. STATE HIGHWAY

FAIRFAX → FAIRFIELD - ST. ALBANS, VT.

CUSTOMER: J.A. McDONALD

	DRAWN BY	DATE
	JPF	3-01
	CHKD BY	
	EJ	
	APPROV BY	
	Q.A.	

CASCO BAY STEEL STRUCTURES, INC.
75 SPRING HILL ROAD SACO, MAINE 04072
PHONE (207) 282-7360 FAX. (207) 282-1179

JOB NO. 132 DRG. NO. D1

440 REV. △