STATE OF VERMONT
AGENCY OF TRANSPORTATION

TRAFFIC SIGN SUMMARY SHEET

MILEMARKER, STATION, OR SIGN NUMBER	SIGN LEGEND	SIGN DIMENSIONS EA	SIGN DIMENSIONS WIDTH (in)	SIGN DIMENSIONS HEIGHT (in)	NEW & SALVAGED SIGNS "A"	NEW & SALVAGED SIGNS "B"	NEW & SALVAGED SIGNS SALV SIGN	NEW & SALVAGED SIGNS SALV TIS	EXIST POST RETAIN	EXIST POST SALVAGE	NEW SIGN POSTS NO. OF POSTS	FLANGED CHANNEL lb/ft 1.12	FLANGED CHANNEL lb/ft 2.0	FLANGED CHANNEL lb/ft 3.0	SQUARE STEEL (in) lb/ft 1.75 2.30	SQUARE STEEL (in) lb/ft 2.0 2.65	SQUARE STEEL (in) lb/ft 2.5 3.35	ANCHOR	SLEEVE	TUBULAR ALUMINUM Ø (in) lb/ft 3.0 1.3	TUBULAR ALUMINUM Ø (in) lb/ft 4.0 1.7	TUBULAR ALUMINUM Ø (in) lb/ft 4.0 MOD 1.7	FOUNDATION	TUBULAR STEEL Ø (in) lb/ft 3.0 7.6	TUBULAR STEEL Ø (in) lb/ft 3.5 9.0	TUBULAR STEEL Ø (in) lb/ft 4.0 10.8	TUBULAR STEEL Ø (in) lb/ft 5.0 14.6	W-SHAPE STEEL FTG. SIZE 24"	W-SHAPE STEEL FTG. SIZE 30"	W-SHAPE STEEL WEIGHT	W-SHAPE STEEL POST SIZE	SIGN FRAME REQUIRED	REMARKS	SIGN DETAIL DETAIL ON SHEET NUMBER	SIGN DETAIL STD. SHEET NUMBER
	SB I-89 MAINLINE CONT.																																			
SB 107.516 LT.		1	12"	36"	3						1			X 36			X	1																	OM-3		E-120
SB 107.215	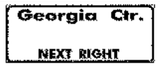	1	174"	66"		94.25					2																	X		420 337	6X12		SET BOLT TENSION TO 12.02	11	
SB 107.213 LT.		1	36"	36"	9						1			X 48			X	1																	R3-4		E-120
SB 107.052			96"	30"	20																															E-131
		1	162"	168"		189					2																		X	~~1500~~ 1507.5	12X30		SET BOLT TENSION TO 32.164	11	
		4	24" 24" 24" 24"	30" 24" 24" 24"	17																															E-132
SB 107.00		1	12"	48"	4						1			X 36			X	1																	D10-3		E-139
SB 106.789		1	18"	18"	2.25						1			X 36			X	1																	OM-1		E-150
SB 106.785		1	72"	60"		30					~~2~~												2		X 256.5											E-131
SB 111.0 +-		1	78"	78"		42.25					2												2		270.0											
	TEMPORARY SIGNS				195	140								960																						
												LB	LB	LB ~~100.5~~ 1116	LB	LB	LB ~~100.5~~	EA 4	LB	LB	LB	LB		LB	LB ~~162~~ 526.5	LB	LB								
	TOTALS				SF 55.25	SF 313.25	EA.	SF				LB ~~136.5~~ 1116			LB 136.5					LB			EA. ~~2~~ 4		LB ~~162~~ 526.5			EA. 2	EA. 2	LB ~~1920~~ 1895					
	GRAND TOTAL S.B.				166.25	488.75						~~496.50~~ 1626			496.50					72.8			~~2~~		~~162~~			4	2	~~3142~~ 3123					

FINAL POST LENGTHS ARE TO BE DETERMINED IN THE FIELD. POST SIZES ARE COMPUTED BASED ON INFORMATION FURNISHED ON THE STANDARD SHEETS AND THE TRAFFIC & SAFETY DIVISION'S "SIGN POST DESIGN GUIDELINE."

PROJECT: GEORGIA-FAIRFAX	PROJECT NO.: IM-089-3 (26)
DESIGN FILE NAME: /TRAF/JHK/IR089-3.DGN IPARM FILE NAME: /TRAF/JHK/ir0891s4.i SURVEYED BY: SQUAD LEADER: ABK TRAFFIC SHEET NO. 10 OF 14	PLOT DATE: 16-MAY-1997 SURVEY DATE: DRAWN BY: JHK SHEET: 40 OF 121