INDEX OF SHEETS
(SEE SHEET 2)

STATE OF VERMONT
AGENCY OF TRANSPORTATION

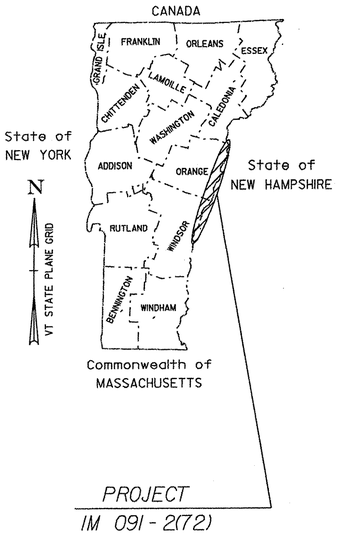

PROPOSED IMPROVEMENT

TOWNS OF HARTFORD - NEWBURY
COUNTIES OF WINDSOR & ORANGE
INTERSTATE 91 - LEDGE

PROJECT LOCATION: NORTHBOUND & SOUTHBOUND INTERSTATE BARRELS BEGINNING AT MM 69.96 AND EXTENDING NORTHERLY 41.00 MILES TO MM 110.96 AT THE NEWBURY/RYEGATE TOWNLINE AND EXIT 11 SOUTHBOUND OFF RAMP.

PROJECT DESCRIPTION: WORK TO BE PERFORMED UNDER THIS PROJECT INCLUDES SOLID ROCK EXCAVATION, SCALING, TRIM BLASTING, ROCK DOWELING, TRAFFIC CONTROL AND OTHER RELATED ITEMS.

LENGTH OR ROADWAY:	216,480.00 FT	41.00 MILES
LENGTH OF PROJECT:	216,480.00 FT	41.00 MILES

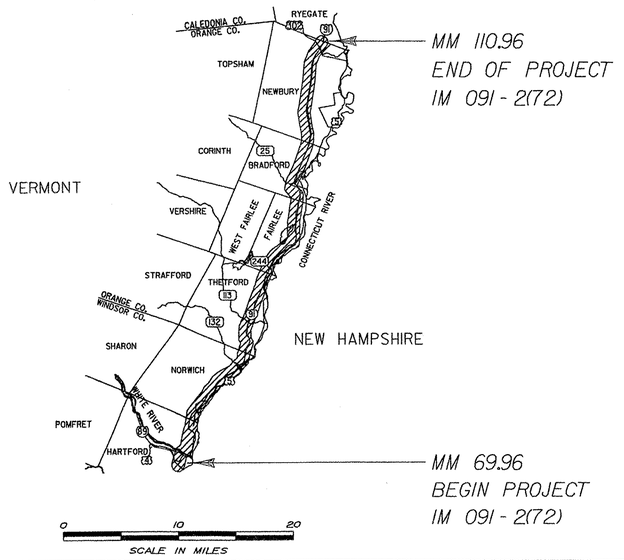

MM 110.96
END OF PROJECT
IM 091 - 2(72)

MM 69.96
BEGIN PROJECT
IM 091 - 2(72)

N
VT STATE PLANE GRID

RECORD PLANS

CONTRACTOR: J. A. MCDONALD INC. – LYNDON CENTER, VT
RESIDENT ENGINEER: PAUL PERRY
CONSTRUCTION BEGAN: SEPTEMBER 23, 2009
CONSTRUCTION COMPLETE: AUGUST 12, 2010
RECORD PLANS BY: PAUL PERRY & AMOS KEMPTON

I HEREBY CERTIFY THAT ALL THE CONSTUCTION REQUIRED BY THIS SET OF DRAWINGS HAS BEEN ACCOMPLISHED AS INDICATED HEREIN.

BY Paul K. Perry RESIDENT ENGINEER
DATE 8-1-11

NOTE: Any further information concerning final quantities, amounts or other details relative to this project may be found at Central Files in the electronic archives.

CONVENTIONAL SYMBOLS

COUNTY LINE
TOWN LINE
LIMITS OF ACCESS
POINT OF ACCESS
FENCE LINE
STONE WALL
TRAVELED WAY
GUARD RAIL
RAILROAD
SURVEY LINE
CULVERT
POWER POLE
TELEPHONE POLE
TREES
CONTROL OF ACCESS
PROPERTY LINE
R.O.W. TAKING LINE
SLOPE RIGHTS
TOP OF CUT
TOE OF SLOPE

SURVEYED BY :	VAOT- R. GILMAN
SURVEYED DATE :	2-2007

DATUM

VERTICAL	NAVD83
HORIZONTAL	NAVD83 (CONUS)

THESE PLANS ARE SUBJECT TO SUCH ENGINEERING CHANGES AS MAY BE REQUIRED BY THE FEDERAL HIGHWAY ADMINISTRATION OR THE DIRECTOR OF PROGRAM DEVELOPMENT.

CONSTRUCTION IS TO BE CARRIED ON IN ACCORDANCE WITH THESE PLANS AND THE STANDARD SPECIFICATIONS FOR CONSTRUCTION DATED 2006, AS APPROVED BY THE FEDERAL HIGHWAY ADMINISTRATION ON JUNE 15, 2006 FOR USE ON THIS PROJECT, INCLUDING ALL SUBSEQUENT REVISIONS AND SUCH REVISED SPECIFICATIONS AND SPECIAL PROVISIONS AS ARE INCORPORATED IN THESE PLANS.

DIRECTOR OF PROGRAM DEVELOPMENT
APPROVED Richard Farnsworth DATE 7-27-09

PROJECT MANAGER : KEN UPMAL

PROJECT NAME : HARTFORD-NEWBURY
PROJECT NUMBER : IM 091 - 2(72)

SHEET 1 OF 45 SHEETS