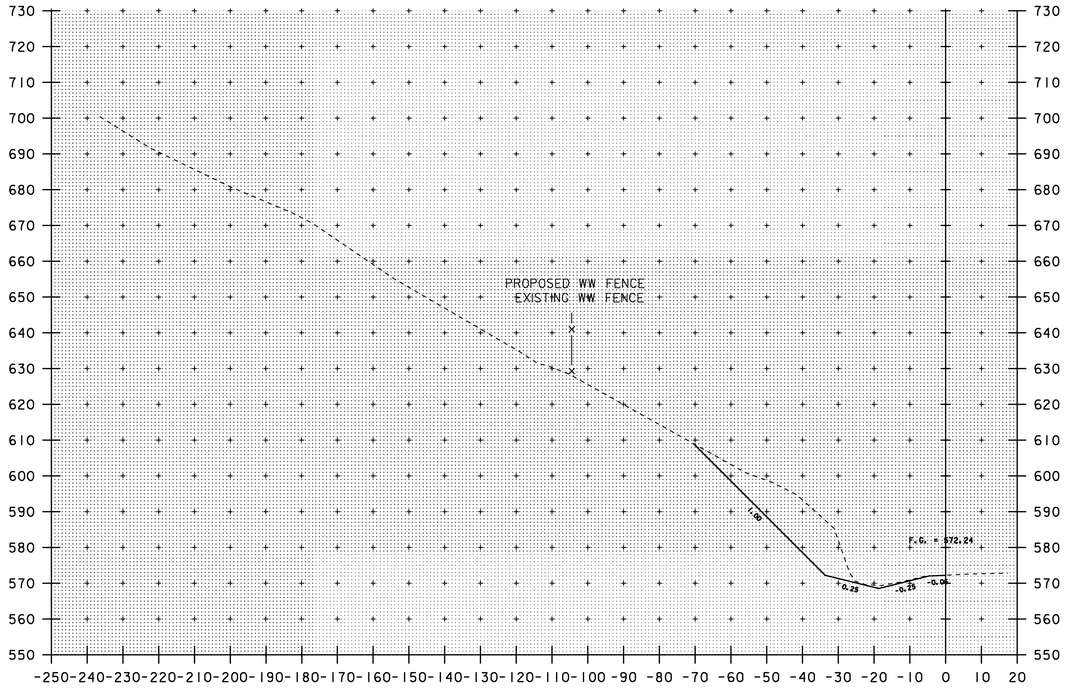

4596+50

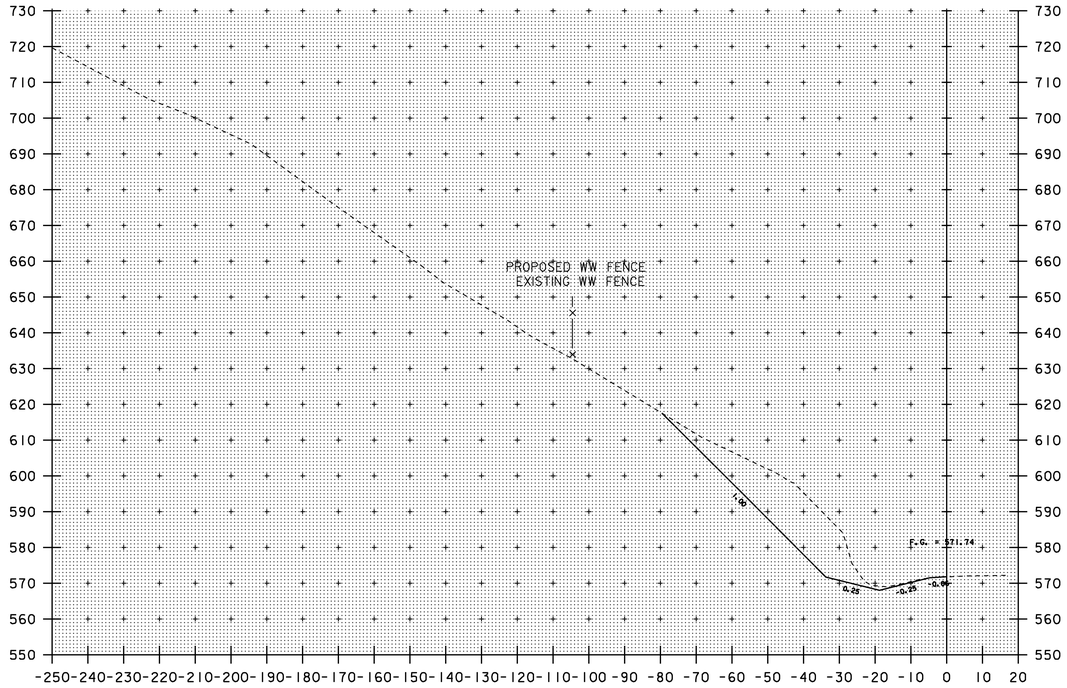

4597+00

0 20 40
SCALE IN FEET

NOTE: ALIGNMENT IS THE CENTER OF THE SHOULDER LINE AND EDGE OF PAVEMENT.

MM 86.63 - MM 86.75

SOUTHBOUND CROSS SECTIONS #3

PROJECT NAME:	HARTFORD - NEWBURY
PROJECT NUMBER:	IM 091-2(72)

FILE NAME:	d99a052_bdr_xs.dgn	PLOT DATE:	21-JUL-2009
PROJECT LEADER:	K. UPMAL	DRAWN BY:	N. PAPPAS
DESIGNED BY:	N. PAPPAS	CHECKED BY:	A. BOMBARDIER
IPARM FILE NAME:	d99a052_bdr_xs_sb_03	SHEET	32 OF 45