TEMPORARY AND DURABLE 150mm WHITE LINE

EXIT 23	
NORTHBOUND ON RAMP "D"	SOLID RT √
NORTHBOUND ON RAMP "D"	DASHED LANE LINE √

TEMPORARY AND DURABLE 150mm YELLOW LINE

EXIT 23	
NORTHBOUND ON RAMP "D"	SOLID LT √

TEMPORARY AND DURABLE 300mm WHITE LINE

EXIT 23	
NORTHBOUND ON RAMP "D"	SOLID LT √

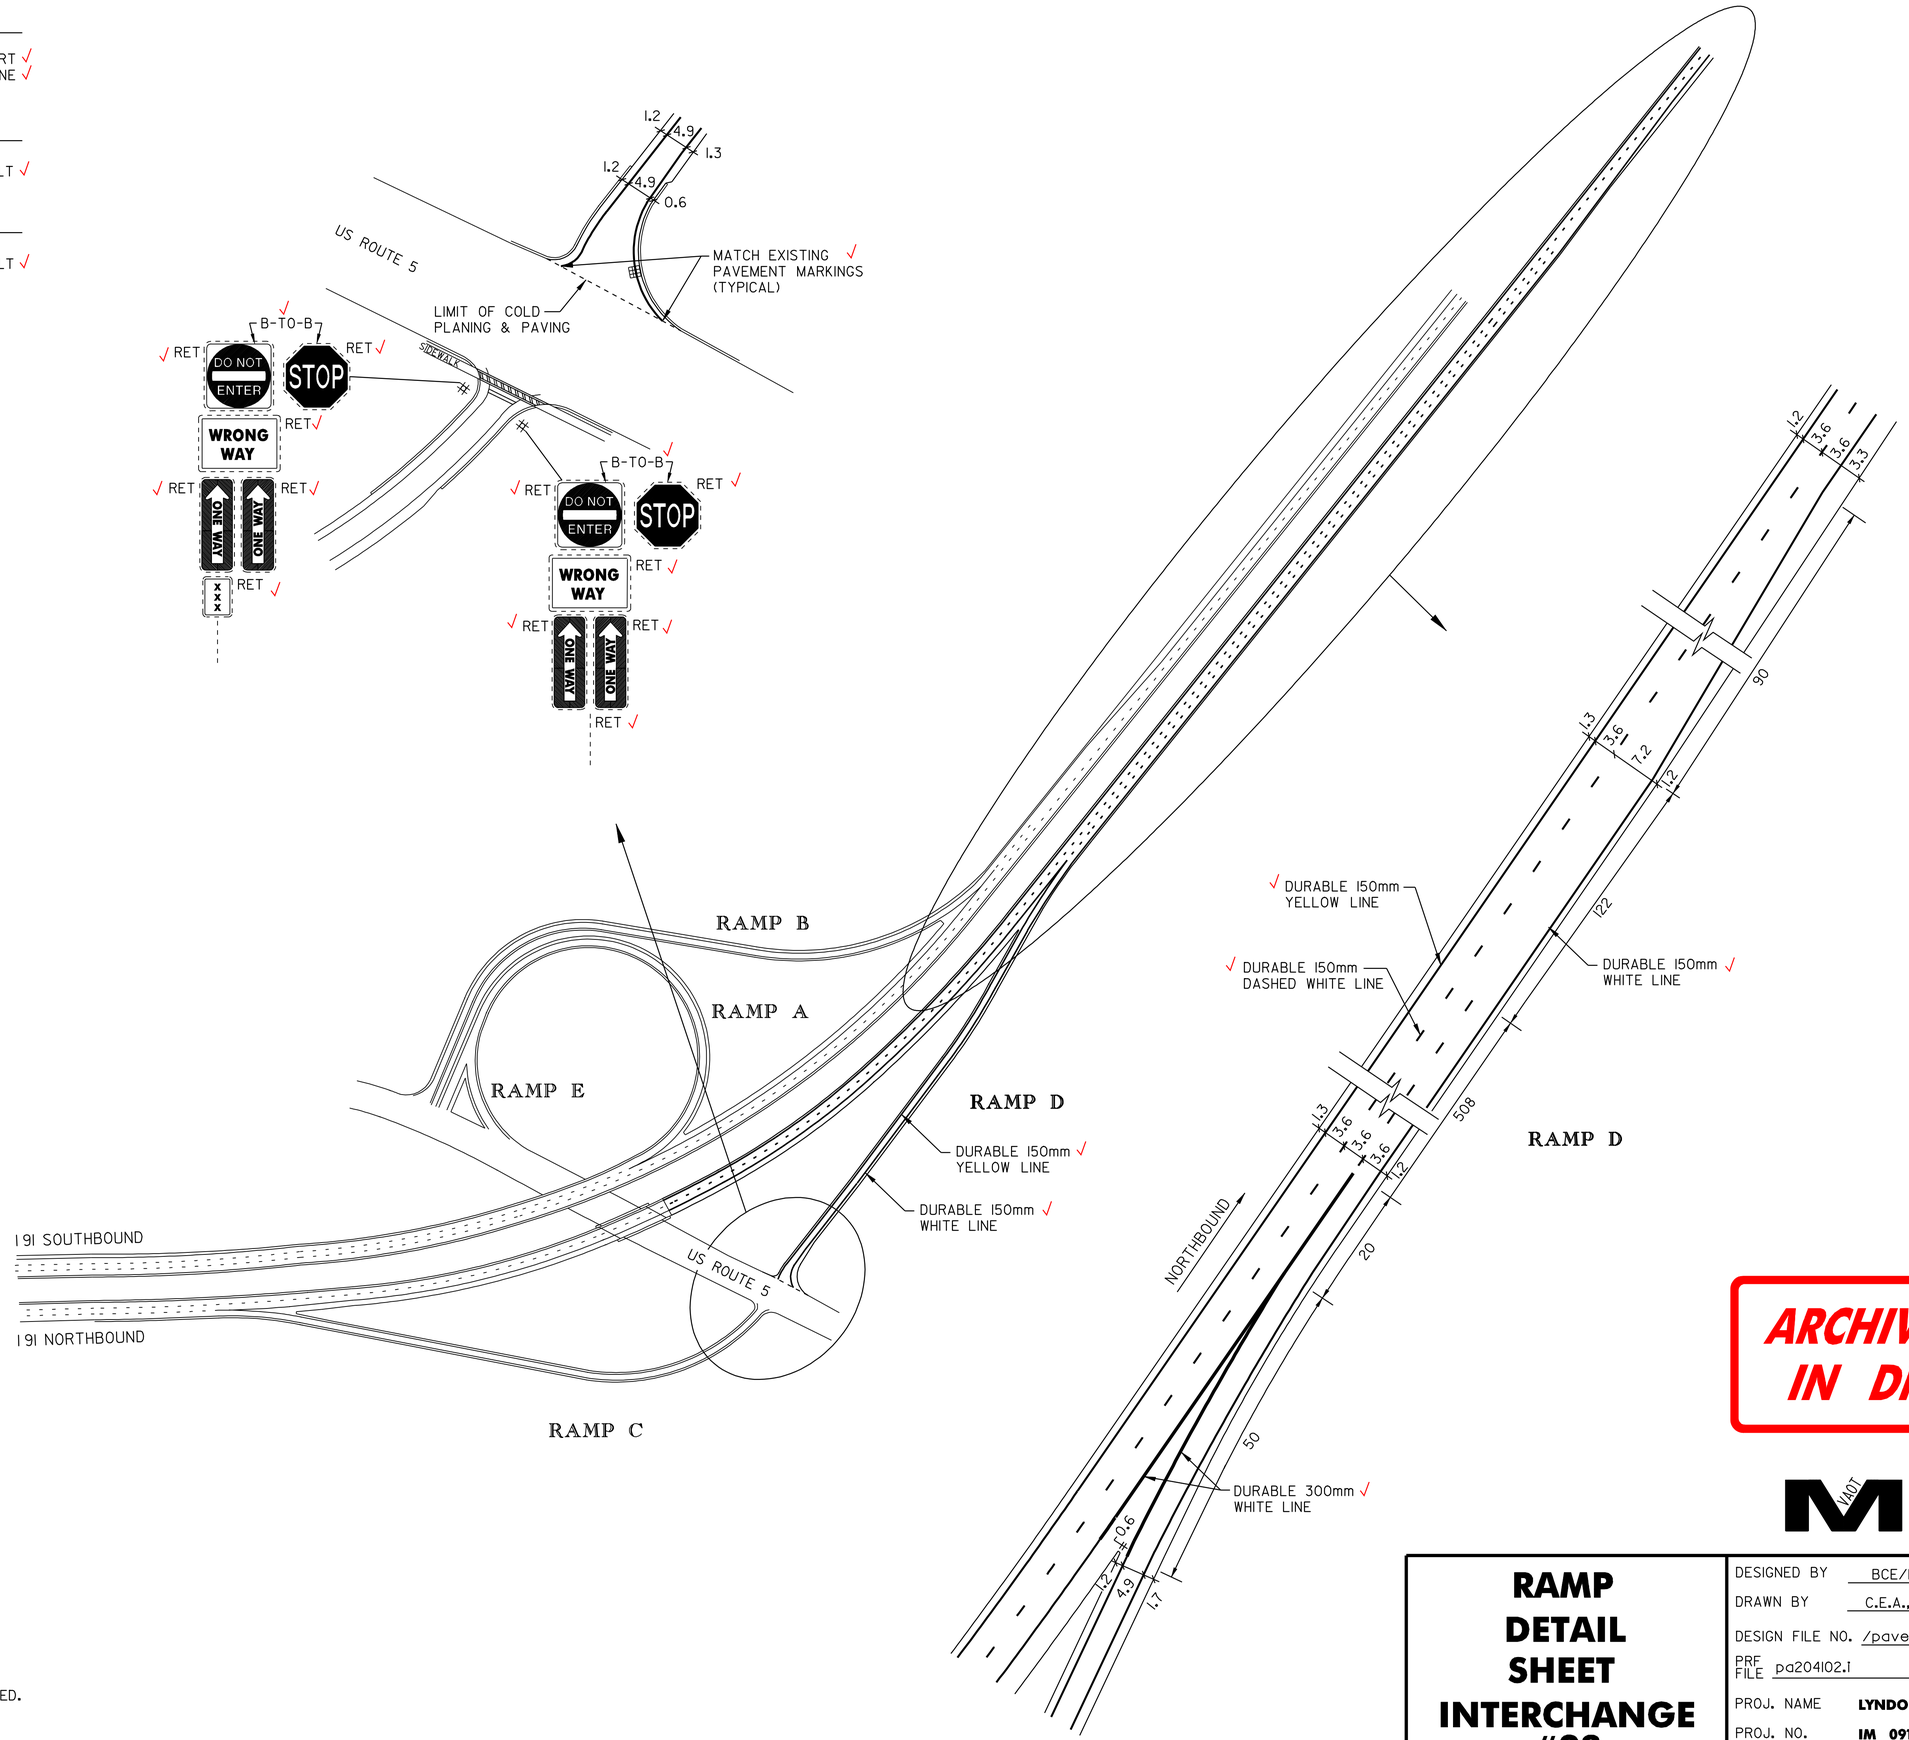

ARCHIVED IN DPR

VAOT Metric

NOTE: ALL DIMENSIONS IN METERS UNLESS OTHERWISE NOTED.

REFER TO STANDARDS E-191M & E-192M FOR ADDITIONAL DETAILS.

RAMP DETAIL SHEET INTERCHANGE #23

DESIGNED BY	BCE/PJM	DATE	9-00
DRAWN BY	C.E.A., INC.	DATE	9-00
DESIGN FILE NO.	/pave/99a204/pa204.dgn		
PRF FILE	pa204102.1	DATE PLOTTED	03-APR-2008 15:03
PROJ. NAME	LYNDON - BARTON		
PROJ. NO.	IM 091 - 3(10)		
SHEET 8 OF 17 SHEETS			