BARKER STEEL LLC
a HarrisRebar Company
CANAAN

DATE	REV. NO.	DESCRIPTION	DATE	SENT FOR
			08/18/08	APPROVAL

GRADE OF STEEL
LAP CHART
CLASS DIA'S
#3= #8=
#4= #9=
#5= #10=
#6= #11=
#7=

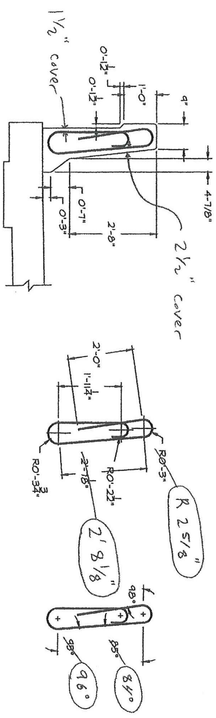

Revised Bar Detail

Note: All dimensions are to outside of bar.

Rev. 8-19-08 Beck + Bellucci

DRAWING COVERS BRIDGE RAILS REINFORCEMENT	PROJECT VT BRIDGE RAILS PROJECT IM 084-1 (20)	CUSTOMER		
ARCHITECT	LOCATION BERLIN VT	DRAWN BY: CPS	APPR. DATE:	JOB NO. VT RAIL
ENGINEER	REFERENCE DWGS:	REVIEWED BY:	DATE SUB. 08/14/08	DWG. NO. R01

Rev.#1 8/18/08