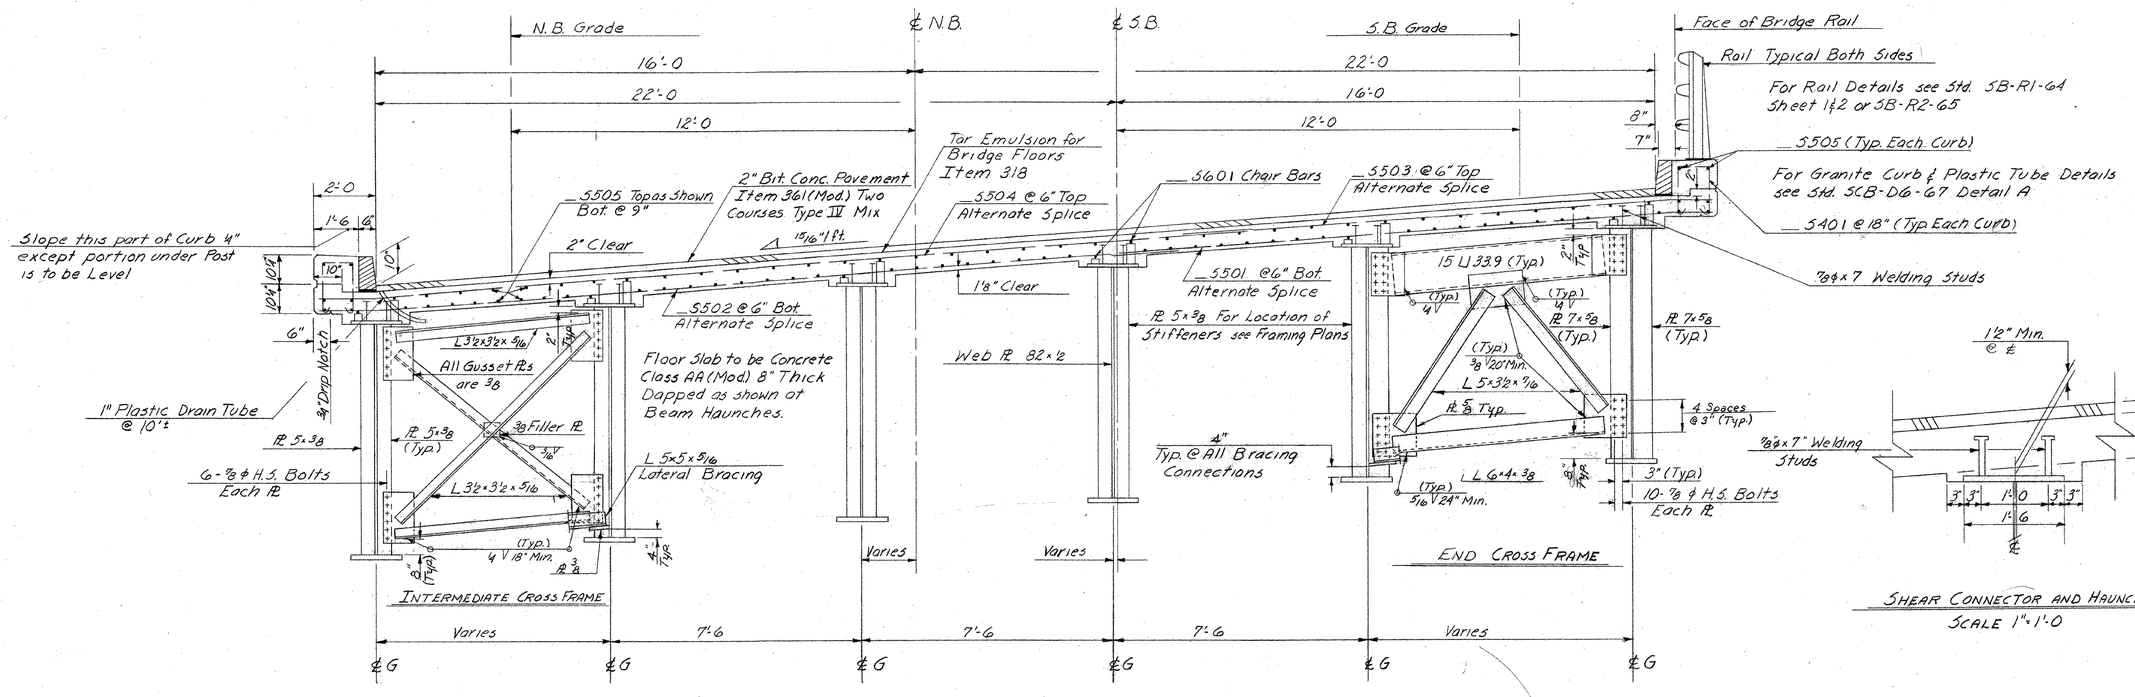

TYPICAL SECTION
SCALE ½" = 1'-0

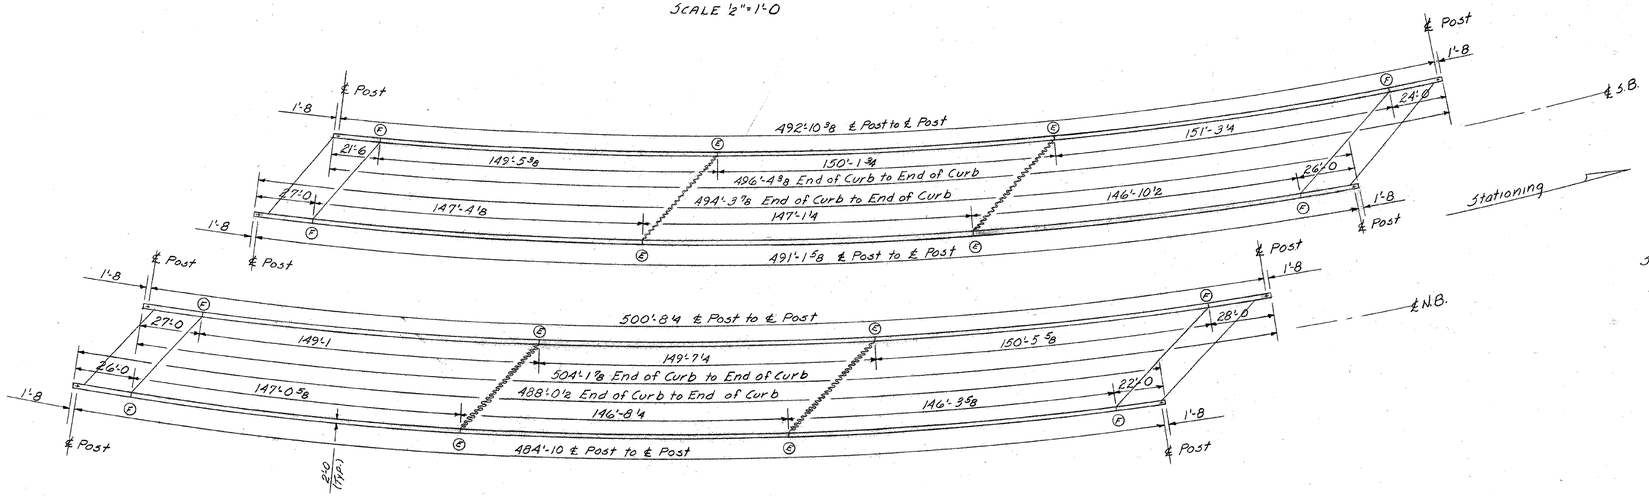

CURB AND RAILING PLAN
SCALE 1" = 30'-0

See BR. 400 for General Notes

All Dimensions are Arc Dimensions
Ⓔ Provide 3" expansion in railing across this joint
Ⓕ Provide ¾" expansion in railing across this joint

THIS SHEET FOR REFERANCE ONLY
BERLIN IM 089-1(20)
BRIDGES 40 N&S

SHEET 83 OF 104

STATE OF VERMONT
DEPARTMENT OF HIGHWAYS

PROJECT BERLIN-MONTPELIER
TOWNS OF BERLIN & MONTPELIER
ROUTE NO. I-89 STA. 193+50±
I-89 OVER VT. RTE. #12
TYPICAL SECTION AND CURB & RAILING PLAN
SCALE AS SHOWN
IN CHARGE W. SMITH
DRAWN BY E. GILMAN CHECKED BY W. TRIPP 11-67
PROJECT NO. I-89-1(12)
SHEET 157 OF 492 BR. 406