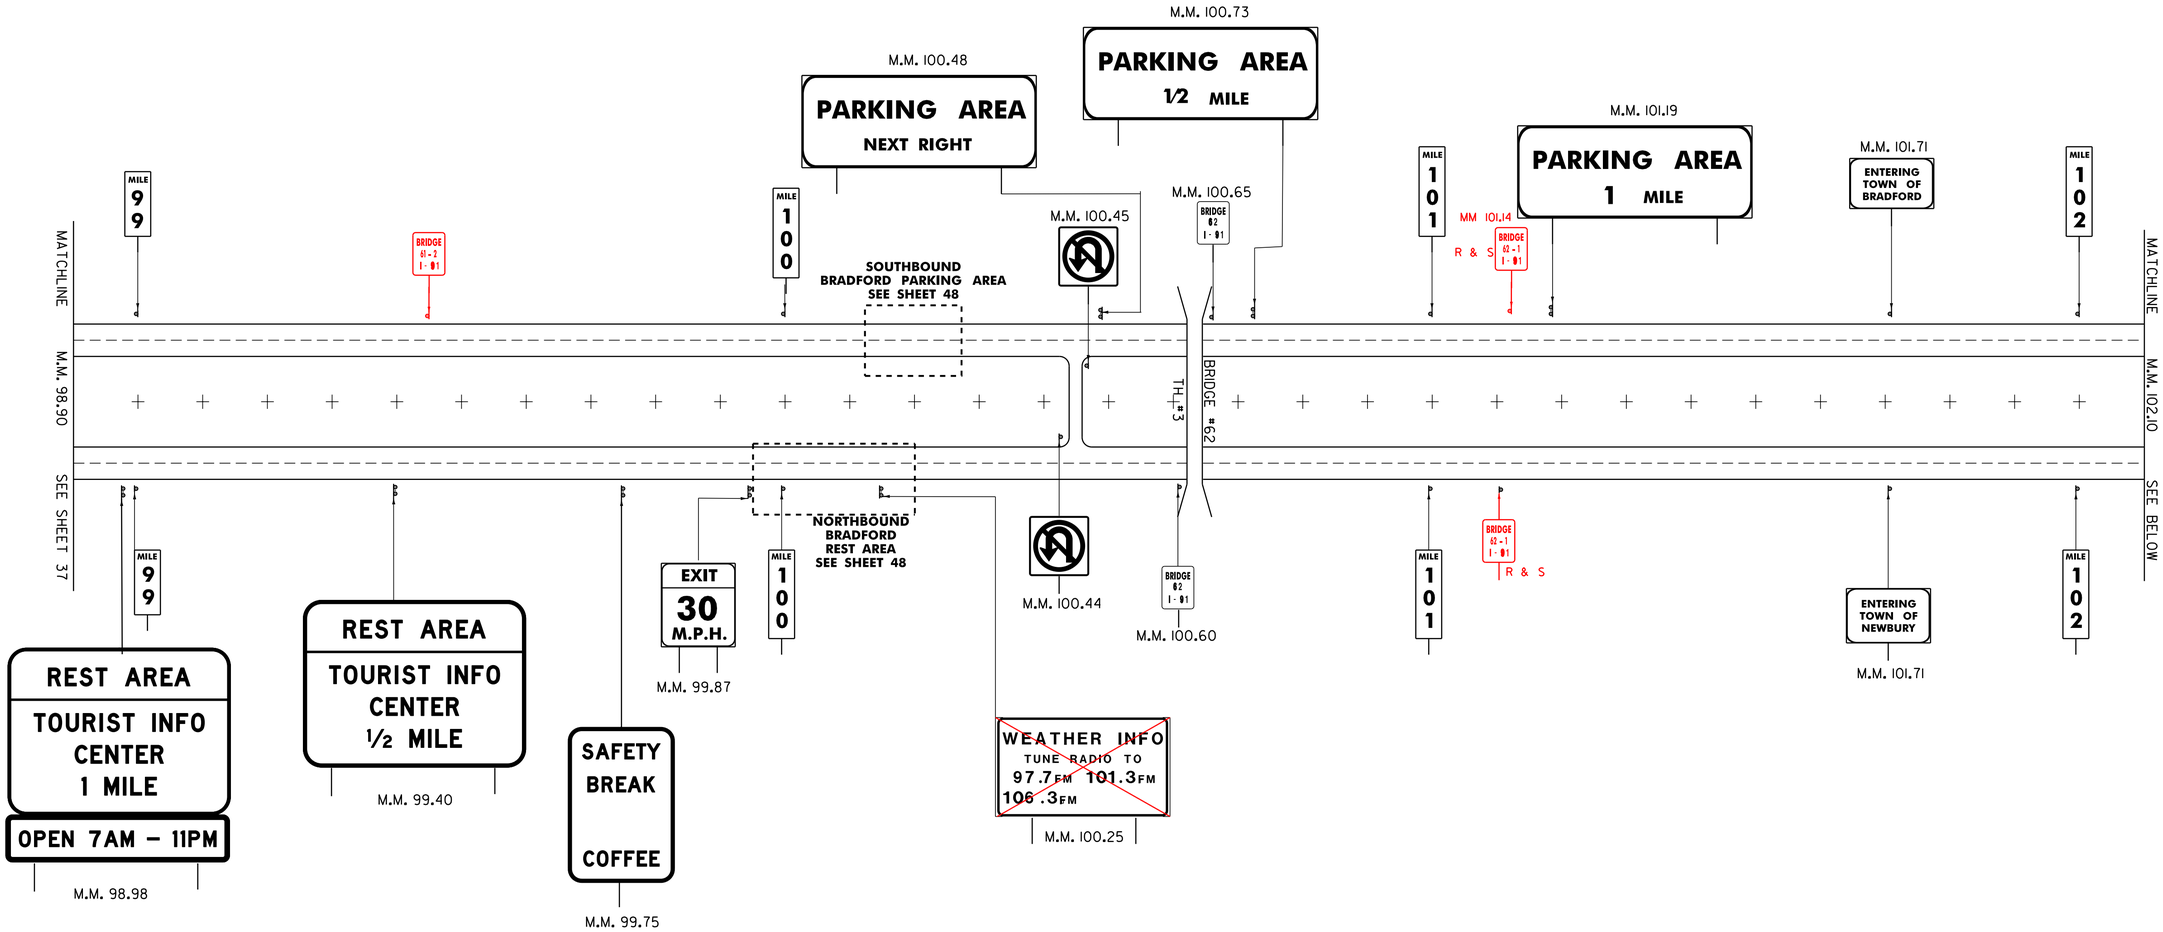

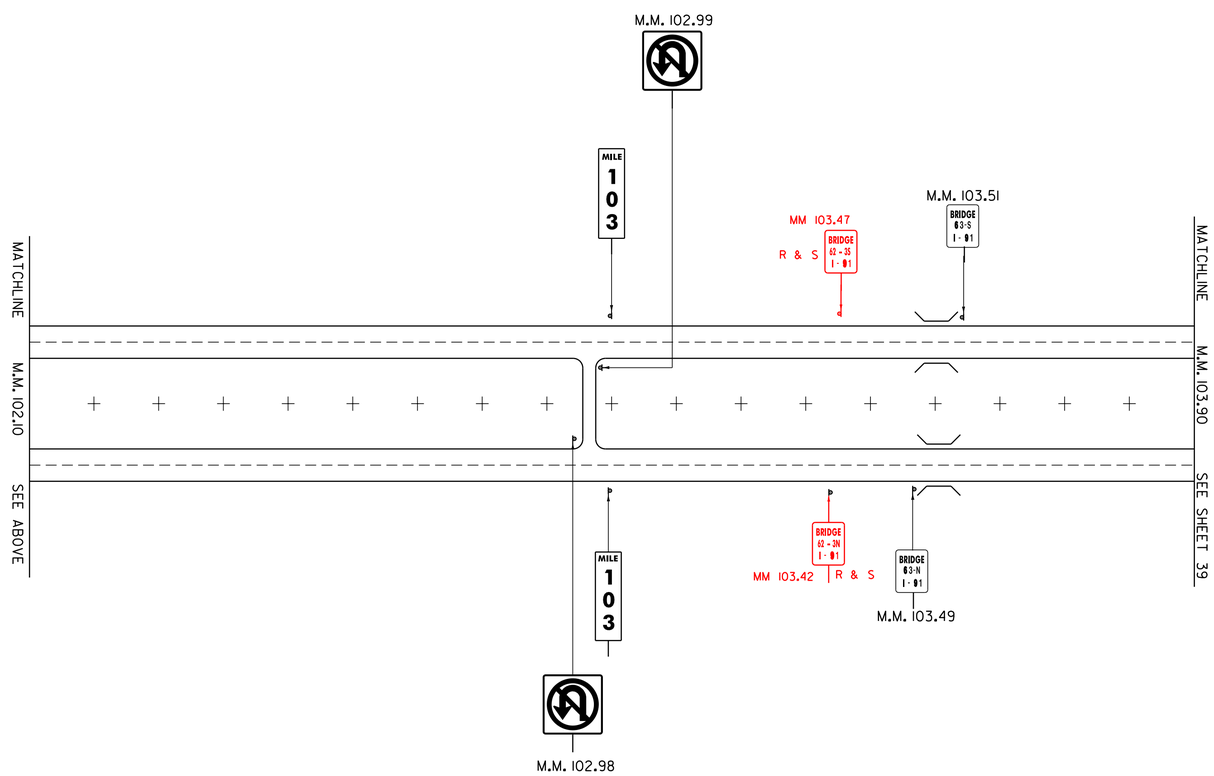

PROPOSED MAINLINE SIGNS

DuBois & King inc.
engineering planning management development

PROJECT NAME : HARTFORD – NEWBURY	PROJECT NO. : IM 091 -2 (69)
DESIGN FILE NAME: M:\PROJECTS\99A046\CONSTRUCTION\99A046.DGN	
IPARM FILE NAME:	PLOT DATE: 05-JUN-2013 16:
SURVEYED BY: NAS, RAN	SURVEY DATE: FEB 1998
SQUAD LEADER: J. W. TUCKER	DRAWN BY: S. J. BIJOLLE
	SHEET: 38 OF 180