STATE OF VERMONT
AGENCY OF TRANSPORTATION

TRAFFIC SIGN SUMMARY SHEET

VAOT Metric

MILE MARKER, STATION, OR SIGN NUMBER	SIGN LEGEND	SIGN DIMENSIONS EA	SIGN DIMENSIONS WIDTH (mm)	SIGN DIMENSIONS HEIGHT (mm)	NEW & SALVAGED SIGNS "A"	NEW & SALVAGED SIGNS "B"	SALV SIGN	SALV TIS	EXIST POST RETAIN	EXIST POST SALVAGE	NO. OF POSTS	NEW SIGN POSTS: FLANGED CHANNEL kg/m 1.7	FLANGED CHANNEL kg/m 3.0	FLANGED CHANNEL kg/m 4.5	SQUARE STEEL (mm) 44 kg/m 3.4	SQUARE STEEL 50 kg/m 3.9	SQUARE STEEL 63 kg/m 5.0	ANCHOR	SLEEVE	TUBULAR ALUMINUM Ø (mm) 75 kg/m 1.9	TUBULAR ALUMINUM 100 kg/m 2.5	TUBULAR ALUMINUM 100 MOD kg/m 2.5	FOUNDATION	TUBULAR STEEL Ø (mm) 75 kg/m 11.3	TUBULAR STEEL 89 kg/m 13.4	TUBULAR STEEL 100 kg/m 16.1	TUBULAR STEEL 125 kg/m 21.7	W-SHAPE STEEL FTG. SIZE 600 mm	W-SHAPE STEEL FTG. SIZE 750 mm	W-SHAPE STEEL WEIGHT	W-SHAPE STEEL POST SIZE	SIGN FRAME REQUIRED	REMARKS	SIGN DETAIL: DETAIL ON SHEET NUMBER	SIGN DETAIL: STD. SHEET NUMBER
												OPTION ITEMS																							
INT. #13 VT. RT. 10A MM. 0.261		1	600	750	0.45																												R4-7		E-144
	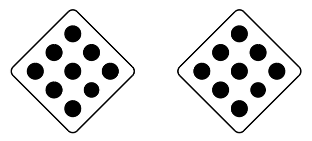	2	450	450	0.41						1			X																			OM1-1		E-150
INT. #13 VT. RT. 10A M.M. 0.244 RT		1	600	300	0.18																												W3-3 M3-3		E-136B
		1	600	600	0.36						1			X																					E-136B
INT. #13 VT. RT. 10A MM. 0.238		1	600	750	0.45																												R4-7		E-144
	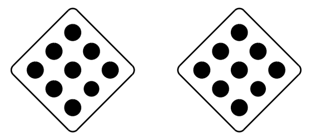	2	450	450	0.41						1			X																			OM1-1		E-150
INT. #13 VT. RT. 10A M.M. 0.210 LT		1 1 1	600 600 600	300 300 300	0.18 0.18 0.18																												M3-4 M3-3 M3-1		E-136B E-135 E-135
		1 1 1	600 600 600	600 600 600	0.36 0.36 0.36																												 M1-1 M1-1		E-136B E-135 E-135
	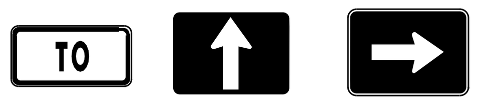	1 1 1	600 525 525	300 375 375	0.18 0.20 0.20																												M4-5 M6-3 M6-1		E-136B E-135 E-135
		1	600	600	0.36																												M1-4		E-136A
	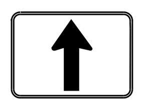	1	525	375	0.20						2												2	X								X	M6-3 E-123		E-136A
INT. #13 VT. RT. 10A MM. ~~0.210~~ 0.219	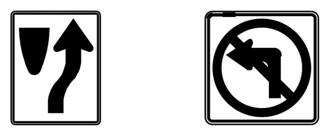	1 1	600 600	750 600	0.45 0.36																												R4-7 R3-2		E-144 E-143
	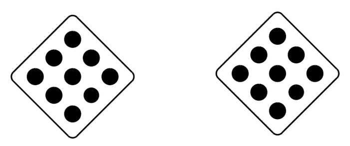	2	450	450	0.41						1			X																			OM1-1		E-150
INT. #13 VT. RT. 10A MM. 0.205 RT		1	750	750	0.56						1			X																			R3-2		E-143
INT. #13 VT. RT. 10A MM 0.205		1	600	750	0.45																												R4-7		E-144
	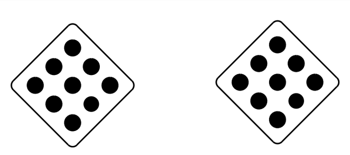	2	450	450	0.41						1			X																			OM1-1		E-150
												m	m	m 24	m	m	m		EA	kg	kg	kg		kg 113	kg	kg	kg								
TOTALS					m² 7.66	m²	EA.	m²				m 24			m					kg			EA. 2	kg 113				EA.	EA.	kg					

FINAL POST LENGTHS ARE TO BE DETERMINED IN THE FIELD. POST SIZES ARE COMPUTED BASED ON INFORMATION FURNISHED ON THE STANDARD SHEETS AND THE TRAFFIC & SAFETY DIVISION'S "SIGN POST DESIGN GUIDELINE."

PROJECT NAME: HARTFORD-NEWBURY
PROJECT NUMBER: IM 091-2(69)

FILE NAME: M:\Projects\99a046\Construct ... 137a.dgn PLOT DATE: 05-JUN-2013 16:0
PROJECT LEADER: J. W TUCKER
DESIGNED BY:
DRAWN BY: S. J BIJOLLE
CHECKED BY: J.D. AUSTIN
SHEET 137 OF 180