STATE OF VERMONT
AGENCY OF TRANSPORTATION

TRAFFIC SIGN SUMMARY SHEET

Metric

MILE MARKER, STATION, OR SIGN NUMBER	SIGN LEGEND	SIGN DIMENSIONS EA	SIGN DIMENSIONS WIDTH (mm)	SIGN DIMENSIONS HEIGHT (mm)	NEW & SALVAGED SIGNS "A"	"B"	SALV SIGN	SALV TIS	EXIST POST RETAIN	EXIST POST SALVAGE	NO. OF POSTS	NEW SIGN POSTS: FLANGED CHANNEL kg/m 1.7 (OPTION ITEMS)	FLANGED CHANNEL 3.0	FLANGED CHANNEL 4.5	SQUARE STEEL (mm) 44 kg/m 3.4	SQUARE STEEL 50 kg/m 3.9	SQUARE STEEL 63 kg/m 5.0	ANCHOR	SLEEVE	TUBULAR ALUMINUM Ø (mm) 75 kg/m 1.9	TUBULAR ALUMINUM 100 kg/m 2.5	TUBULAR ALUMINUM 100 MOD kg/m 2.5	FOUNDATION	TUBULAR STEEL Ø (mm) 75 kg/m 11.3	TUBULAR STEEL 89 kg/m 13.4	TUBULAR STEEL 100 kg/m 16.1	TUBULAR STEEL 125 kg/m 21.7	W-SHAPE STEEL FTG. SIZE 600 mm	W-SHAPE STEEL FTG. SIZE 750 mm	W-SHAPE STEEL WEIGHT	W-SHAPE STEEL POST SIZE	SIGN FRAME REQUIRED	REMARKS	SIGN DETAIL: DETAIL ON SHEET NUMBER	SIGN DETAIL: STD. SHEET NUMBER
INT. #14 RAMP A STA. 0+030 RT		1	900	900	0.81																												VR-046		E-142
		1	900	900	0.81						2			X																			VR-002		E-142
INT. #14 RAMP A STA. 0+422 RT		1	750	750	0.56						1			X																			R3-2		E-143
INT. #14 RAMP A STA. 0+438 LT		1	900	300	0.27						2		X																				R6-1L		E-142
INT. #14 SOUTHBOUND MM. 84.04	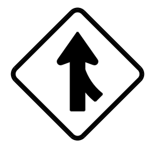	1	1200	1200	1.44						2			X																			W4-1R		E-150
INT. #14 RAMP B MM. 84.02	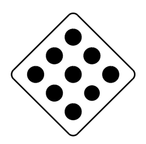	1	450	450	0.20						1	X																					OM1-1		E-150
INT. #14 RAMP B MM. 84.02		1	1800	1500		2.70					2												2	X											E-131
NB 83.90 RAMP B		1	1200	1500	1.80						2												2	X									W13-2		E-150
INT. #14 RAMP B STA. 0+120 RT	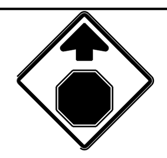	1	900	900	0.81						2			X																			W3-1A		E-150
INT. #14 RAMP B STA. 0+180 RT		1 1 1	600 600 600	300 300 300	0.18 0.18 0.18																												M3-4 M3-2 M4-5		E-136B E-136B E-136A
	ONE SIGN MISSING	1 1 1	750 750 600	600 600 600	0.45 0.45 0.36																												 M1-4		E-136B E-136B E-136A
	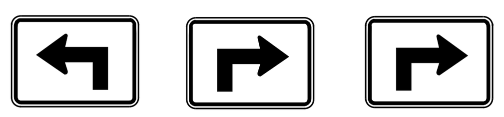	1 1 1	525 525 525	375 375 375	0.20 0.20 0.20						2												2	X								X	M5-1L M5-1R M5-1R		E-136B E-136B E-136A
INT. #14 RAMP B STA. 0+300 LT		1	900	600	0.54																												R5-1A		E-143
		1	600	600	0.36						1			X																			R9-4A		E-143

	"A"	"B"	SALV SIGN	SALV TIS	FLANGED CHANNEL 1.7	3.0	4.5	SQUARE STEEL 44	50	63	ANCHOR	SLEEVE	TUB. ALUM. 75	100	100 MOD	FOUNDATION	TUB. STEEL 75	89	100	125	FTG. 600	FTG. 750	WEIGHT
Subtotals					m 2	m 8.0	m 34	m	m	m		EA	kg	kg	kg		kg 180.8	kg	kg	kg			
TOTALS	m² 8.2	m² 2.7	EA.	m²	m 44.0			m					kg			EA. 4	kg 180.8				EA.	EA.	kg

FINAL POST LENGTHS ARE TO BE DETERMINED IN THE FIELD. POST SIZES ARE COMPUTED BASED ON INFORMATION FURNISHED ON THE STANDARD SHEETS AND THE TRAFFIC & SAFETY DIVISION'S "SIGN POST DESIGN GUIDELINE."

PROJECT NAME: HARTFORD-NEWBURY
PROJECT NUMBER: IM 091-2(69)

FILE NAME: M:\Projects\99a046\Construct[...]13a152.dgn PLOT DATE: 05-JUN-2013 16:0[...]
PROJECT LEADER: J. W. TUCKER DRAWN BY: S. J. BIJOLLE
DESIGNED BY: CHECKED BY: J.D. AUSTIN
SHEET 142 OF 180