STATE OF VERMONT
AGENCY OF TRANSPORTATION

TRAFFIC SIGN SUMMARY SHEET

Metric

MILE MARKER, STATION, OR SIGN NUMBER	SIGN LEGEND	SIGN DIMENSIONS EA	SIGN DIMENSIONS WIDTH (mm)	SIGN DIMENSIONS HEIGHT (mm)	NEW & SALVAGED SIGNS "A"	NEW & SALVAGED SIGNS "B"	NEW & SALVAGED SIGNS SALV SIGN	NEW & SALVAGED SIGNS SALV TIS	EXIST POST RETAIN	EXIST POST SALVAGE	NO. OF POSTS	NEW SIGN POSTS: FLANGED CHANNEL kg/m 1.7	FLANGED CHANNEL kg/m 3.0	FLANGED CHANNEL kg/m 4.5	SQUARE STEEL (mm) 44 kg/m 3.4	SQUARE STEEL (mm) 50 kg/m 3.9	SQUARE STEEL (mm) 63 kg/m 5.0	ANCHOR	SLEEVE	TUBULAR ALUMINUM Ø (mm) 75 kg/m 1.9	TUBULAR ALUMINUM Ø (mm) 100 kg/m 2.5	TUBULAR ALUMINUM Ø (mm) 100 MOD kg/m 2.5	FOUND-ATION	TUBULAR STEEL Ø (mm) 75 kg/m 11.3	TUBULAR STEEL Ø (mm) 89 kg/m 13.4	TUBULAR STEEL Ø (mm) 100 kg/m 16.1	TUBULAR STEEL Ø (mm) 125 kg/m 21.7	W-SHAPE STEEL FTG. SIZE 600 mm	W-SHAPE STEEL FTG. SIZE 750 mm	W-SHAPE STEEL MASS KG	W-SHAPE STEEL POST SIZE	SIGN FRAMED	REMARKS	SIGN DETAIL: DETAIL ON SHEET NUMBER	SIGN DETAIL: STD. SHEET NUMBER
												OPTION ITEMS																							
INT #15		1	750	750	0.56						1			X																			R1-1		E-143
F. ST. HWY.		1	600	750	0.45																												R4-7		E-144
MM. 0.01																																			
		1	450	450	0.20						1	X																					OM1-1		E-150
INT #15		1	750	750	0.56						2			X																			R1-1		E-143
F. ST. HWY.																																			
MM. 0.01 LT																																			
INT #15		1	600	750	0.45																												R4-7		E-144
F. ST. HWY.																																			
MM. 0.02																																			
	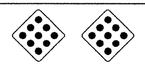	2	450	450	0.41						1			X																			OM1-1		E-150
INT #15	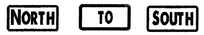	1	600	300	0.18																												M3-1		E-136A
F. ST. HWY.		1	600	300	0.18																												M4-5		E-136B
MM. 0.04 LT		1	600	300	0.18																												M3-3		E-136A
		1	600	600	0.36																												M1-4		E-136A
		1	600	600	0.36																														E-136B
		1	600	600	0.36																												M1-4		E-136A
		1	525	375	0.20																												M6-1		E-136A
		1	525	375	0.20						2												2	X								X	M6-1		E-136B
		1	525	375	0.20																												M6-1		E-136A
INT #15		1	900	750	0.68						2			X																			VR-943		E-145A
F. ST. HWY.																																			
MM. 0.05 LT																																			
INT #15		1	1800	250	0.45																														E-123
F. ST. HWY.																																			
MM. 0.06 LT																																			
	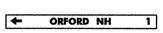	1	1800	300	0.54																														E-123
	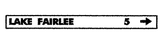	1	1800	300	0.54																														E-123
	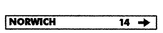	1	1800	300	0.54						2			X																					E-123
INT #15		1	900	900	0.81						2			X																			W3-1A		E-150
F. ST. HWY.																																			
MM. 0.07 LT																																			
												m 2.0	m	m 40.0	m	m	m		EA	kg	kg	kg		kg 90.4	kg	kg	kg								
TOTALS					m2 8.41	m2	EA.	m2				m 42.0			m					kg			EA. 2	kg 90.4				EA.	EA.	kg					

FINAL POST LENGTHS ARE TO BE DETERMINED IN THE FIELD. POST SIZES ARE COMPUTED BASED ON INFORMATION FURNISHED ON THE STANDARD SHEETS AND THE TRAFFIC & SAFETY DIVISION'S "SIGN POST DESIGN GUIDELINE."

PROJECT NAME:	HARTFORD-NEWBURY
PROJECT NUMBER:	IM 091-2(69)
FILE NAME:	...\za046TS06.dgn
PROJECT LEADER:	J. W TUCKER
DESIGNED BY:	
PLOT DATE:	01/18/2006
DRAWN BY:	S. J BIJOLLE
CHECKED BY:	J.D. AUSTIN
SHEET	153 OF 180

...\GRAN\g046\S06.dgn 01/18/2006 11:11:09 AM